

ADDENDA

ADDENDUM NUMBER 01

DATE: NOVEMBER 9, 2023

PROJECT: OWASA ADMINISTRATIVE BUILDING COPING AND EIFS IMPROVEMENTS

OWASA CIP NUMBER: 280-17

OWNER: ORANGE WATER AND SEWER AUTHORITY

ARCHITECT: THOUGHTCRAFT ARCHITECTS

TO: ALL BIDDERS

This Addendum forms a part of the Contract Documents and modifies the Bidding Documents dated October 27, 2023, Addendum Number 01 issued November 9, 2023, with amendments and additions noted herein below.

Acknowledge receipt of this Addendum in the space provided in the Bid form. Failure to do so may disqualify the Bidder.

This Addendum consists of 29 pages:

CHANGES TO THE SPECIFICATIONS: NONE

CHANGES TO THE DRAWINGS:

1. Complete drawings bid set is reissued with this Addendum No. 1 that replaces in full the previously issued drawings bid set.

OTHER DOCUMENTS:

1. Agenda and Sign-In sheet from mandatory Pre-Bid meeting held on November 8, 2023.

BIDDER QUESTIONS:

1. Question: When will be the project start date?
Response: *Plan to open cavities in soffits and interior locations as soon as possible following construction contract execution. Contractor and OWASA will coordinate on Notice To Proceed date. Note that all work to be completed by June 30, 2024.*
2. Question: Are there restricted hours?
Response: *No Holidays and no weekends unless approved beforehand. See bid documents for specific requirements.*
3. Question: Will there be any interior storage available on site?
Response: *No.*
4. Question: Can we make additional site visits?
Response: *Yes, contact Brad Barber to coordinate site visits.*
5. Question: Is the Metal Coping intended to be Aluminum or Steel?
Response: *Aluminum as indicated in the Finish Legend (A1.3) and details (A4.1). The revised drawings bid set issued with Addendum No. 1 contains added notations to address the thickness of the aluminum in MM.*
6. Question: What are the dimensions of the metal coping cap?
Response: *The Architect's drawings are based off the original construction drawings. Select sheets from the original construction drawings are provided FOR REFERENCE ONLY with Addendum No. 1. Contractor responsible for field verifying all dimensions.*
7. Question: Does the base bid include any unknown work once the cavities are opened up?
Response: *Further notations have been added to General Note 1 indicating the Contractor is to issue a change order for unforeseen work in enclosed cavities. See revised drawings bid set issued with Addendum No. 1.*
8. Question: Will there be a need to bore under the existing sidewalk to drain to daylight the 4" perforated in gravel trench as indicated on the image A/4.2?
Response: *Yes, further notations have been made on the Site Plan (A0.2) and image on A4.2. See revised drawings bid set issued with Addendum No. 1.*
9. Question: Can we just remove the parge coat within the planters and install the fluid applied membrane over top of the concrete?
Response: *Yes, drawings have been modified to call for removal of all parge coat within planters and the Contractor is to ensure proper adhesion of the fluid applied membrane to the concrete.*

10. Question: Where will the laydown area be located?

Response: *The awarded Contractor will coordinate with OWASA to identify laydown and parking space.*


11. Question: Will a building permit be required?

Response: *No, OWASA understanding is the work is maintenance and repair.*

REMAINDER OF THIS PAGE INTENTIONALLY LEFT BLANK

OWASA ADMINISTRATIVE BUILDING COPING AND EIFS IMPROVEMENTS

400 JONES FERRY ROAD | CARRBORO, NC | 27510 | ADDENDUM 01 | NOVEMBER 09, 2023

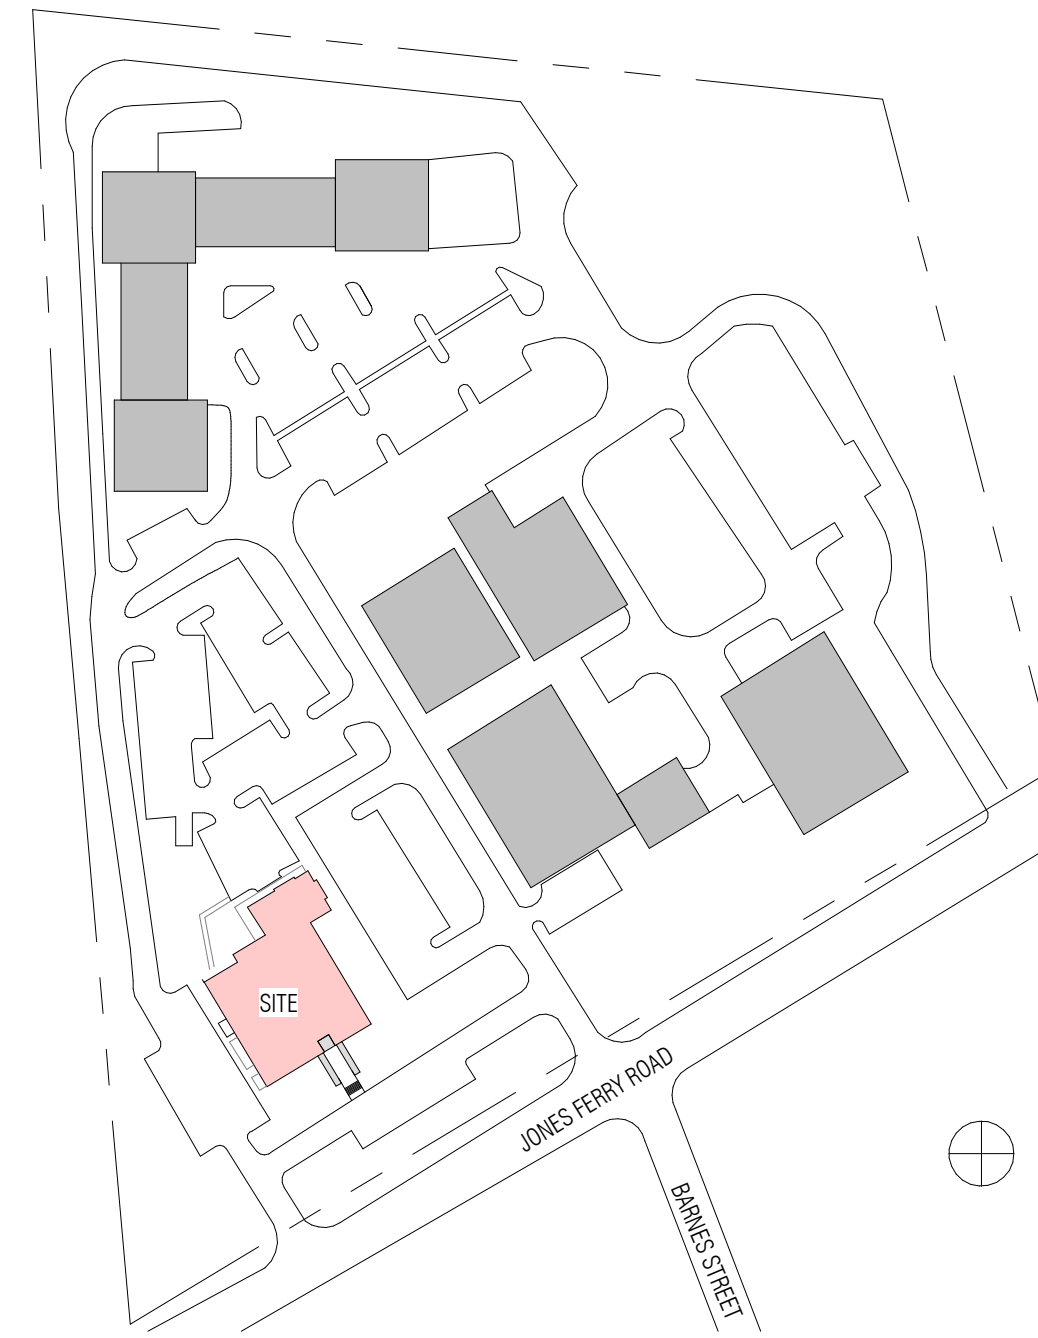

SHEET LIST	
SHEET NUMBER	SHEET NAME
A-0.1	CODE SUMMARY
A-0.2	SITE PLAN
A-1.1	ROOF PLAN
A-3.1	EXTERIOR ELEVATIONS
A-3.2	EXTERIOR ELEVATIONS
A-4.1	WALL SECTIONS
A-4.2	WALL SECTIONS
A-6.1	PLANTER DETAILS

A/C	Air Conditioning	EOS	Edge of slab	MACH	Machine	SF	Square Foot (Feet)
ACP	Acoustic Ceiling Panel	EQ	Equal	MAINT	Maintenance	SHR	Shower
ACT	Acoustic Ceiling Tile	EQUIP	Equipment	MATL	Material	SHT	Sheet
ACST	Acoustic	ESCAL	Escalator	MAX	Maximum	SHTHG	Sheathing
AHU	Air Handling Unit	EV	Electric Vehicle	MASRY	Masonry	SHV	Shelving
AD	Area Drain	EXH	Exhaust	MC	Medicine Cabinet	SIM	Similar
ADU	Adjust (able) (ing)	EXST	Existing	MDF	Medium Density Fiberboard	SLNT	Sealant
AFF	Above Finished Floor	EXT	Exterior	MDO	Medium Density Overlay	SNDV(R)	Sanitary Napkin Dispenser (Receptacle)
ALT	Alternate	FA	Fire Alarm	MECH	Mechanical	SP	Space(s)
ALUM	Aluminum	FAAP	Fire Alarm Annunciator Panel	MEMB	Membrane	SPEC	Specification
ANOD	Anodized	FAAP	Fire Alarm Annunciator Panel	MFR	Manufacture(r)	SPKR	Speaker
AP	Access Panel	FACP	Fire Alarm Control Panel	MH	Manhole	SQ	Square
APPROX	Approximate	FCM	Fiber Cement	MIN	Minimum	SS	Solid Surface
ARCH(L)	Architect (Lural)	FD	Floor Drain	MIRR	Mirror	STD	Standard
AUTO	Automatic	FE(C)	Fire Extinguisher (Cabinet)	MISC	Miscellaneous	STND	Standard
AWP	Acoustical Wall Panel	FF	Finished Floor (Face)	MO	Masonry Opening	STL	Steel
		FFC	Fire Hose Cabinet	MS	Mechostade	STND	Stained
		FIN	Finished	MTD	Mount(ed)	STOR	Storage
		FLR(G)	Floor(ing)	MTL	Metal	STRUCT	Structural
		FNDN	Foundation	N	North	SUSP	Suspended
		FO	Face of, Finished Opening	NAT	Natural	SV	Sheet Vinyl
		FR	Fire Resistant	NIC	Not in Contract	SVS	System
		FRP	Fiber Resistant Panel	NOM	Nominal	T&G	Tongue and Groove
		FT	Foot	NTS	Not to Scale	TB	Towel Bar
		FTG	Footing	OA	Overall	TO	Top of
		FUT	Future	OC	On Center	TOC	Top of Concrete
				OD	Outside Diameter	TOD	Top of Deck
				OF/CI	Owner Furnished/Contractor Installed	TOS	Top of Steel
				OPNG	Opening	TOW	Top of Wall
				OPND	Opposite Hand	TPD	Toilet Paper Dispenser
				OPP	Opposite	TS	Transition Strip
						UC	Undercut
						UTIL	Utility
						VB	Vinyl Base
						VC	Vinyl Composition Tile
						VERT	Vertical
						VEST	Vestibule
						VIF	Verily in Field
						W	West
						WB	Wood Base
						WC	Wall Covering
						WD	Wood
						WP	Working Point
						WPG	Waterproofing
						WPS	Wall Protection System
						WT	Window Treatment
						WWF	Weilded Wire Fabric
						YD	Yard

OWNER / CLIENT
OWASA
 400 JONES FERRY ROAD
 CARRBORO, NC 27510
 919.537.4343
 c: Brad Barber
 e: bbarber@owasa.org

ARCHITECT
ThoughtCraft Architects, PLLC
 331 W. MAIN STREET
 DURHAM, NC 27701
 919.371.0721
 c: JASON PATTERSON, R.A.
 e: JP@thoughtcraftarchitects.com

PROJECT DATA:
 PARCEL NUMBER: 9778662060
 LEGAL DESCRIPTION: N/S JONES FERRY ROAD

APPLICABLE CODES:
 2018 NC EXISTING BUILDING CODE

1. SCOPE OF WORK
 THIS IS SOLELY AN EXTERIOR RENOVATION PROJECT AND ENTAILS REMOVAL OF THE ROOF COPING FROM THE TERMINATION BAR OVER THE PARAPET, REPAIR AND RECOATING THE ENTIRETY OF EIFS ON THE OWASA ADMINISTRATIVE BUILDING, REMOVAL OF AN EXISTING AWNING IN THE REAR OF THE BUILDING AND REPLACEMENT WITH NEW TO MATCH EXISTING GREEN CANOPIES ON THE BUILDING, REMOVAL OF PLANTS AND SOIL IN PLANTERS ON ENTRY BRIDGE, AND CAP WITH PRECAST PANELS. THERE IS NO INTERIOR WORK, NO ELECTRICAL WORK, NO PLUMBING WORK, NO WINDOW WORK, AND NO ROOF MEMBRANE WORK.

GENERAL NOTES

- ALL WORK SHALL COMPLY WITH APPLICABLE CODES INCLUDING, BUT NOT LIMITED TO THE 2018 NC EXISTING BUILDING CODE.
- DO NOT SCALE DRAWINGS. NOTIFY DESIGNER IMMEDIATELY OF ANY DISCREPANCIES.
- THESE CONSTRUCTION DOCUMENTS ARE DIVIDED INTO SECTIONS FOR CONVENIENCE ONLY. CONTRACTORS, SUBS AND MATERIAL SUPPLIERS SHALL REFER TO ALL RELEVANT SECTIONS IN BIDDING AND PERFORMING THEIR WORK, AND SHALL BE RESPONSIBLE FOR ALL ASPECTS OF THE WORK REGARDLESS OF WHERE THE INFORMATION OCCURS.
- THE GENERAL CONTRACTOR AND SUBCONTRACTORS SHALL VISIT THE SITE TO VERIFY ALL DIMENSIONS, ELEVATIONS AND SITE CONDITIONS PRIOR TO STARTING CONSTRUCTION.
- THE CONTRACTOR SHALL BE RESPONSIBLE FOR THE RESULTS OF ANY ERRORS, DISCREPANCIES OR OMISSIONS WHICH THE CONTRACTOR FAILED TO NOTIFY THE DESIGNER OF BEFORE CONSTRUCTION AND/OR FABRICATION OF THE WORK.
- ALL DIMENSIONS SHALL TAKE PRECEDENCE OVER SCALE SHOWN ON PLANS, SECTIONS AND DETAILS. DIMENSIONS ARE TO FACE OF STUD OR CONCRETE UNLESS NOTED OTHERWISE ON DRAWINGS.
- THE CONTRACTOR SHALL BE RESPONSIBLE FOR ALL MEANS AND METHODS OF THE WORK AND SITE SAFETY.
- THE CONTRACTOR SHALL COORDINATE WITH OWASA FOR PARKING AND MATERIAL STORAGE LOCATIONS.
- G.C. TO PROVIDE A WORKPLAN TO ENSURE BUILDING ACCESS AND EGRESS AT ALL ENTRY AND EXIT LOCATIONS OF THE BUILDING DURING CONSTRUCTION. SEE PROJECT MANUAL FOR COORDINATION WITH OWNER'S OPERATIONS.
- G.C. TO PROVIDE NECESSARY EXTERIOR PROTECTION OF BUILDING ENVELOPE DURING CONSTRUCTION IN THE CASE OF INCLIMATE WEATHER.
- G.C. SHALL SPOT INVESTIGATE ENCLOSED CAVITIES FROM THE INTERIOR ABOVE THE CEILING AND SOFFIT BELOW AT EACH WALL WITH ENCLOSED SOFFITS. UPON EXAMINATION IF THERE IS ANY MOLD OR MILDEW FOUND NOTIFY OWNER AND ARCHITECT IMMEDIATELY AND RE-SEAL THE OPENING TO ENSURE NO NEGATIVE EFFECTS OF INDOOR AIR QUALITY INFILTRATE THE BUILDING.

2018 APPENDIX B BUILDING CODE SUMMARY FOR ALL COMMERCIAL PROJECTS (EXCEPT 1 AND 2-FAMILY DWELLINGS AND TOWNHOUSES)

Name of Project: OWASA EIFS REPAIR
Address: 400 JONES FERRY ROAD
Owner/Authorized Agent: OWASA
Phone #: (919) 537-4343
E-Mail: bbarber@owasa.org
Owned By: [X] City/County [] Private [] State
Code Enforcement Jurisdiction: [] City [X] County ORANGE [] State

CONTACT: DESIGNER FIRM NAME LICENSE # TELEPHONE # E-MAIL
Architectural THOUGHTCRAFT ARCHITECTS, PLLC JASON HART 12321 (919) 371.0721 jw@thoughtcraftarchitects.com
Civil
Electrical
Fire Alarm
Fire Alarm
Plumbing
Mechanical
Sprinkler-Standpipe
Structural
Retaining Walls >5' High
Other

2018 NC BUILDING CODE: [] New Building [] Addition [] Renovation
[] 1st Time Interior Completion
[] Shell/Core - Contact the local inspection jurisdiction for possible additional procedures and requirements
[] Phased Construction - Shell/Core-Contact the local inspection jurisdiction for possible additional procedures and requirements

2018 NC EXISTING BUILDING CODE: EXISTING: [] Prescriptive [X] Repair [] Chapter 14
Alteration: [] Level I [] Level II [] Level III
[] Historic Property
[] Change of Use
CONSTRUCTED: (date) 1990 CURRENT OCCUPANCY(S) (Ch. 3): BUSINESS
RENOVATED: (date) 2003 - WAREHOUSE PROPOSED OCCUPANCY(S) (Ch. 3): BUSINESS
OCCUPANCY CATEGORY (Table 1604.5): Current: [] I [X] II [] III [] IV
Proposed: [] I [X] II [] III [] IV

BASIC BUILDING DATA
Construction Type: [] I-A [] II-A [] III-A [] IV [] V-A
[] I-B [] II-B [] III-B [X] V-B
Sprinklers: [] No [] Partial [X] Yes [X] NFPA 13 [] NFPA 13R [] NFPA 13D
Standpipes: [X] No [] Yes Class [] I [] II [] III [] Wet [] Dry
Fire District: [] No [X] Yes Flood Hazard Area: [] No [] Yes
Special Inspections Required: [X] No [] Yes (Contact the local inspection jurisdiction for additional procedures and requirements.)

2018 NC Administrative Code and Policies

Gross Building Area Table
FLOOR EXISTING (SQ FT) NEW (SQ FT) SUB-TOTAL
3rd Floor N/A
2nd Floor -13,930 SF
Mezzanine N/A
1st Floor -10,119 SF
Basement
TOTAL -24,049 SF NO NEW GSF, EXISTING TO REMAIN

ALLOWABLE AREA N/A
Primary Occupancy Classification(s): Select one Select one Select one Select one Select one
Assembly [] A-1 [] A-2 [] A-3 [] A-4 [] A-5
Business
Educational
Factory [] F-1 Moderate [] F-2 Low
Hazardous [] H-1 Detonate [] H-2 Deflagrate [] H-3 Combust [] H-4 Health [] H-5 HPM
Institutional [] I-1 Condition [] I-2
[] I-2 Condition [] I-2
[] I-3 Condition [] I-2 [] 3 [] 4 [] 5
[] I-4
Mercantile
Residential [] R-1 [] R-2 [] R-3 [] R-4
Storage [] S-1 Moderate [] S-2 Low [] High-piled
[] Parking Garage [] Open [] Enclosed [] Repair Garage
Utility and Miscellaneous

Accessory Occupancy Classification(s):
Incidental Uses (Table 509):
Special Uses (Chapter 4 - List Code Sections):
Special Provisions: (Chapter 5 - List Code Sections):
Mixed Occupancy: [] No [] Yes Separation: ___ Hr. Exception:
[] Non-Separated Use (508.3) - The required type of construction for the building shall be determined by applying the height and area limitations for each of the applicable occupancies to the entire building. The most restrictive type of construction, so determined, shall apply to the entire building.
[] Separated Use (508.4) - See below for area calculations for each story, the area of the occupancy shall be such that the sum of the ratios of the actual floor area of each use divided by the allowable floor area for each use shall not exceed 1.
Actual Area of Occupancy A + Actual Area of Occupancy B
Allowable Area of Occupancy A Allowable Area of Occupancy B
_____ + _____ = _____ <= 1.00

2018 NC Administrative Code and Policies

Table with 5 columns: STORY NO., DESCRIPTION AND USE, (A) BLDG AREA PER STORY (ACTUAL), (B) TABLE 506.2 AREA, (C) AREA FOR FRONTAGE INCREASES, (D) ALLOWABLE AREA PER STORY OR UNLIMITED

- 1 Frontage area increases from Section 506.2 are computed thus:
a. Perimeter which fronts a public way or open space having 20 feet minimum width = ___ (F)
b. Total Building Perimeter = ___ (P)
c. Ratio (F/P) = ___ (F/P)
d. W = Minimum width of public way = ___ (W)
e. Percent of frontage increase I_f = 100[F/P - 0.25] x W/30 = ___ (%)

- 2 Unlimited area applicable under conditions of Section 507.
3 Maximum Building Area = total number of stories in the building x D (maximum3 stories) (506.2).
4 The maximum area of open parking garages must comply with Table 406.5.4. The maximum area of air traffic control towers must comply with Table 412.3.1.
5 Frontage increase is based on the unsprinklered area value in Table 506.2.

ALLOWABLE HEIGHT N/A
Table with 3 columns: ALLOWABLE, SHOWN ON PLANS, CODE REFERENCE
Building Height in Feet (Table 504.3)
Building Height in Stories (Table 504.4)

1 Provide code reference if the "Shown on Plans" quantity is not based on Table 504.3 or 504.4.

FIRE PROTECTION REQUIREMENTS

Table with 7 columns: BUILDING ELEMENT, FIRE SEPARATION DISTANCE (FEET), RATING REQ'D, RATING PROVIDED (W/ REDUCTION), DETAIL # AND SHEET #, DESIGN # FOR RATED ASSEMBLY, SHEET # FOR RATED PENETRATION, SHEET # FOR RATED JOINTS
Structural Frame, including columns, girders, trusses
Bearing Walls
Exterior
North
East
West
South
Interior
Nonbearing Walls and Partitions
Exterior walls
North
East
West
South
Interior walls and partitions
Floor Construction
Including supporting beams and joists
Floor Ceiling Assembly
Columns Supporting Floors
Roof Construction, including supporting beams and joists
Roof Ceiling Assembly
Columns Supporting Roof
Shaft Enclosures - Exit
Shaft Enclosures - Other
Corridor Separation
Occupancy/Fire Barrier Separation
Party/Fire Wall Separation
Smoke Barrier Separation
Smoke Partition
Tenant Dwelling Unit/ Sleeping Unit Separation
Incidental Use Separation

* Indicate section number permitting reduction

PERCENTAGE OF WALL OPENING CALCULATIONS N/A
Table with 4 columns: FIRE SEPARATION DISTANCE (FEET) FROM PROPERTY LINES, DEGREE OF OPENINGS PROTECTION (TABLE 705.8), ALLOWABLE AREA (%), ACTUAL SHOWN ON PLANS (%)

LIFE SAFETY SYSTEM REQUIREMENTS

Emergency Lighting: [] No [X] Yes
Exit Signs: [] No [X] Yes
Fire Alarm: [] No [X] Yes
Smoke Detection Systems: [] No [X] Yes [] Partial
Panic Hardware: [X] No [] Yes

LIFE SAFETY PLAN REQUIREMENTS

- Life Safety Plan Sheet #:
[] Fire and/or smoke rated wall locations (Chapter 7)
[] Assumed and real property line locations (if not on the site plan)
[] Exterior wall opening area with respect to distance to assumed property lines (705.8)
[] Occupancy Use for each area as it relates to occupancy load calculation (Table 1004.1.2)
[] Occupant loads for each area
[] Exit access travel distances (1017)
[] Common path of travel distances (Tables 1006.2.1 & 1006.3.2(1))
[] Dead end lengths (1020.4)
[] Clear exit widths for each exit door
[] Maximum calculated occupant load capacity each exit door can accommodate based on egress width (1005.3)
[] Actual occupant load for each exit door
[] A separate schematic plan indicating where fire rated floor/ceiling and/or roof structure is provided for purposes of occupancy separation
[] Location of doors with panic hardware (1010.1.10)
[] Location of doors with delayed egress locks and the amount of delay (1010.1.9.7)
[] Location of doors with electromagnetic egress locks (1010.1.9.9)
[] Location of doors equipped with hold-open devices
[] Location of emergency escape windows (1030)
[] The square footage of each fire area (202)
[] The square footage of each smoke compartment for Occupancy Classification I-2 (407.5)
[] Note any code exceptions or table notes that may have been utilized regarding the items above

ACCESSIBLE DWELLING UNITS (SECTION 1107) N/A
Table with 8 columns: TOTAL UNITS, ACCESSIBLE UNITS REQUIRED, ACCESSIBLE UNITS PROVIDED, TYPE A UNITS REQUIRED, TYPE A UNITS PROVIDED, TYPE B UNITS REQUIRED, TYPE B UNITS PROVIDED, TOTAL ACCESSIBLE UNITS PROVIDED

ACCESSIBLE PARKING (SECTION 1106) N/A
Table with 4 columns: LOT OR PARKING AREA, TOTAL # OF PARKING SPACES REQUIRED, # OF ACCESSIBLE SPACES PROVIDED, TOTAL # ACCESSIBLE PROVIDED
OF ACCESSIBLE SPACES PROVIDED: REGULAR WITH 5' ACCESS AISLE, VAN SPACES WITH 132" ACCESS AISLE, 8' ACCESS AISLE

PLUMBING FIXTURE REQUIREMENTS (TABLE 2902.1) N/A
Table with 6 columns: USE, WATERCLOSETS, URINALS, LAVATORIES, SHOWERS, DRINKING FOUNTAINS
SPACE EXIST'G NEW REQ'D, MALE FEMALE UNISEX, MALE FEMALE UNISEX, /TUBS, REGULAR ACCESSIBLE

SPECIAL APPROVALS N/A

Special approval: (Local Jurisdiction, Department of Insurance, OSC, DPI, DHHS, etc., describe below)

ENERGY SUMMARY N/A, ALL WORK IS EXTERIOR FINISH ONLY.

ENERGY REQUIREMENTS:
The following data shall be considered minimum and any special attribute required to meet the energy code shall also be provided. Each Designer shall furnish the required portions of the project information for the plan data sheet. If performance method, state the annual energy cost for the standard reference design vs annual energy cost for the proposed design.

Existing building envelope complies with code: [] No [] Yes (The remainder of this section is not applicable)

Exempt Building: [] No [] Yes (Provide code or statutory reference):

Climate Zone: [] 3A [] 4A [] 5A
Method of Compliance: Energy Code [] Performance [] Prescriptive
ASHRAE 90.1 [] Performance [] Prescriptive
(If "Other" specify source here)

THERMAL ENVELOPE (Prescriptive method only)

Roof/ceiling Assembly (each assembly)
Description of assembly:
U-Value of total assembly:
R-Value of insulation:
Skylights in each assembly:
U-Value of skylight:
total square footage of skylights in each assembly:
Exterior Walls (each assembly)
Description of assembly:
U-Value of total assembly:
R-Value of insulation:
Openings (windows or doors with glazing)
U-Value of assembly:
Solar heat gain coefficient:
projection factor:
Door R-Values:

Walls below grade (each assembly)
Description of assembly:
U-Value of total assembly:
R-Value of insulation:
Floors over unconditioned space (each assembly)
Description of assembly:
U-Value of total assembly:
R-Value of insulation:
Floors slab on grade
Description of assembly:
U-Value of total assembly:
R-Value of insulation:
Horizontal/vertical requirement:
slab heated:

2018 NC Administrative Code and Policies

2018 APPENDIX B BUILDING CODE SUMMARY FOR ALL COMMERCIAL PROJECTS STRUCTURAL DESIGN (PROVIDE ON THE STRUCTURAL SHEETS IF APPLICABLE)

DESIGN LOADS:
Importance Factors: Snow (Is) Seismic (Ie)
Live Loads: Roof Mezzanine Floor
Ground Snow Load:
Wind Load: Basic Wind Speed Exposure Category

SEISMIC DESIGN CATEGORY: [] A [] B [] C [] D
Provide the following Seismic Design Parameters:
Risk Category (Table 1604.5) [] I [] II [] III [] IV
Spectral Response Acceleration Ss %g S1 %g S2 %g
Site Classification (ASCE 7) [] A [] B [] C [] D [] E [] F
Data Source: [] Field Test [] Presumptive [] Historical Data
Basic structural system [] Bearing Wall [] Dual w/Special Moment Frame [] Building Frame [] Dual w/Intermediate R/C or Special Steel [] Moment Frame [] Inverted Pendulum
Analysis Procedure: [] Simplified [] Equivalent Lateral Force [] Dynamic
Architectural, Mechanical, Components anchored? [] Yes [] No

LATERAL DESIGN CONTROL: Earthquake [] Wind []
SOIL BEARING CAPACITIES:
Field Test (provide copy of test report) psf
Presumptive Bearing capacity psf
Pile size, type, and capacity

2018 APPENDIX B BUILDING CODE SUMMARY FOR ALL COMMERCIAL PROJECTS MECHANICAL DESIGN (PROVIDE ON THE MECHANICAL SHEETS IF APPLICABLE)

MECHANICAL SUMMARY
MECHANICAL SYSTEMS, SERVICE SYSTEMS AND EQUIPMENT
Thermal Zone
winter dry bulb:
summer dry bulb:
Interior design conditions
winter dry bulb:
summer dry bulb:
relative humidity:
Building heating load:
Building cooling load:
Mechanical Spacing Conditioning System
Unitary
description of unit:
heating efficiency:
cooling efficiency:
size category of unit:
Boiler
Size category. If oversized, state reason:
Chiller
Size category. If oversized, state reason:
List equipment efficiencies:

2018 APPENDIX B BUILDING CODE SUMMARY FOR ALL COMMERCIAL PROJECTS ELECTRICAL DESIGN (PROVIDE ON THE ELECTRICAL SHEETS IF APPLICABLE)

ELECTRICAL SUMMARY
ELECTRICAL SYSTEM AND EQUIPMENT
Method of Compliance: Energy Code [] Performance [] Prescriptive
ASHRAE 90.1 [] Performance [] Prescriptive
Lighting schedule (each fixture type)
lamp type required in fixture
number of lamps in fixture
ballast type used in the fixture
number of ballasts in fixture
total wattage per fixture
total interior wattage specified vs. allowed (whole building or space by space)
total exterior wattage specified vs. allowed
Additional Efficiency Package Options
(When using the 2018 NCECC; not required for ASHRAE 90.1)
[] C406.2 More Efficient HVAC Equipment Performance
[] C406.3 Reduced Lighting Power Density
[] C406.4 Enhanced Digital Lighting Controls
[] C406.5 On-Site Renewable Energy
[] C406.6 Dedicated Outdoor Air System
[] C406.7 Reduced Energy Use in Service Water Heating

SCALE: 12" = 1'-0" DATE DRAWN 10/02/23
CODE SUMMARY
A-0.1

OWASA ADMINISTRATIVE BUILDING COPING AND EIFS IMPROVEMENTS

400 JONES FERRY ROAD, CARRBORO, NC 27510

OWASA CIP: #280-17

CLIENT/OWNER
OWASA
BRAD BARBER
919.537.4343

THOUGHTCRAFT ARCHITECTS
A R C H I T E C T S
thoughtcraftarchitects.com
Durham, NC 919.371.0721
Somerville, MA 617.848.2602

CONSTRUCTION 10/27/23
ISSUE DATE



SCALE: 12" = 1'-0" DATE DRAWN 10/02/23

CODE SUMMARY

A-0.1



IMAGE 1



IMAGE 2




IMAGE 3




IMAGE 4



IMAGE 5

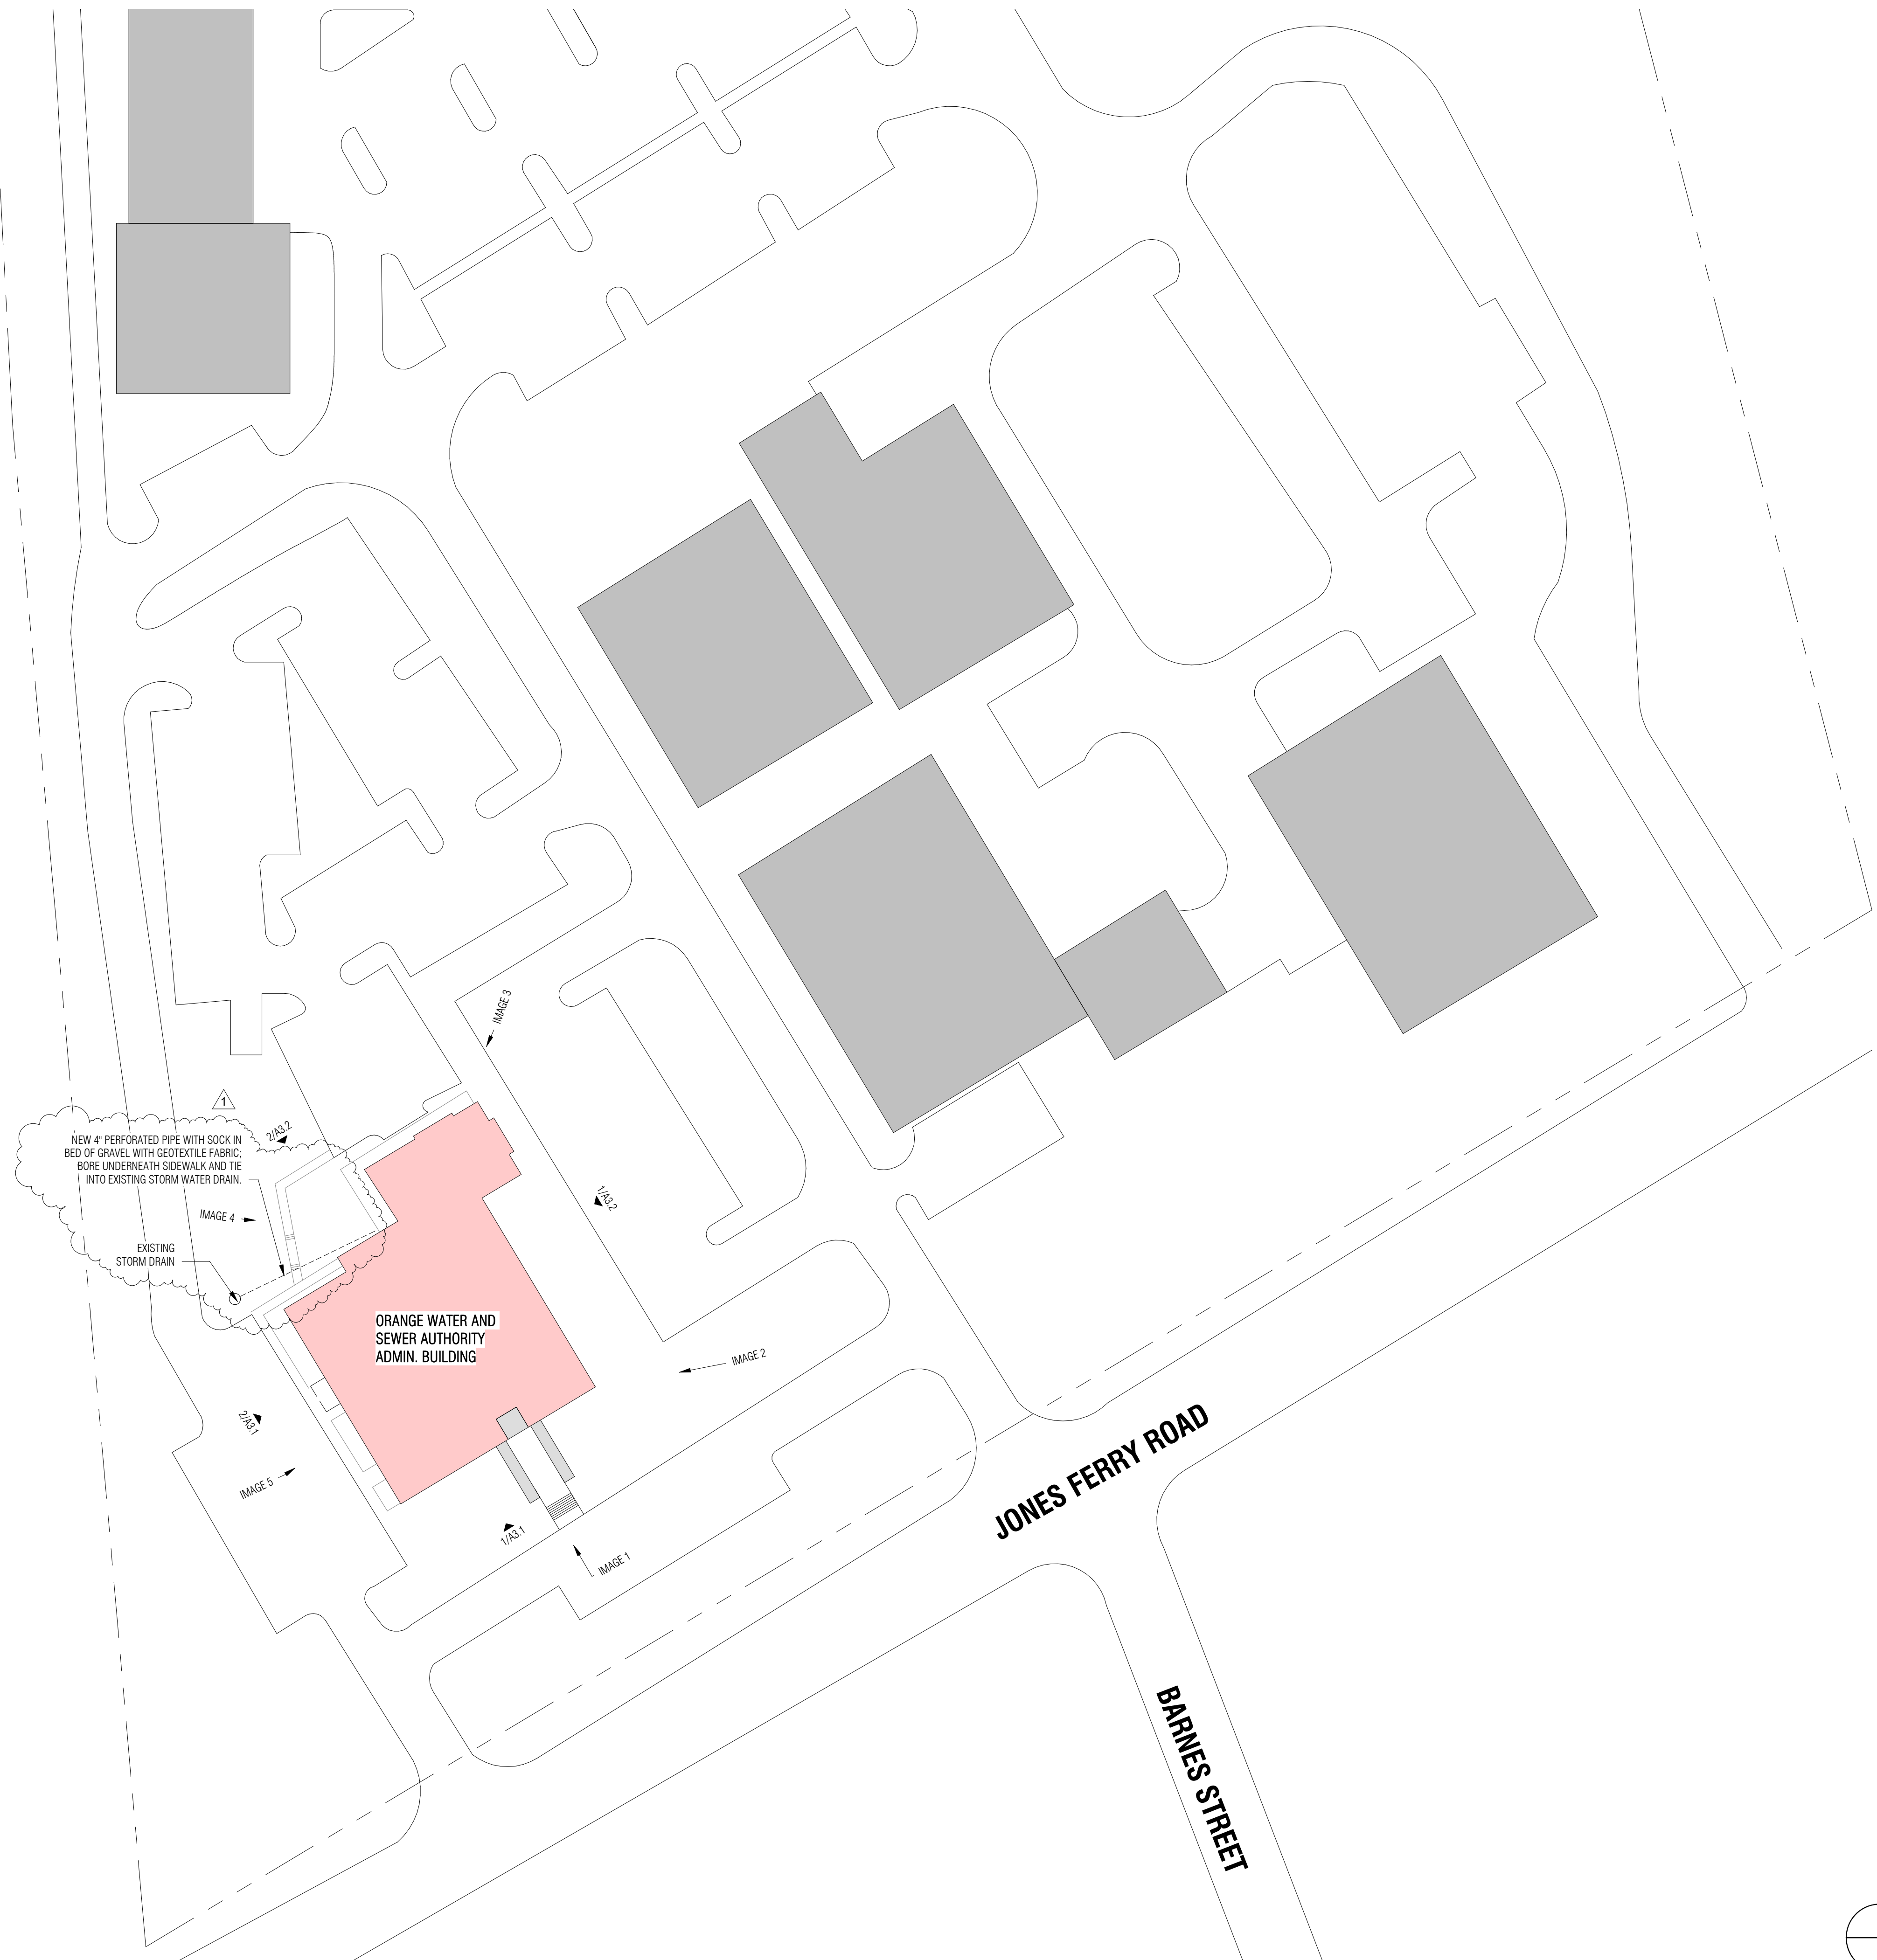

1 PARTIAL SITE PLAN
1" = 40'-0"

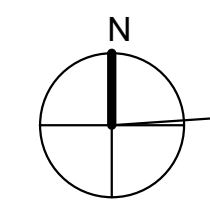

OWASA
ADMINISTRATIVE
BUILDING COPING
AND EIFS
IMPROVEMENTS

400 JONES FERRY ROAD,
CARRBORO, NC 27510

OWASA CIP: #280-17

CLIENT/OWNER
OWASA
BRAD BARBER
919.537.4343

THOUGHTCRAFT
ARCHITECTS
thoughtcraftarchitects.com
Durham, NC | 919.371.0721
Somerville, MA | 617.848.2602


ADDENDUM 01	11.09.23
CONSTRUCTION	10.27.23
ISSUE	DATE



SCALE: 1" = 40'-0" DATE DRAWN: 08/08/23

SITE PLAN

A-0.2

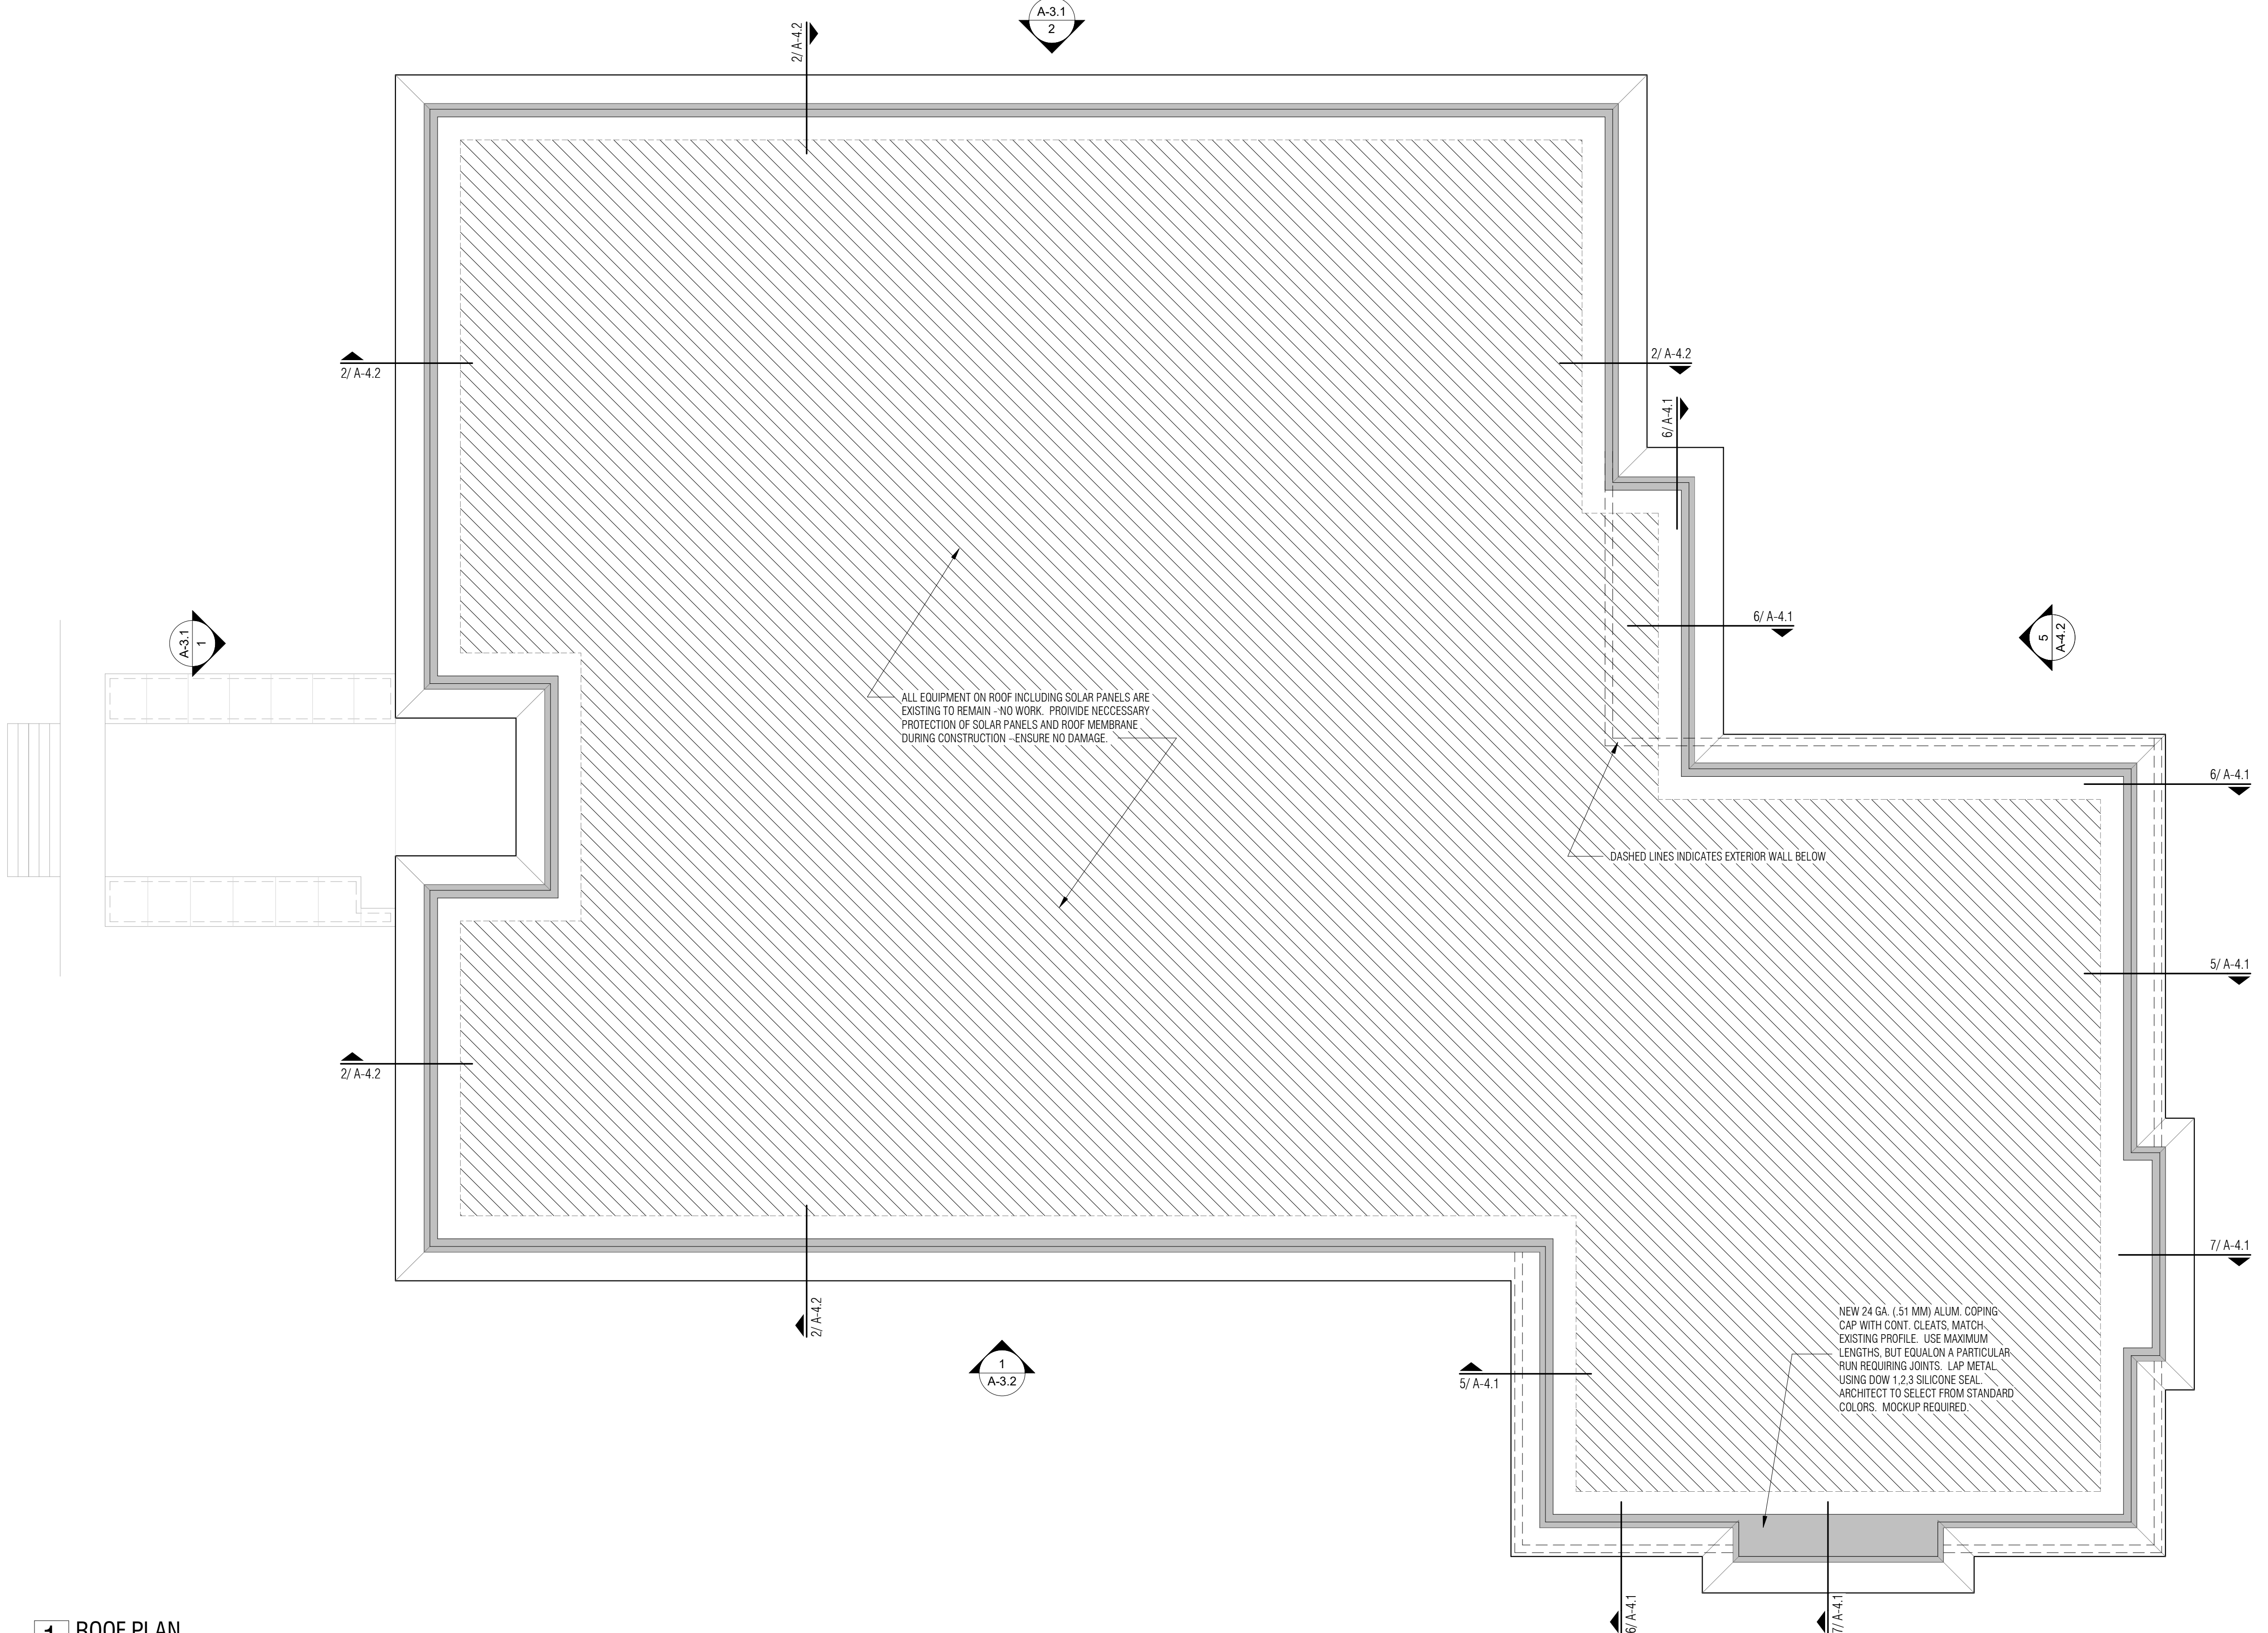


1 ROOF PLAN
1/8" = 1'-0"

FINISH LEGEND AND SPECIFICATIONS					
<p>NOTES: 1. DATA HEREIN REPRESENTS BASIS OF DESIGN PERFORMANCE. APPROVED EQUALS MAY BE ACCEPTED, SEE PROJECT MANUAL FOR DETAILS. 2. PROVIDE SUBMITTALS FOR ALL PRODUCTS AND ITEMS SPECIFIED ON DRAWINGS AS WELL AS THOSE WITHIN PROJECT MANUAL. INCLUDE PRODUCT DATA, WARRANTY SAMPLE, CERTIFICATIONS, TEST REPORTS, AND PHYSICAL SAMPLES. 3. INSTALL ALL PRODUCTS PER MANUFACTURER'S RECOMMENDATIONS. 4. ALL ITEMS LISTED IN FINISH LEGEND ARE CONTRACTOR FURNISHED, CONTRACTOR INSTALLED UNLESS OTHERWISE NOTED.</p>					
<p>EIFS: MANUFACTURERS: A. SENERGY TERSUS OR APPROVED EQUAL</p> <p>1. COLOR: TO MATCH EXISTING EIFS. SAMPLE TO BE SELECTED BY ARCHITECT AND OWNER. 2. TEXTURE: SMOOTH. APPROVED MOCKUP BY ARCHITECT AND OWNER REQUIRED PRIOR TO PROCEEDING WITH REMAINDER OF WORK. NOTE: PARGE COAT ON BRIDGE TO MATCH NEW EIFS COLOR AND TEXTURE.</p>	<p>EIFS SOFFIT VENT: MANUFACTURER: A. FRY REGLET PCS-75-V-150 OR APPROVED EQUAL</p> <p>1. COLOR: TO MATCH EIFS. SAMPLE TO BE SELECTED BY ARCHITECT AND OWNER.</p>	<p>REINFORCED PRE-CAST STONE CAPS: MANUFACTURERS: A. CUSTOM CAST STONE OR APPROVED EQUAL</p> <p>1. COLOR: WHITE TO MATCH NEW EIFS COLOR. ARCHITECT TO SELECT FROM MANUF. COLORS 2. MATERIAL: MIN. 4 1/2" REINFORCED PRE-CAST PANEL 3. SLOPE: CROWN IN MIDDLE. SLOPE 1/8" TO EITHER SIDE 4. Drip: PROVIDE A MIN. OVERHANG OF 1 1/2" 5. INSTALL: DOWEL AND EPOXY, MIN. 4 PER PANEL 6. PANEL WIDTHS AND DETAILS: SEE A6.1</p> <p>CONTRACTOR TO BE RESPONSIBLE FOR NECESSARY LOADING AND SPAN CALCULATIONS OF THE OPENING.</p>	<p>METAL CANOPY: MANUFACTURERS: A. DAC AWNINGS OR APPROVED EQUAL</p> <p>1. COLOR: MATCH EXISTING CANOPIES ON SITE 2. MATERIAL: MATCH EXISTING PROFILE AND METAL 3. SLOPE: SHALLOW SLOPE TO ALLOW FOR MINIMAL COUNTER FLASHING AT ADJACENT WALL MIN. 2:12, G.C. TO PROVIDE SHOP DRAWINGS TO VERIFY WITH EXISTING BRICK.</p>	<p>METAL COPING CAP: MANUFACTURERS: A. OPEN</p> <p>1. COLOR: KYNAR COATING TO MATCH NEW EIFS COLOR. ARCHITECT TO SELECT FROM MANUF. OPTIONS 2. MATERIAL: 24 GA. (.51 MM) ALUM. WITH 20 GA. (.81MM) ALUM. CONT. CLEATS 3. JOINTS: LAP JOINTS PER MANUF. INSTRUCTIONS USE MAXIMUM LENGTHS, BUT EQUAL ON A PARTICULAR RUN REQUIRING JOINTS. 4. PROFILE: MATCH EXISTING PROFILE. MOCK-UP REQUIRED. MINIMUM (2) 4'-0" PANELS USING DOW 1,2,3 SILICONE STRIP</p>	<p>SILICONE SEAL: MANUFACTURERS: A. DOW 1,2,3 SILICONE STRIPS OR APPROVED EQUAL</p> <p>1. COLOR: TO BE SELECTED BY ARCHITECT FROM MANUF. COLORS. MOCKUP REQUIRED.</p>

GENERAL NOTES

- ALL GRIDLINES ARE TO FACE OF STUD FRAMING UNLESS OTHERWISE NOTED
- ALL DIMENSIONS ARE TO FACE OF STUD UNLESS OTHERWISE NOTED

- KEYNOTES**
- 01 REMOVE NUMBERS, STORE, CLEAN, REFINISH EIFS, AND REINSTALL EXISTING ELECTRICAL TO REMAIN IN PLACE.
 - 02 EXISTING GLAZING TO REMAIN, NO WORK. IF ANY CRACKING IS NOTED WITHIN EXISTING JOINTS, ADDITIONAL REINFORCING MESH IS REQUIRED PRIOR TO RE-SKIMMING THE SURFACE. IF CRACKING HAS OCCURRED WHERE A JOINT HAS NOT BEEN STRUCK AND ALIGNS WITH AN EXISTING JOINT, PROVIDE A JOINT, MESH AND RE-SKIM THE SURFACE.
 - 03 EXISTING EIFS REVEAL TO REMAIN.
 - 04 EXISTING PROFILE TO STAY THE SAME, ENSURE PROPER CLEANING AND ADD NEW FINISH COAT OVER EXISTING.
 - 05 EXISTING CANOPY TO REMAIN IN PLACE, NEW EIFS FINISH COAT AROUND FRAME AND UNDER SOFFIT.
 - 06 EXISTING FIRE ALARM, CAMERA AND ELECTRICAL DEVICES, AND PLAQUE TO REMAIN IN PLACE FOR DURATION OF WORK.
 - 07 DROP-OFF BOX IS EXISTING TO REMAIN.
 - 08 EXTERIOR ELECTRICAL LIGHTS TO BE MOVED 6" LOWER TO NOT INTERFERE WITH EIFS REPAIR. REPLACE ANY CRACKED OR DAMAGED BRICK IN KIND WITH COLOR MATCHED MORTAR.
 - 09 NEW 24 GA. ALUM. COPING CAP WITH CLEATS, SEE DETAIL 4/A/4.1, MATCH EXISTING PROFILE. USE MAXIMUM LENGTHS, BUT EQUAL ON A PARTICULAR RUN REQUIRING JOINTS. LAP METAL USING DOW 1,2,3 SILICONE SEAL. ARCHITECT TO SELECT FROM STANDARD COLORS.
 - 10 EXISTING CANOPIES TO REMAIN, NO WORK.
 - 11 EXISTING CANOPY AND TIE RODS TO BE DEMOLISHED AND DISPOSED. REPLACE ANY AFFECTED BRICK AND MORTAR IN KIND. NEW CANOPY TO MATCH EXISTING CANOPIES IN COLOR, MATERIAL, AND AESTHETIC ON WEST ELEVATION, SEE DETAILS 6.7/A4.2.
 - 12 EXISTING ROOF TO REMAIN. DO NOT REMOVE TERMINATION BAR.
 - 13 EXISTING BRICK TO REMAIN - NO WORK, U.N.O.
 - 14 PRIME AND PAINT SCUPPERS TO MATCH EIFS.

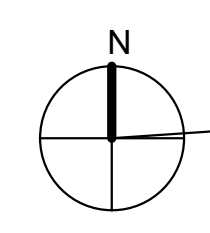

**OWASA
ADMINISTRATIVE
BUILDING COPING
AND EIFS
IMPROVEMENTS**

400 JONES FERRY ROAD,
CARRBORO, NC 27510

OWASA CIP: #280-17

CLIENT/OWNER
OWASA
BRAD BARBER
919.537.4343

THOUGHTCRAFT
ARCHITECTS
thoughtcraftarchitects.com
Durham, NC | 919.371.0721
Somerville, MA | 617.848.2602


ADDENDUM 01 11.09.23
CONSTRUCTION 10.27.23
ISSUE DATE




SCALE: As indicated DATE DRAWN: 09/28/10

EXTERIOR ELEVATIONS

A-3.1

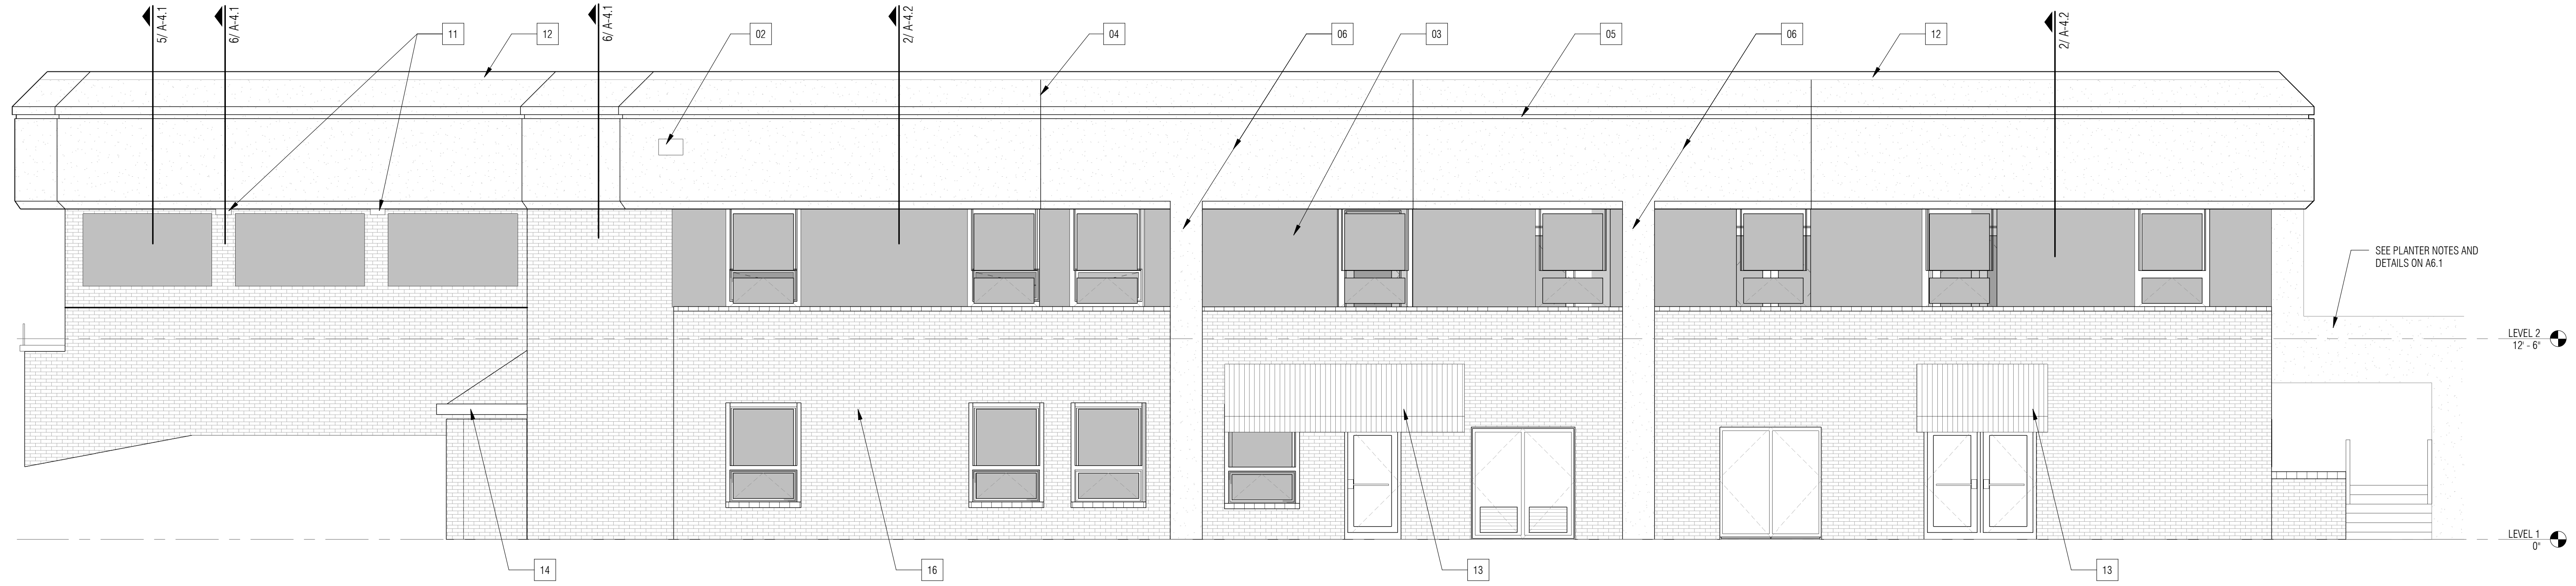

2 WEST ELEVATION
3/16" = 1'-0"

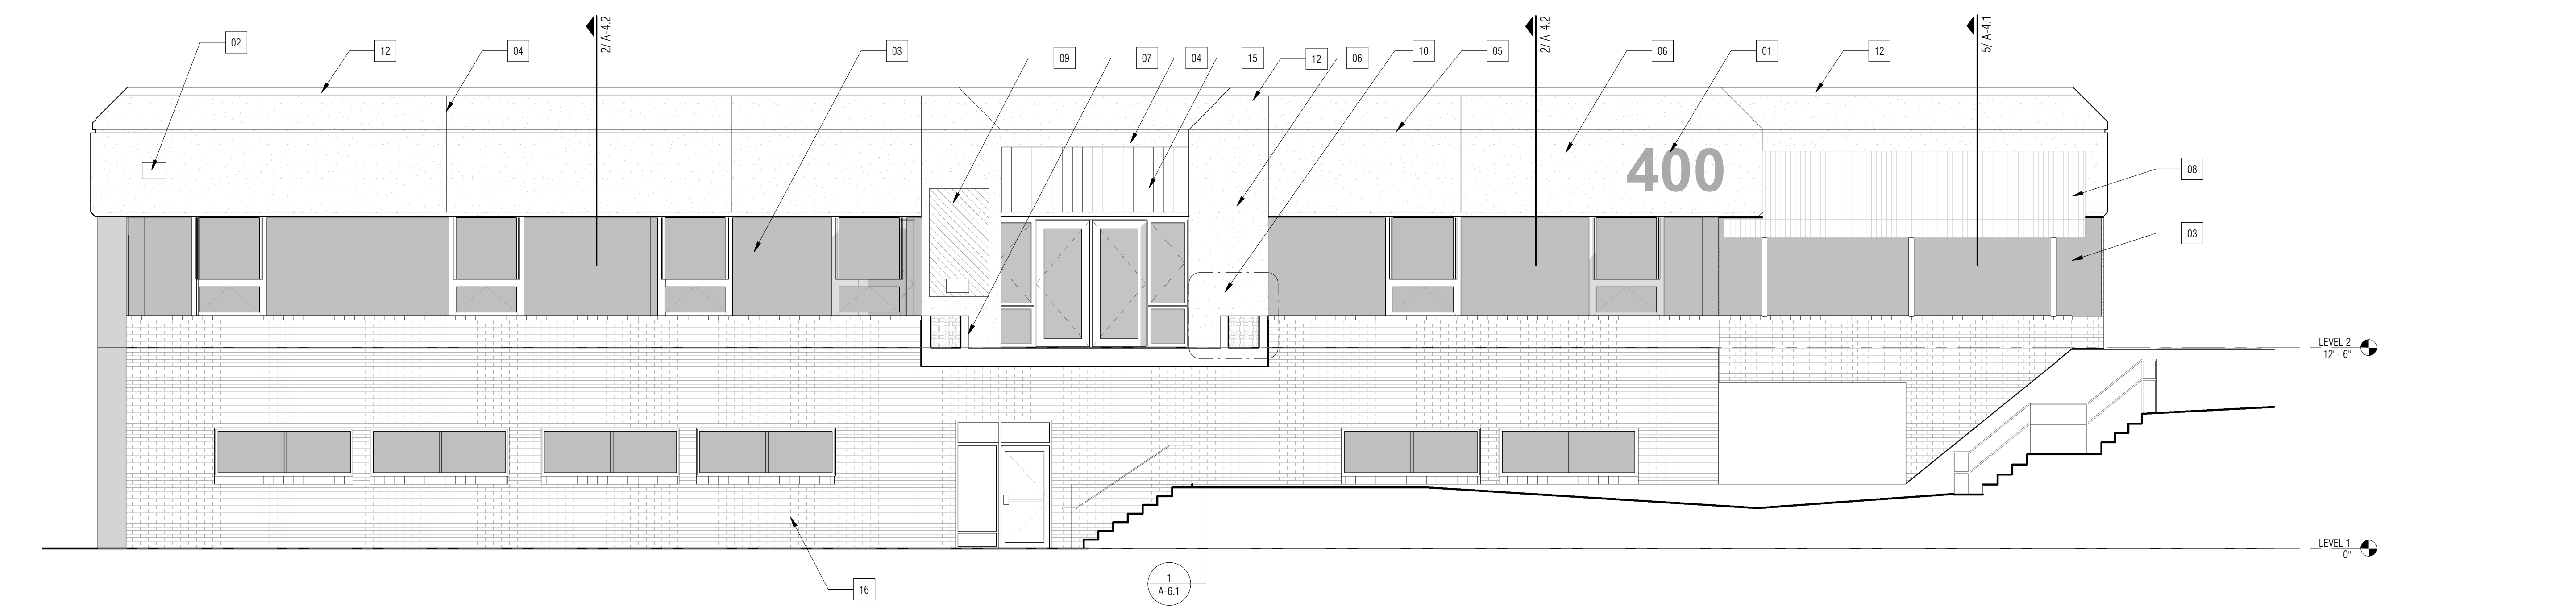

1 SOUTH ELEVATION
3/16" = 1'-0"

MATERIAL	APPROXIMATE QUANTITY*
METAL ROOF COPING	575 LF
EIFS SURFACE	~5,700 sf
BRIDGE PARGE COAT	~1,300 sf
EIFS SOFFIT VENT	~350 LF

*NOTE: QUANTITIES ARE APPROXIMATE. G.C. IS TO VERIFY.


GENERAL NOTES

- ALL GRIDLINES ARE TO FACE OF STUD FRAMING UNLESS OTHERWISE NOTED
- ALL DIMENSIONS ARE TO FACE OF STUD UNLESS OTHERWISE NOTED


ALL EXISTING JOINTS ARE TO REMAIN. IF ANY CRACKING IS NOTED WITHIN EXISTING JOINTS, ADDITIONAL REINFORCING MESH IS REQUIRED PRIOR TO RE-SKIMMING THE SURFACE. IF CRACKING HAS OCCURRED WHERE A JOINT HAS NOT BEEN STRUCK AND ALIGNS WITH AN EXISTING JOINT, PROVIDE A JOINT, MESH AND RE-SKIM THE SURFACE.

KEYNOTES

- 01 REMOVE NUMBERS, STORE, CLEAN, REFINISH EIFS, AND REINSTALL.
- 02 EXISTING ELECTRICAL TO REMAIN IN PLACE.
- 03 EXISTING GLAZING TO REMAIN. NO WORK.
- 04 EXISTING EIFS REVEAL TO REMAIN.
- 05 EXISTING PROFILE TO STAY THE SAME. ENSURE PROPER CLEANING AND ADD NEW FINISH COAT OVER EXISTING.
- 06 CAST IN PLACE CONCRETE PLANTERS - SEE DETAILS ON A6.1.
- 07 EXISTING CANOPY TO REMAIN IN PLACE. NEW EIFS FINISH COAT AROUND FRAME AND UNDER SOFFIT.
- 09 EXISTING FIRE ALARM, CAMERA AND ELECTRICAL DEVICES, AND PLAQUE TO REMAIN IN PLACE FOR DURATION OF WORK.
- 10 DROP-OFF BOX IS EXISTING TO REMAIN.
- 11 EXTERIOR ELECTRICAL LIGHTS TO BE MOVED 6" LOWER TO NOT INTERFERE WITH EIFS REPAIR. REPLACE ANY CRACKED OR DAMAGED BRICK IN KIND WITH COLOR MATCHED MORTAR.
- 12 NEW 24 GA. ALUM. COPING CAP WITH CLEATS, BUT EQUAL ON A PARTICULAR RUN REQUIRING JOINTS. LAP METAL USING DOW 1.2.3 SILICONE SEAL. ARCHITECT TO SELECT FROM STANDARD COLORS.
- 13 EXISTING CANOPIES TO REMAIN. NO WORK.
- 14 EXISTING CANOPY AND TIE RODS TO BE DEMOLISHED AND DISPOSED. REPLACE ANY AFFECTED BRICK AND MORTAR IN KIND. NEW CANOPY TO MATCH EXISTING CANOPIES IN COLOR, MATERIAL, AND AESTHETIC ON WEST ELEVATION. SEE DETAILS 6.7/A4.2.
- 15 EXISTING ROOF TO REMAIN. DO NOT REMOVE TERMINATION BAR.
- 16 EXISTING BRICK TO REMAIN - NO WORK. U.N.O.
- 17 PRIME AND PAINT SCUPPERS TO MATCH EIFS.

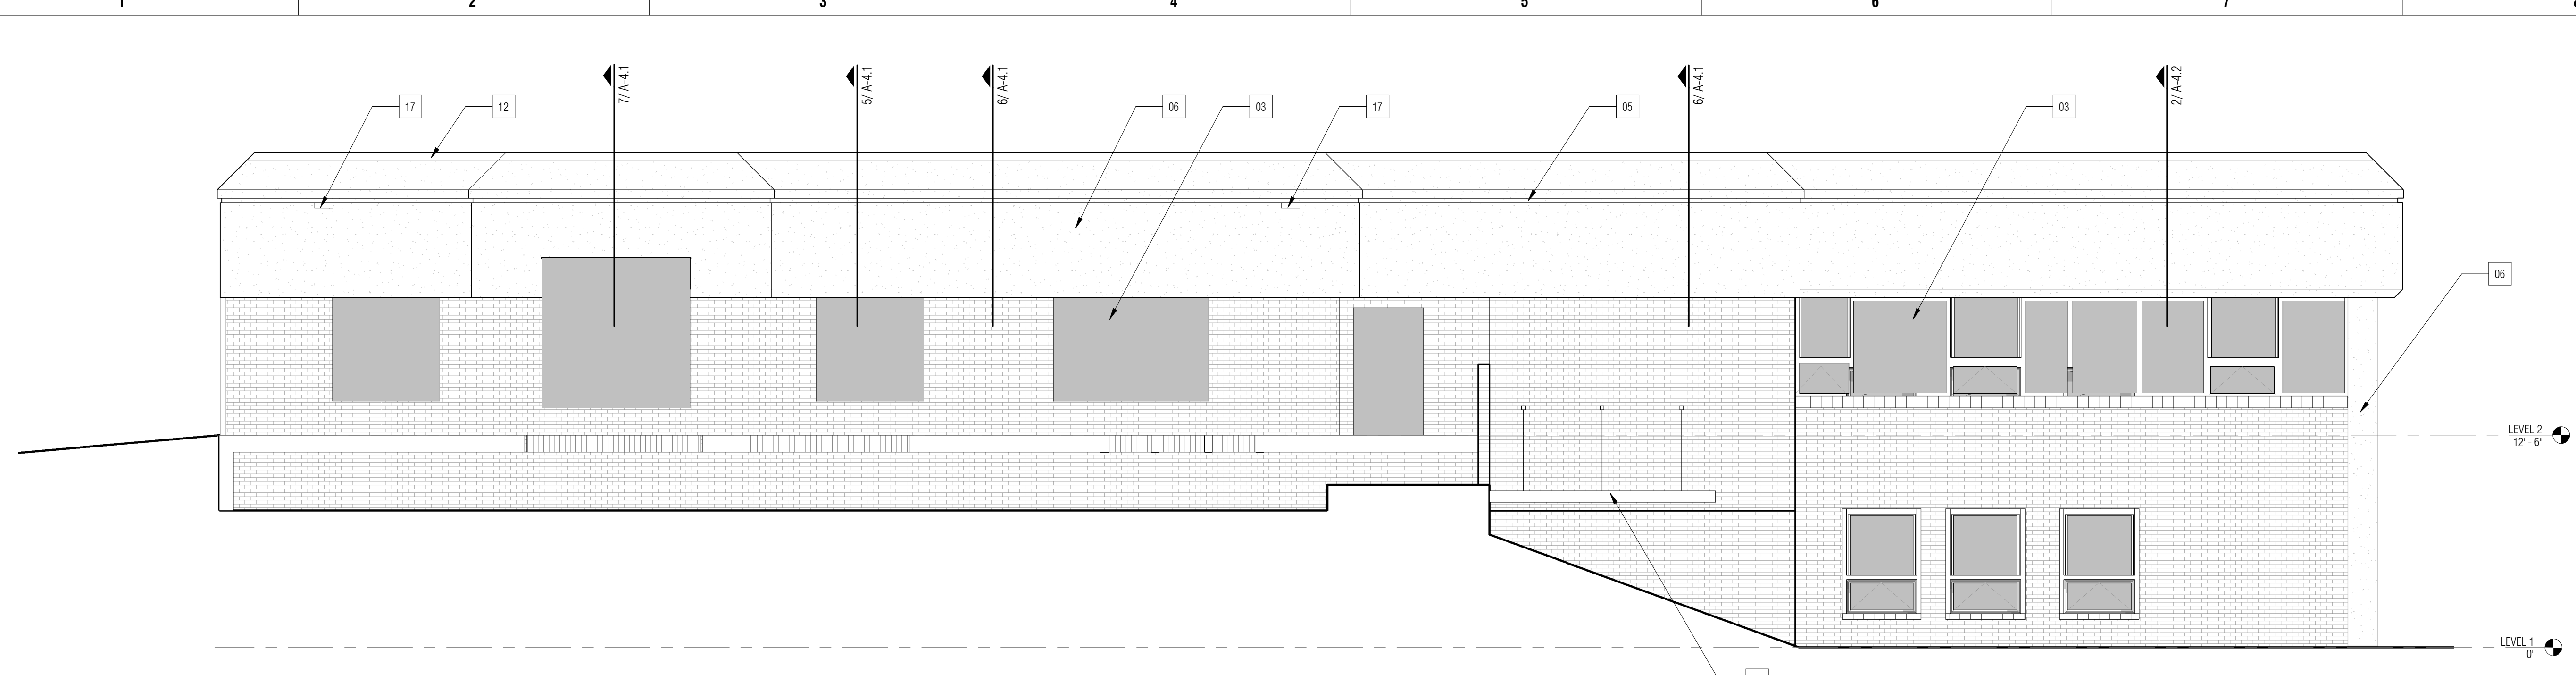

2 NORTH ELEVATION
3/16" = 1'-0"

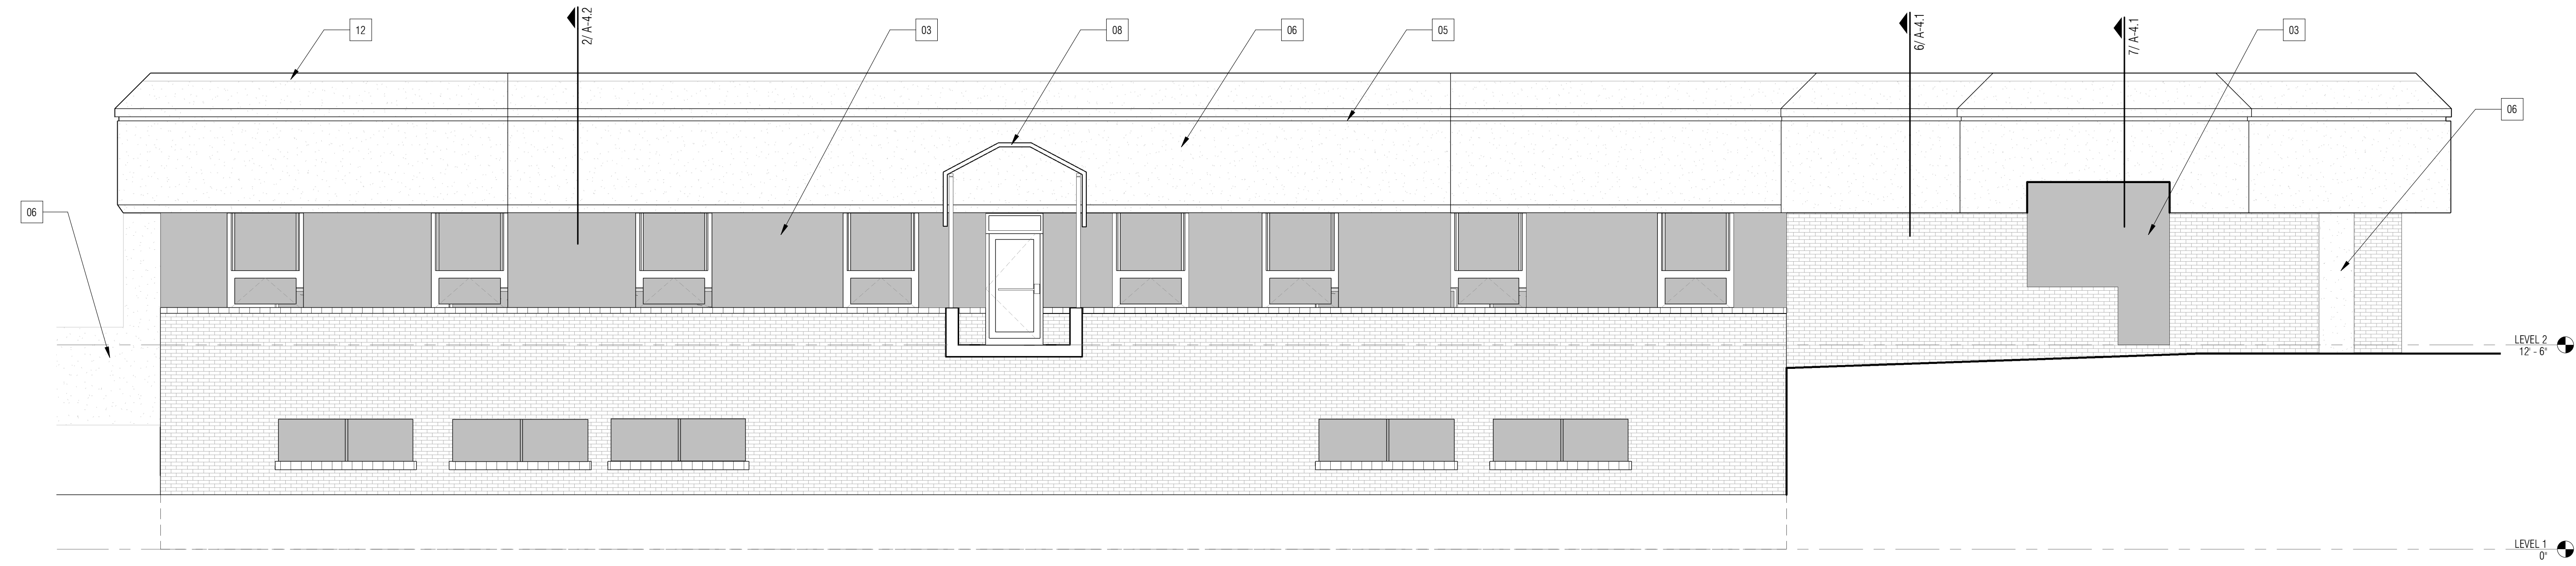


1 EAST ELEVATION
3/16" = 1'-0"

MATERIAL	APPROXIMATE QUANTITY*
METAL ROOF COPING	575 LF
EIFS SURFACE	~5,700 sf
BRIDGE PATCH COAT	~1,300 sf
EIFS SOFFIT VENT	~350 LF

*NOTE: QUANTITIES ARE APPROXIMATE. G.C. IS TO VERIFY.

- GENERAL NOTES**
- ALL GRIDLINES ARE TO FACE OF STUD FRAMING UNLESS OTHERWISE NOTED.
 - ALL DIMENSIONS ARE TO FACE OF STUD UNLESS OTHERWISE NOTED.

- KEYNOTES**
- 01 REMOVE NUMBERS, STORE, CLEAN, REFINISH EIFS, AND REINSTALL.
 - 02 EXISTING ELECTRICAL TO REMAIN IN PLACE.
 - 03 EXISTING GLAZING TO REMAIN. NO WORK. ALL EXISTING JOINTS ARE TO REMAIN. IF ANY CRACKING IS NOTED WITHIN EXISTING JOINTS, ADDITIONAL REINFORCING MESH IS REQUIRED PRIOR TO RE-SKIMMING THE SURFACE. IF CRACKING HAS OCCURRED WHERE A JOINT HAS NOT BEEN STRUCK AND ALIGNS WITH AN EXISTING JOINT, PROVIDE A JOINT, MESH AND RE-SKIM THE SURFACE.
 - 04 EXISTING EIFS REVEAL TO REMAIN. EXISTING PROFILE TO STAY THE SAME. ENSURE PROPER CLEANING AND ADD NEW FINISH COAT OVER EXISTING.
 - 05 CAST IN PLACE CONCRETE PLANTERS - SEE DETAILS ON A6.1.
 - 06 EXISTING CANOPY TO REMAIN IN PLACE. NEW EIFS FINISH COAT AROUND FRAME AND UNDER SOFFIT.
 - 07 REMOVE FIRE ALARM, CAMERA AND ELECTRICAL DEVICES, AND PLAQUE TO REMAIN IN PLACE FOR DURATION OF WORK.
 - 08 DROP-OFF BOX IS EXISTING TO REMAIN.
 - 09 EXTERIOR ELECTRICAL LIGHTS TO BE MOVED 6" LOWER TO NOT INTERFERE WITH EIFS REPAIR. REPLACE ANY CRACKED OR DAMAGED BRICK IN KIND WITH COLOR MATCHED MORTAR.
 - 10 NEW 24 GA. ALUM. COPING CAP WITH CLEATS, SEE DETAIL 4/A/4.1. MATCH EXISTING PROFILE. USE MAXIMUM LENGTHS, BUT EQUAL ON A PARTICULAR RUN REQUIRING JOINTS. LAP METAL USING DOW 1.2.3 SILICONE SEAL.
 - 11 ARCHITECT TO SELECT FROM STANDARD COLORS.
 - 12 EXISTING CANOPY AND TIE RODS TO BE DEMOLISHED AND DISPOSED. REPLACE ANY AFFECTED BRICK AND MORTAR IN KIND. NEW CANOPY TO MATCH EXISTING CANOPIES IN COLOR, MATERIAL, AND AESTHETIC ON WEST ELEVATION, SEE DETAILS 6.7/A4.2.
 - 13 EXISTING ROOF TO REMAIN. DO NOT REMOVE TERMINATION BAR.
 - 14 EXISTING BRICK TO REMAIN - NO WORK. U.N.O.
 - 15 PRIME AND PAINT SCUPPERS TO MATCH EIFS.

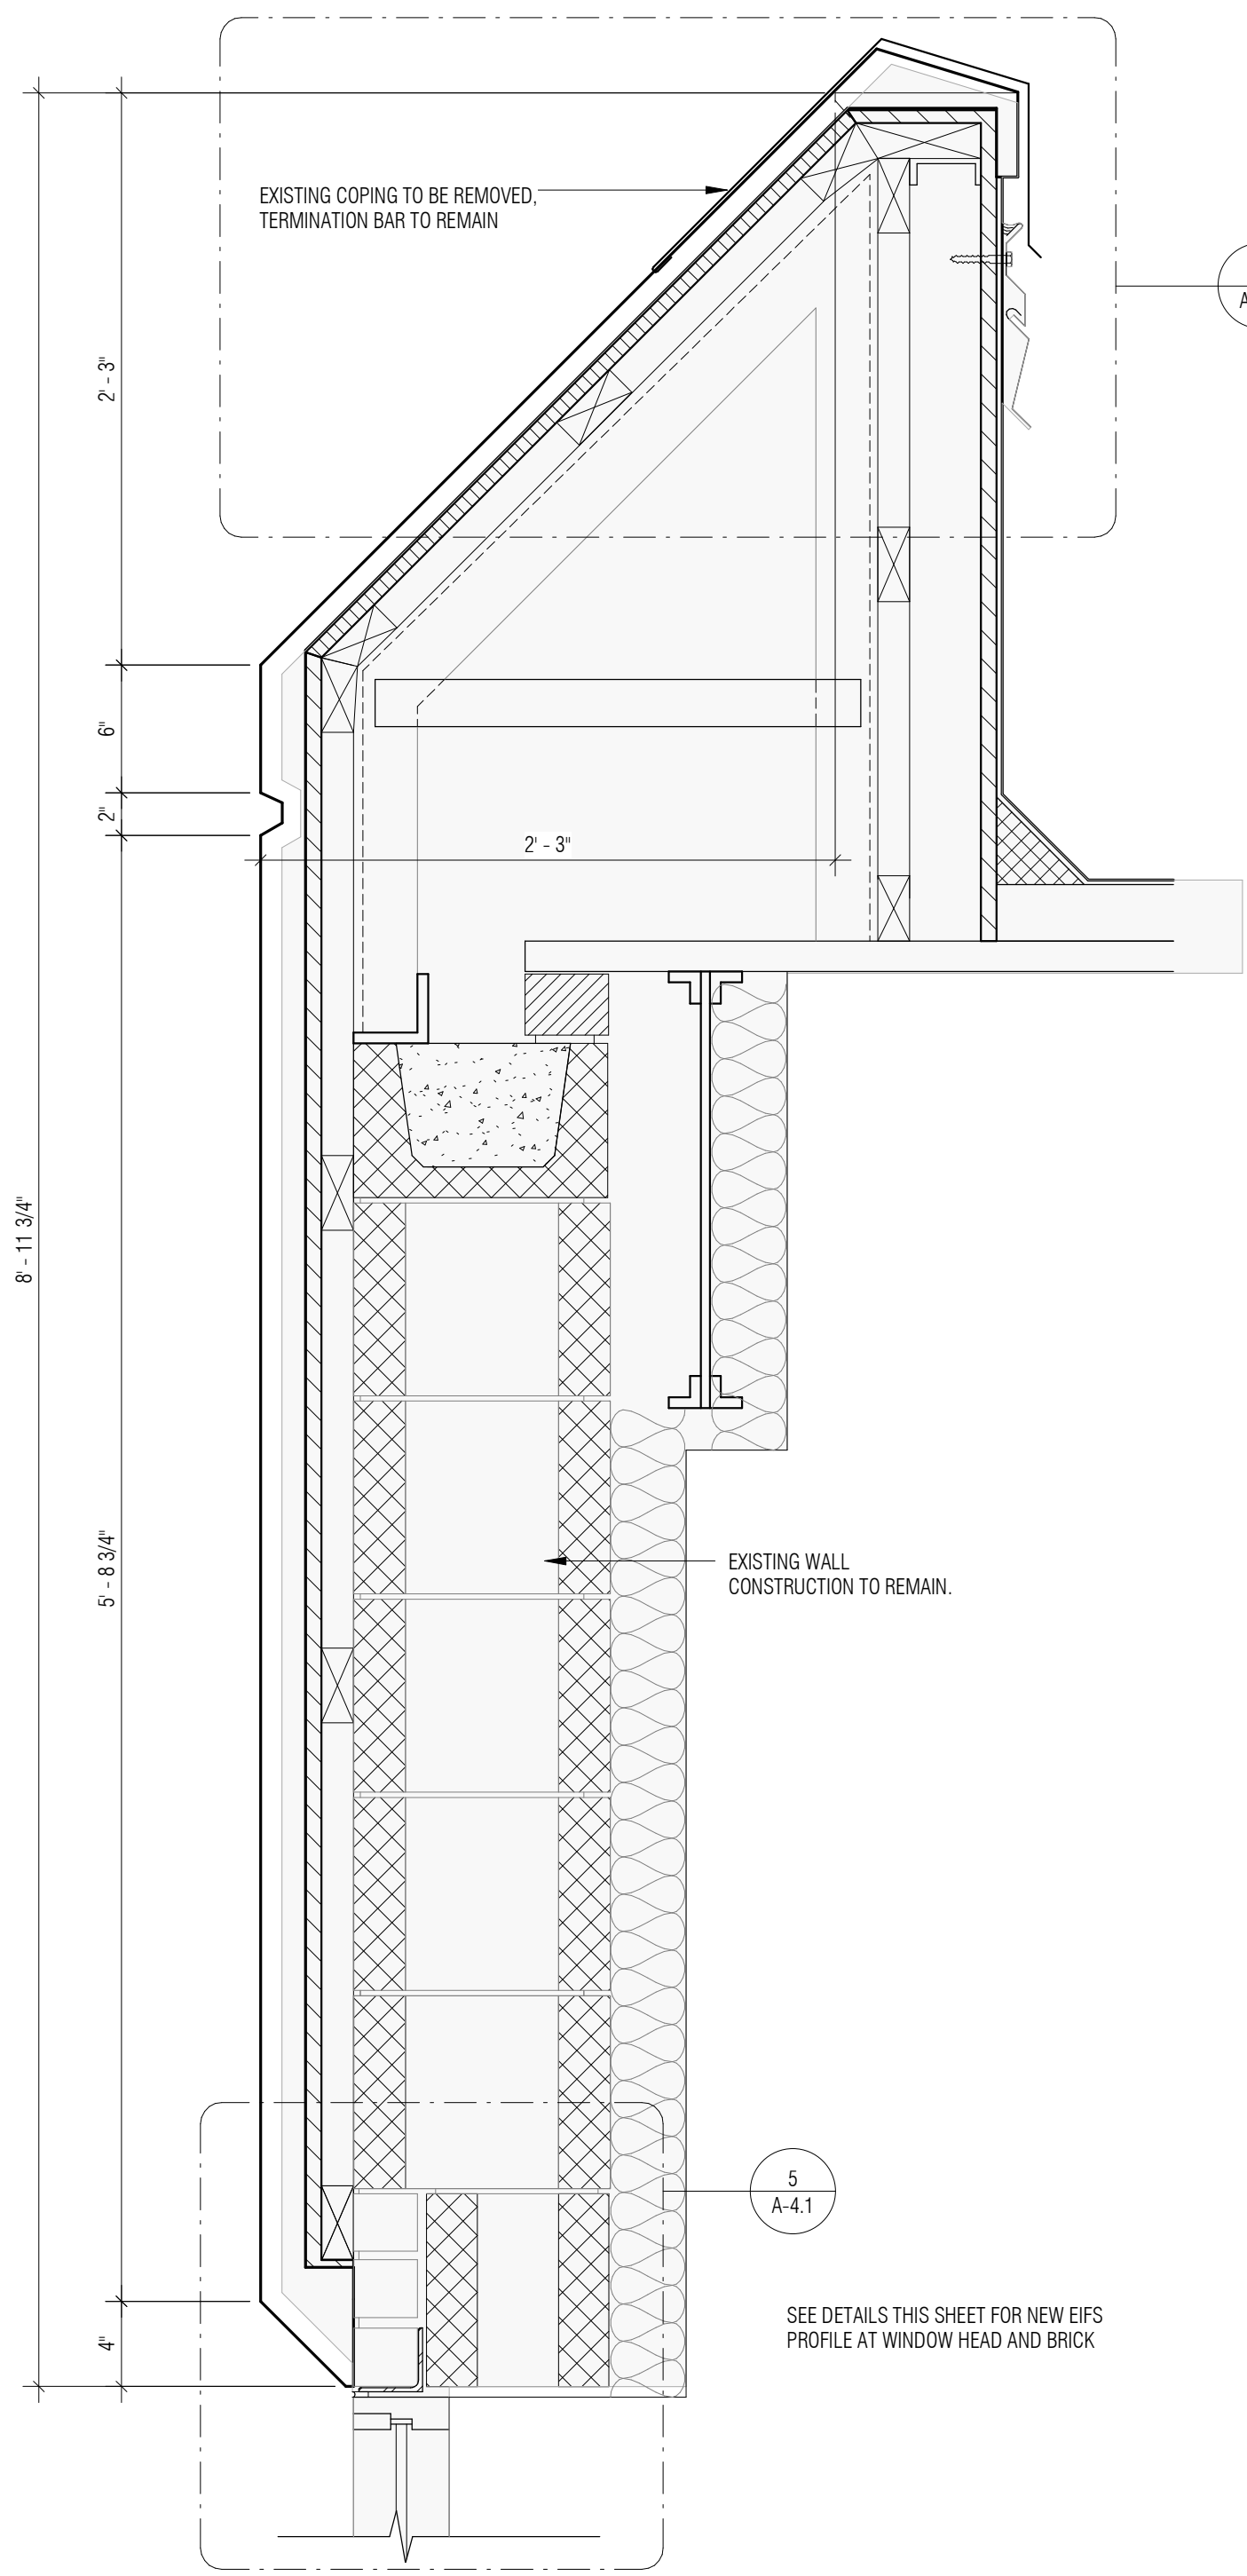


1 EXISTING DETAIL SECTION @ ADDITION
1 1/2" = 1'-0"

GENERAL NOTES:


- G.C. SHALL SPOT INVESTIGATE ENCLOSED CAVITIES FROM THE INTERIOR ABOVE THE CEILING AND SOFFIT BELOW AT EACH MOLD OR MILDEW FOUND NOTIFY OWNER AND ARCHITECT IMMEDIATELY AND RE-SEAL THE OPENING TO ENSURE NO NEGATIVE EFFECTS OF INDOOR AIR QUALITY INFILTRATE THE BUILDING. IF MOLD, MILDEW OR OTHER UNFORSEEN DAMAGE HAS BEEN DETERMINED THE G.C. CAN PROVIDE A CHANGE ORDER FOR ANY ADDITIONAL RELATED SCOPE OF WORK.
- CLEANING OF EXISTING EIFS WILL BE PERFORMED WITH A HOSE AND SCRUB BRUSH - NO POWERWASHING. IF SPOTS ARE NOT BECOMING CLEAN USE A MILD DETERGENT ONLY. TEST IN A SMALL AREA AND NOTIFY ARCHITECT IF STAINS PERSIST.
- ALL EIFS ON EXTERIOR FACADE IS TO BE RE-SURFACED. SEE DETAILS ON A4.1 AND A4.2.
- ALL EXISTING JOINTS ARE TO REMAIN. IF ANY CRACKING IS NOTED WITHIN EXISTING JOINTS, ADDITIONAL REINFORCING MESH IS REQUIRED PRIOR TO RE-SKIMMING THE SURFACE. IF CRACKING HAS OCCURED WHERE A JOINT HAS NOT BEEN STRUCK AND ALIGNS WITH AN EXISTING JOINT, PROVIDE A JOINT, MESH AND RE-SKIM THE SURFACE.
- MAINTAIN EXISTING PROFILE OF EIFS U.N.D.
- VERIFY ALL MATERIALS ARE INSTALLED IN ACCORDANCE WITH CURRENT INSTALLATION INSTRUCTIONS. ALL TERMINATIONS MUST BE FULLY ENCAPSULATED WITH MESH REINFORCED BASE COAT.
- PROVIDE A BACK WRAPPED TYPE JOINT WITH BACKER ROD AND SEALANT AT SYSTEM TERMINATION AT SOFFIT / FASCIA TRANSITIONS.
- REFERENCE KEY PLAN - THIS SHEET FOR EXTENT OF PROPOSED DETAILS.

LEGEND:

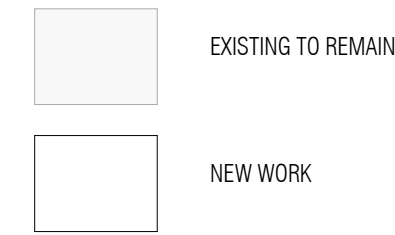


MATERIAL	APPROXIMATE QUANTITY*
METAL ROOF COPING	575 LF
EIFS SURFACE	~5,700 sf
BRIDGE PARGE COAT	~1,300 sf
EIFS SOFFIT VENT	~350 LF


*NOTE: QUANTITIES ARE APPROXIMATE. G.C. IS TO VERIFY.

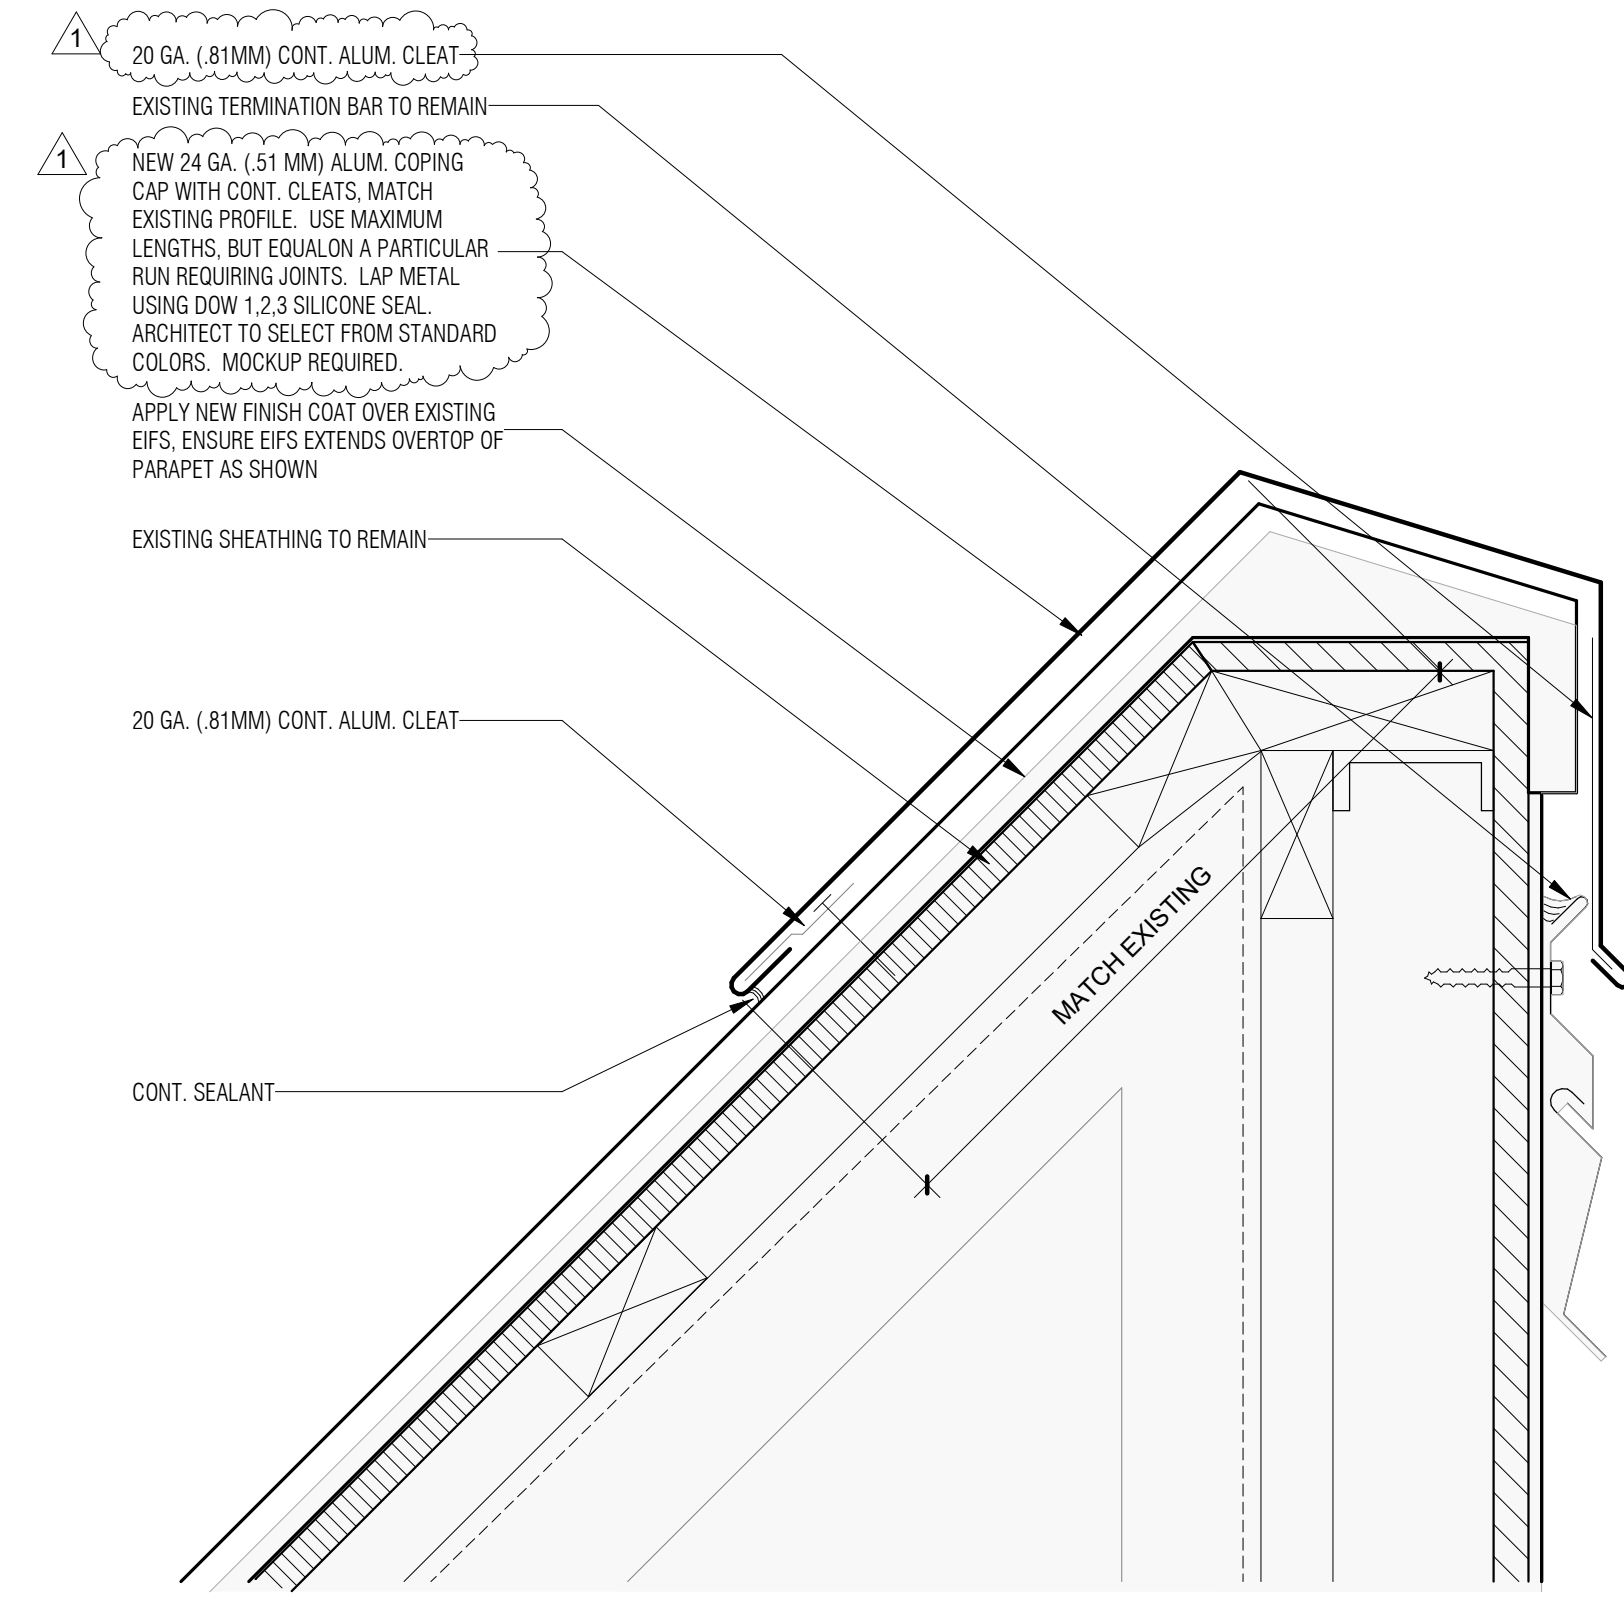

4 PROPOSED ROOF COPING DETAIL
3" = 1'-0"

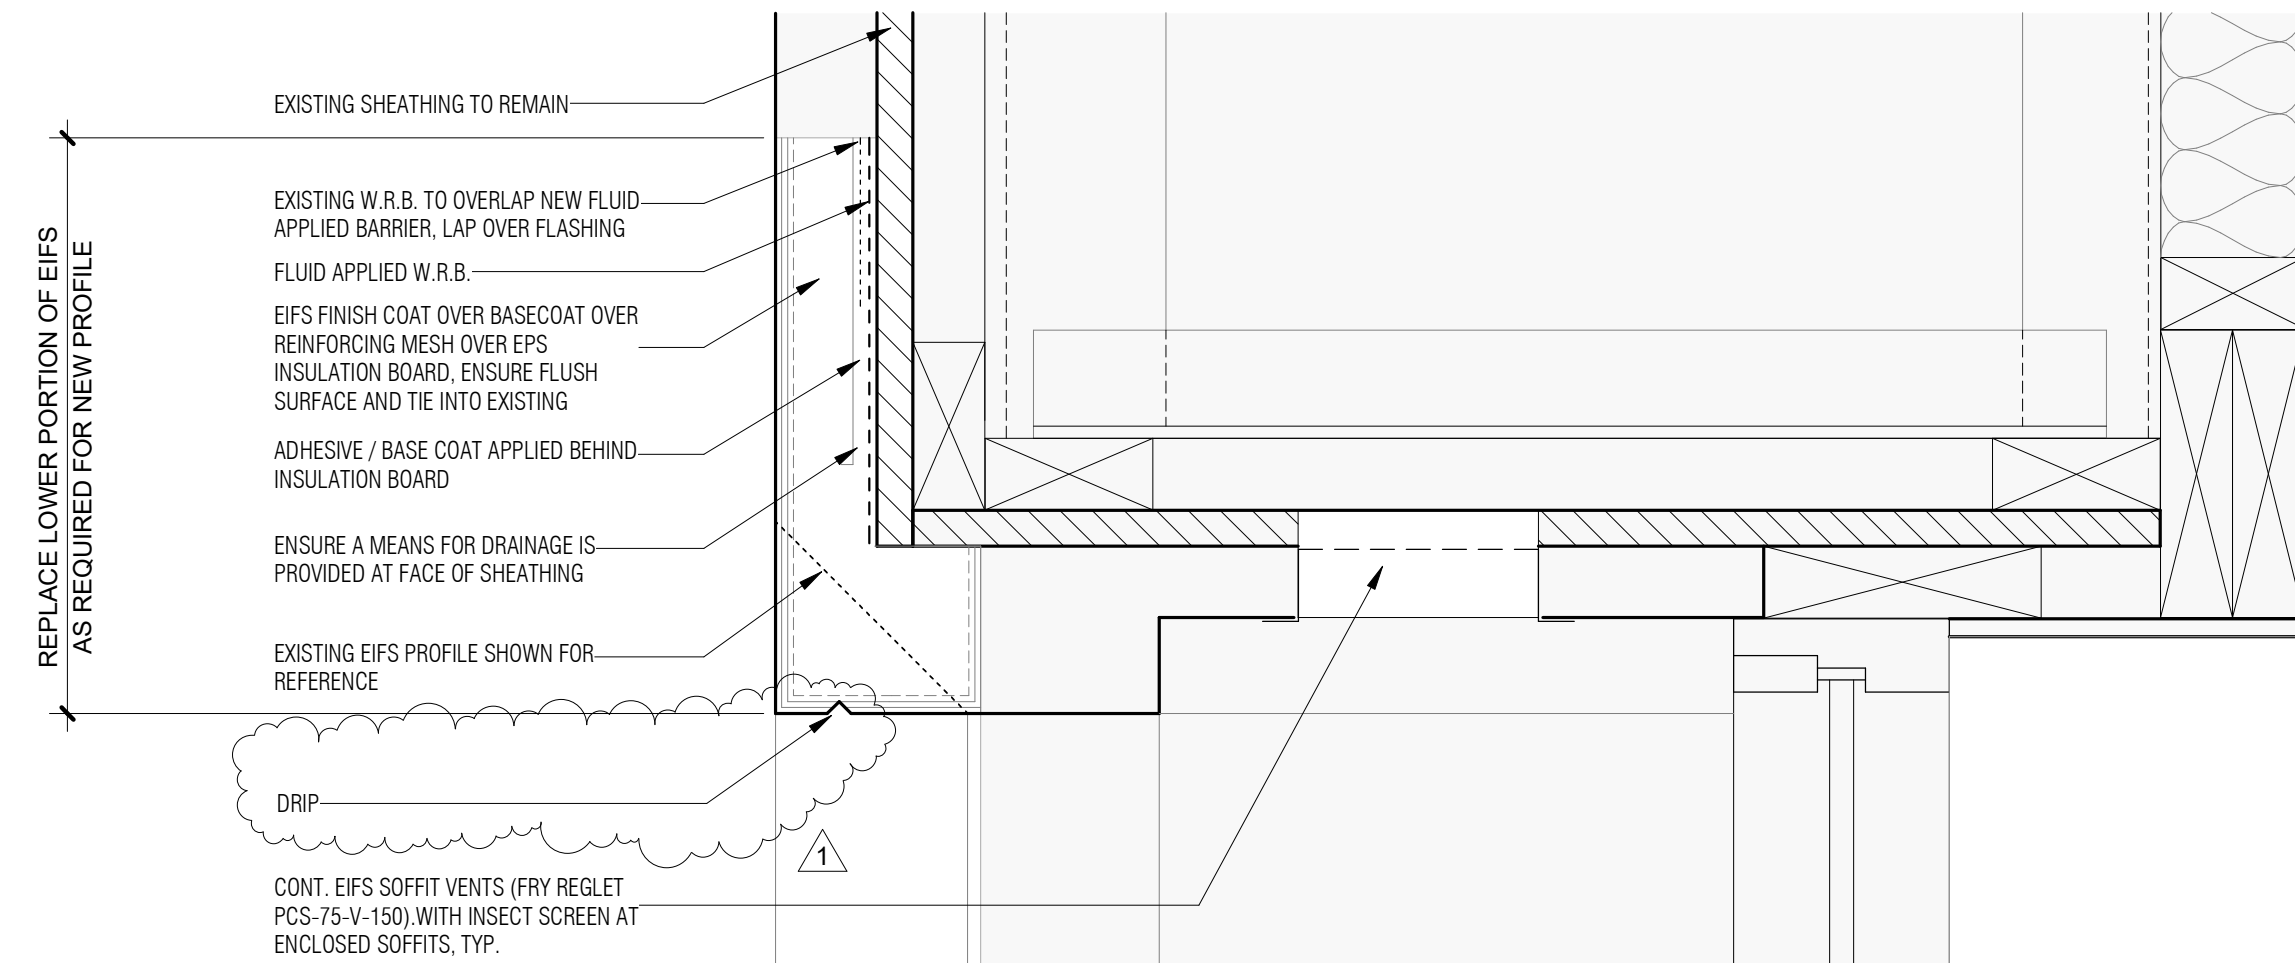

6 PROPOSED DETAIL SECTION OF EIFS REPAIR AT BRICK WALL
3" = 1'-0"

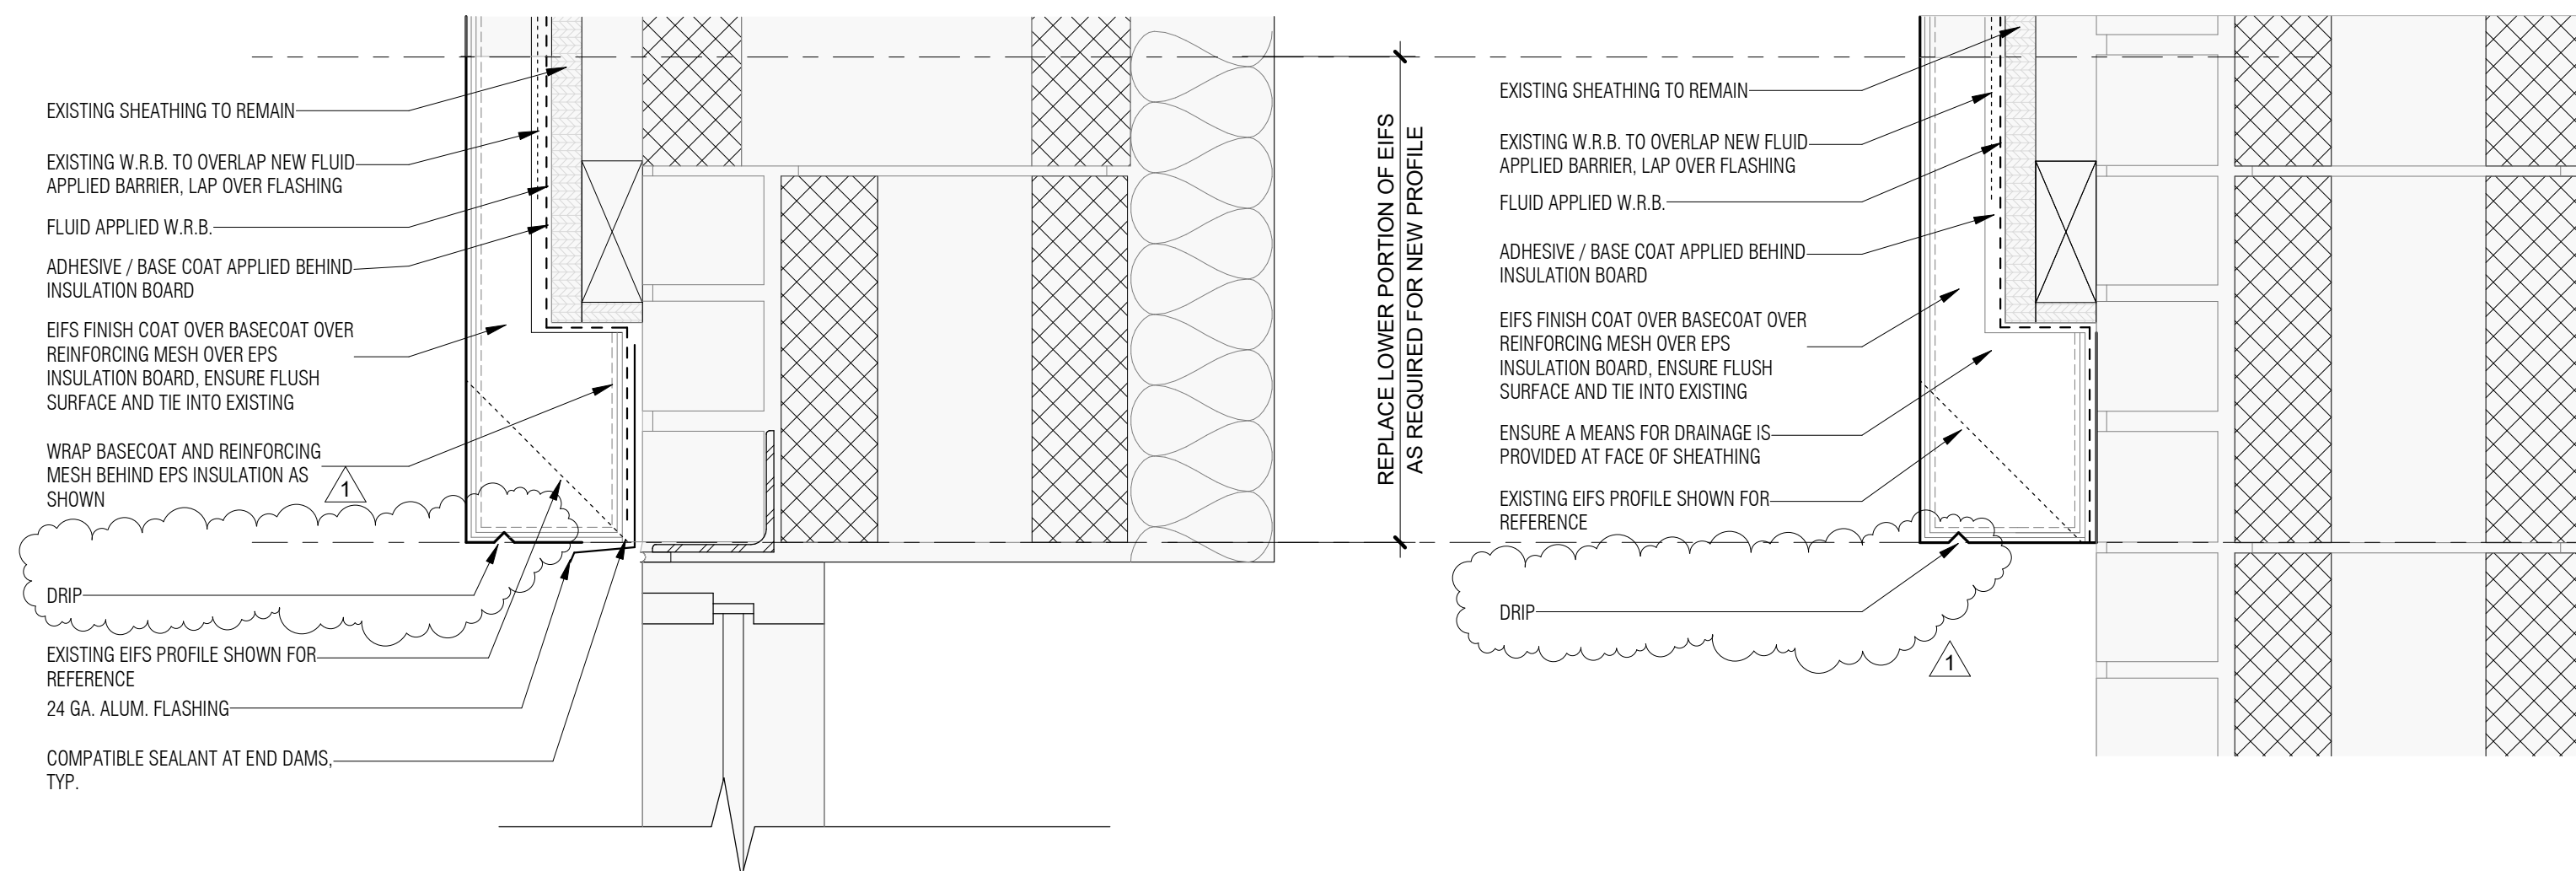


5 PROPOSED DETAIL SECTION OF EIFS REPAIR AT WINDOW HEAD
3" = 1'-0"

7 PROPOSED SOFFIT TRANSITION
3" = 1'-0"




VIEW OF EAST ROOF ELEVATION LOOKING SOUTH

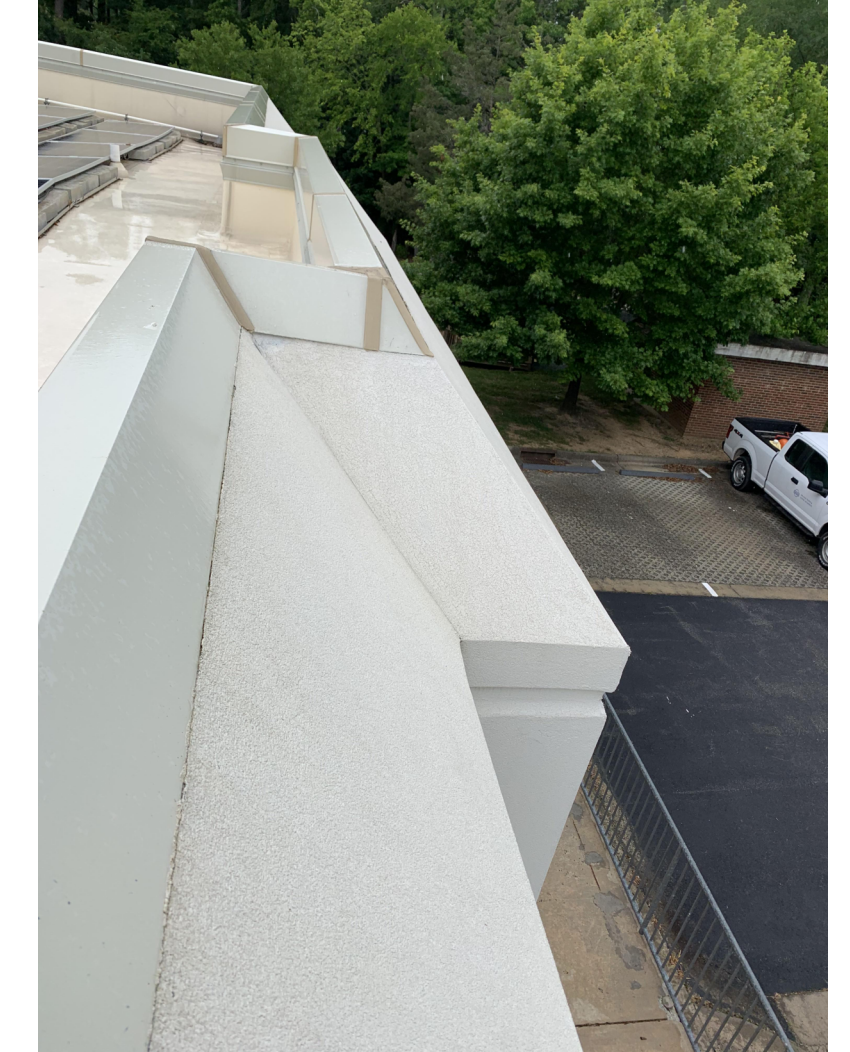


VIEW OF NORTH ROOF ELEVATION LOOKING WEST




VIEW OF NORTH ELEVATION LOOKING EAST TOWARD WATER TREATMENT PLANT

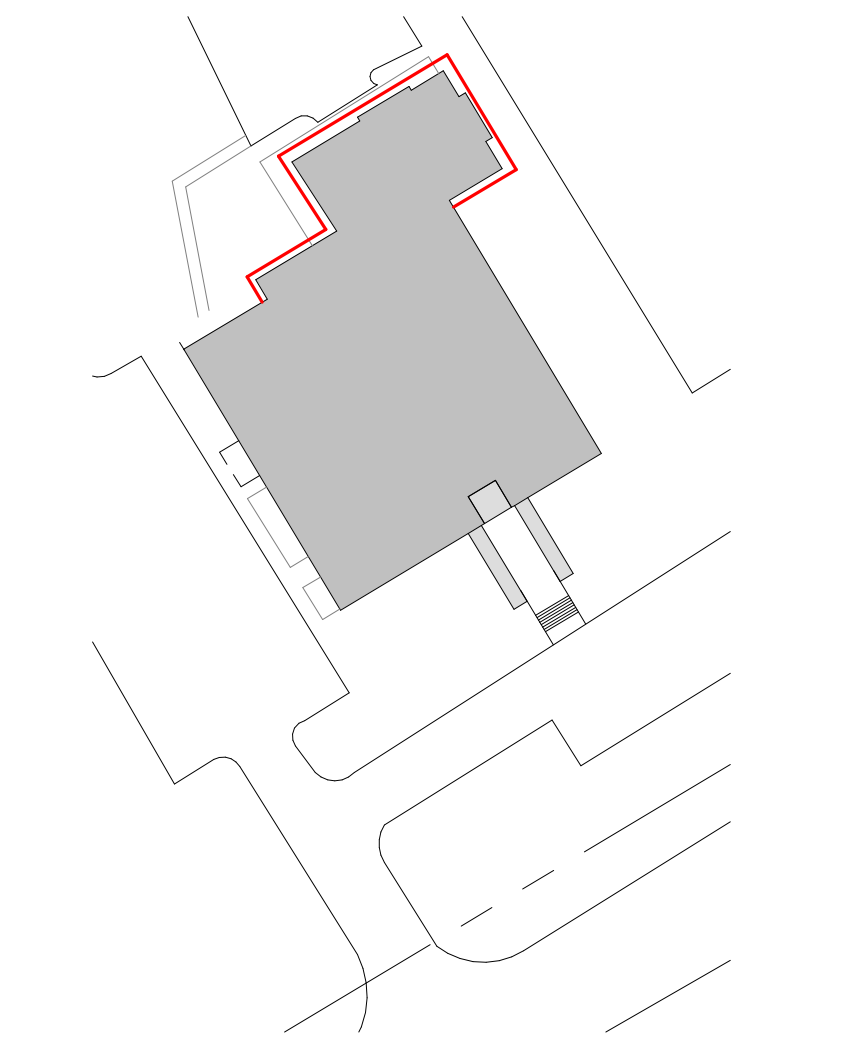

EXTERIOR SOFFIT KEY PLAN

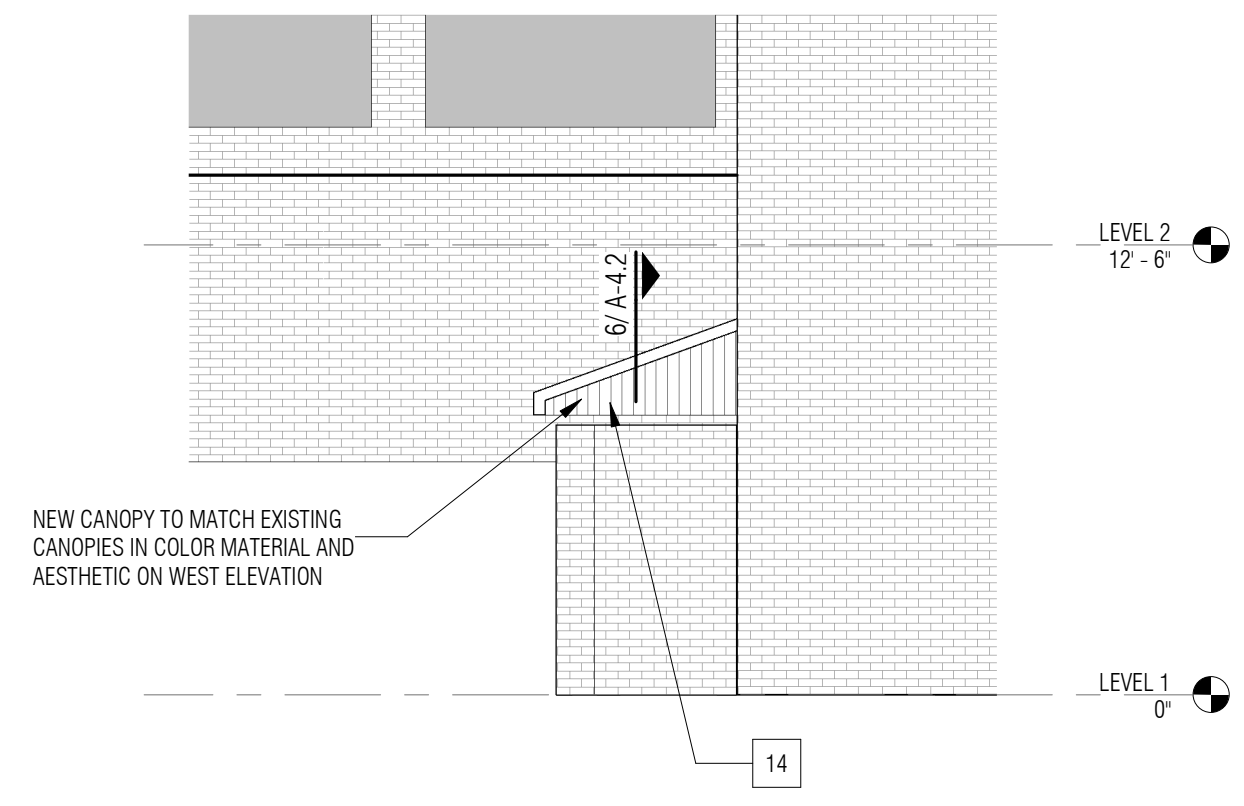


4 PARTIAL WEST ELEVATION AT NEW CANOPY
3/16" = 1'-0"

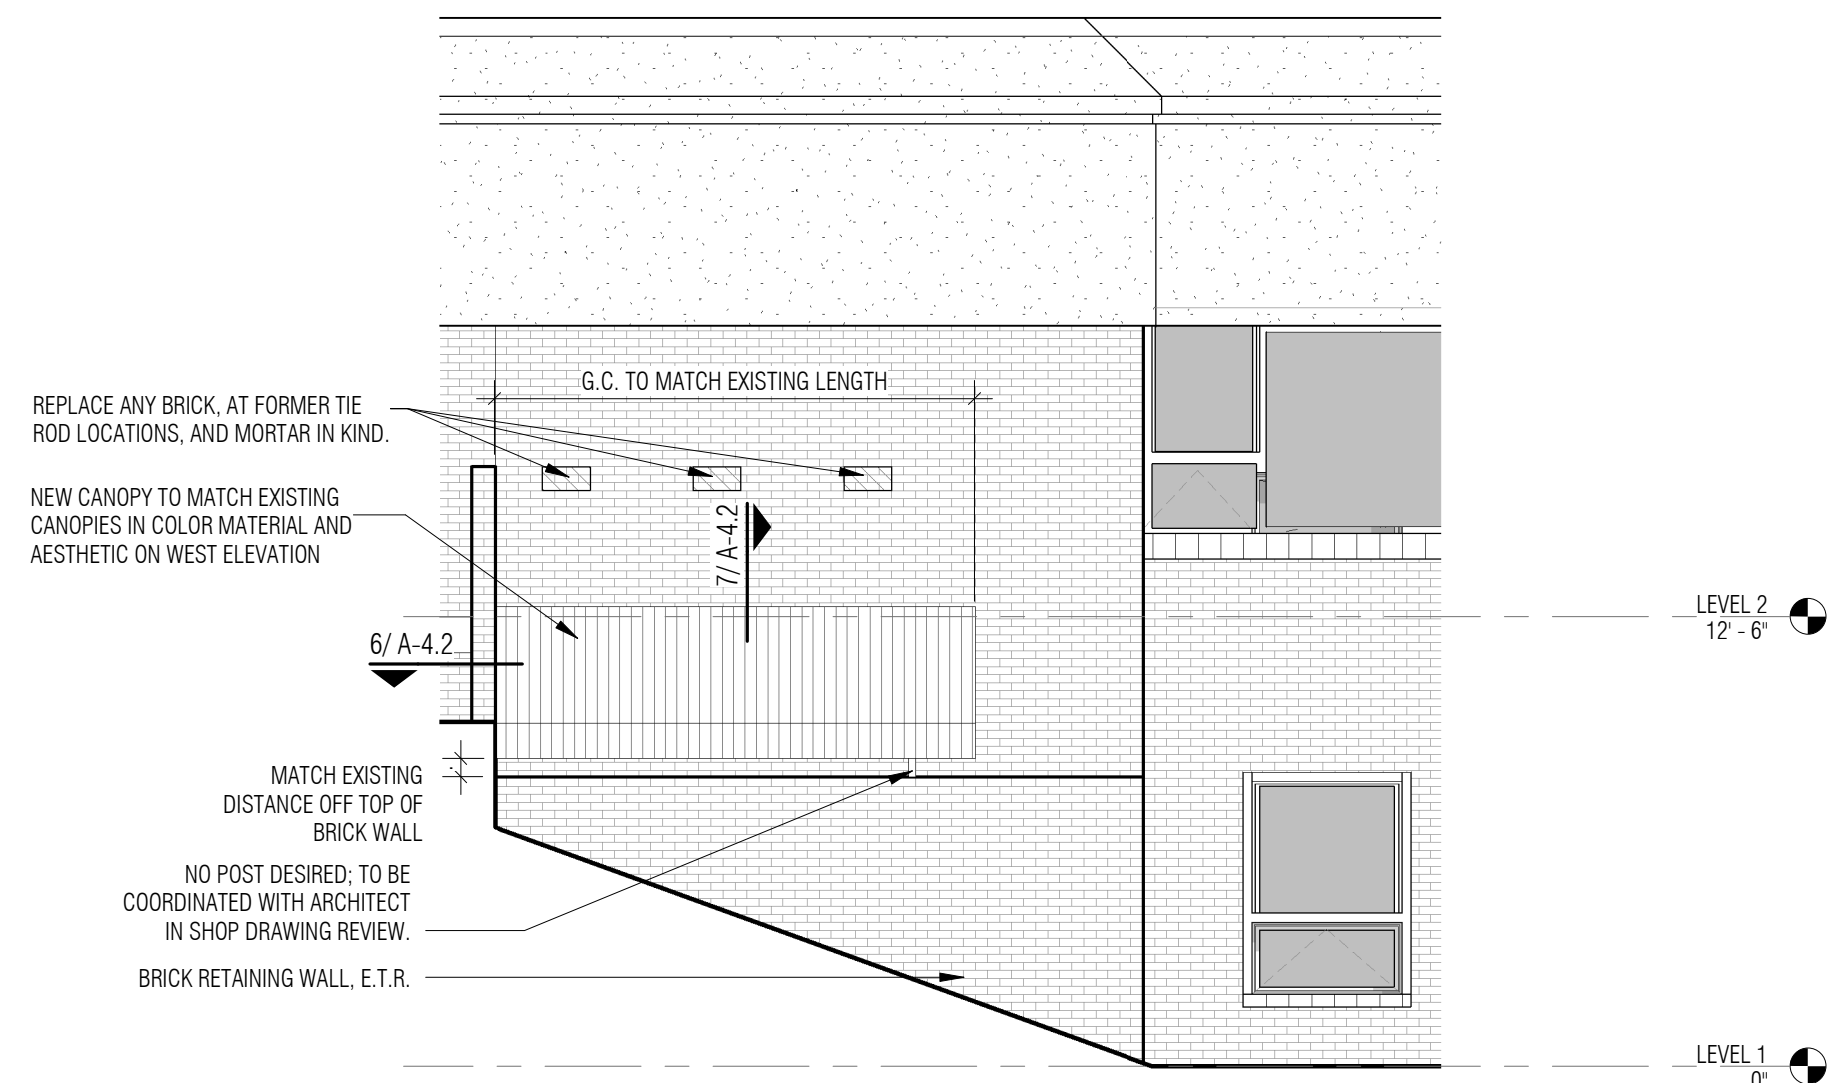


5 PARTIAL NORTH ELEVATION AT NEW CANOPY
3/16" = 1'-0"




EXISTING CANOPY TO BE REMOVED

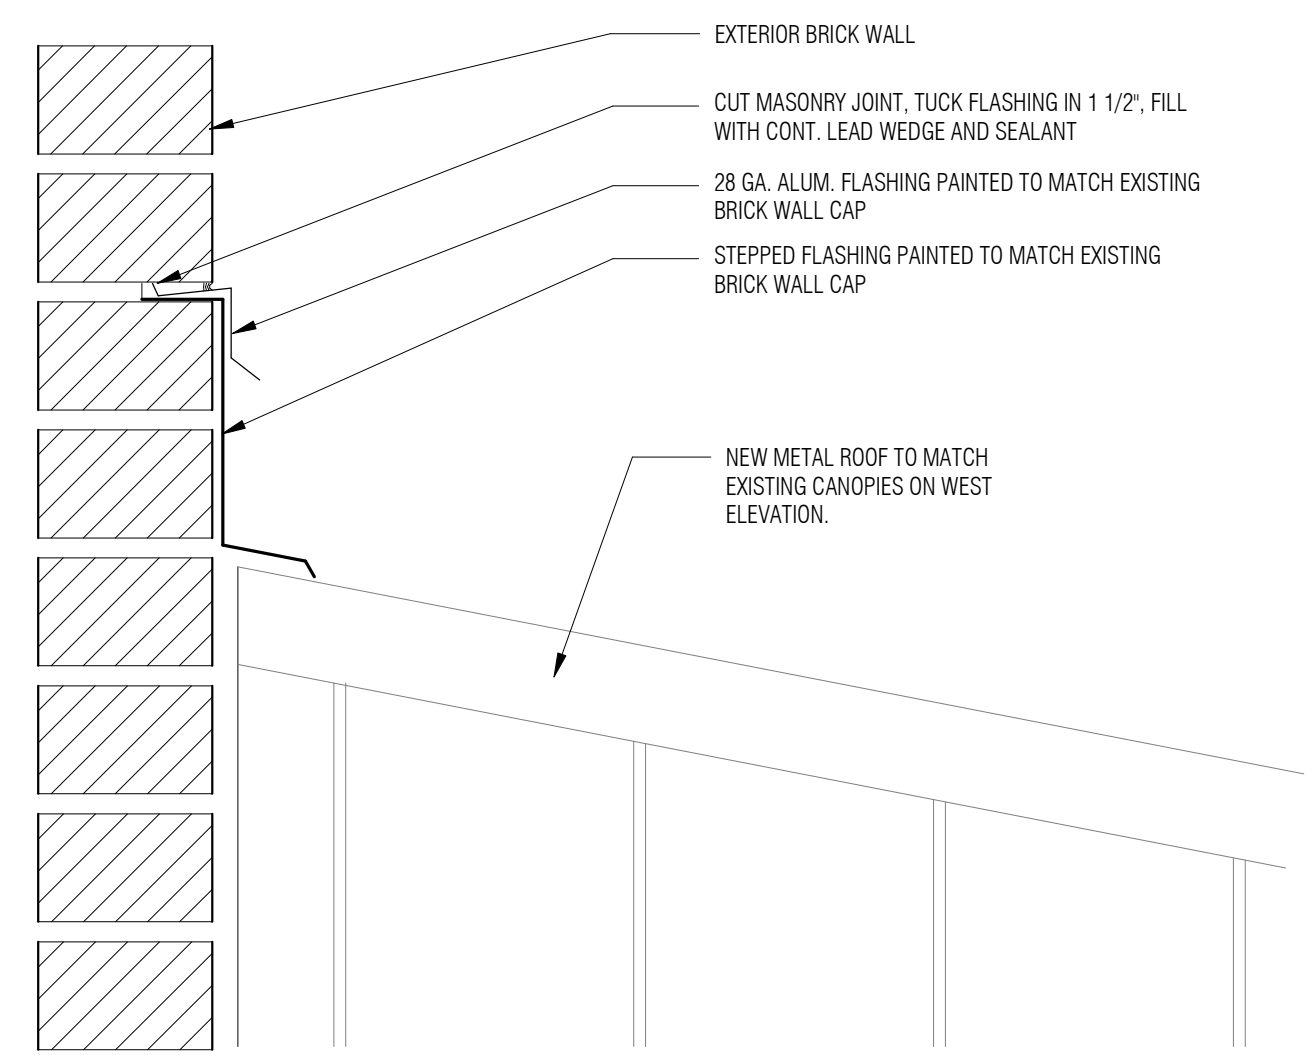

7 HEAD FLASHING AT NEW CANOPY
3\"/>

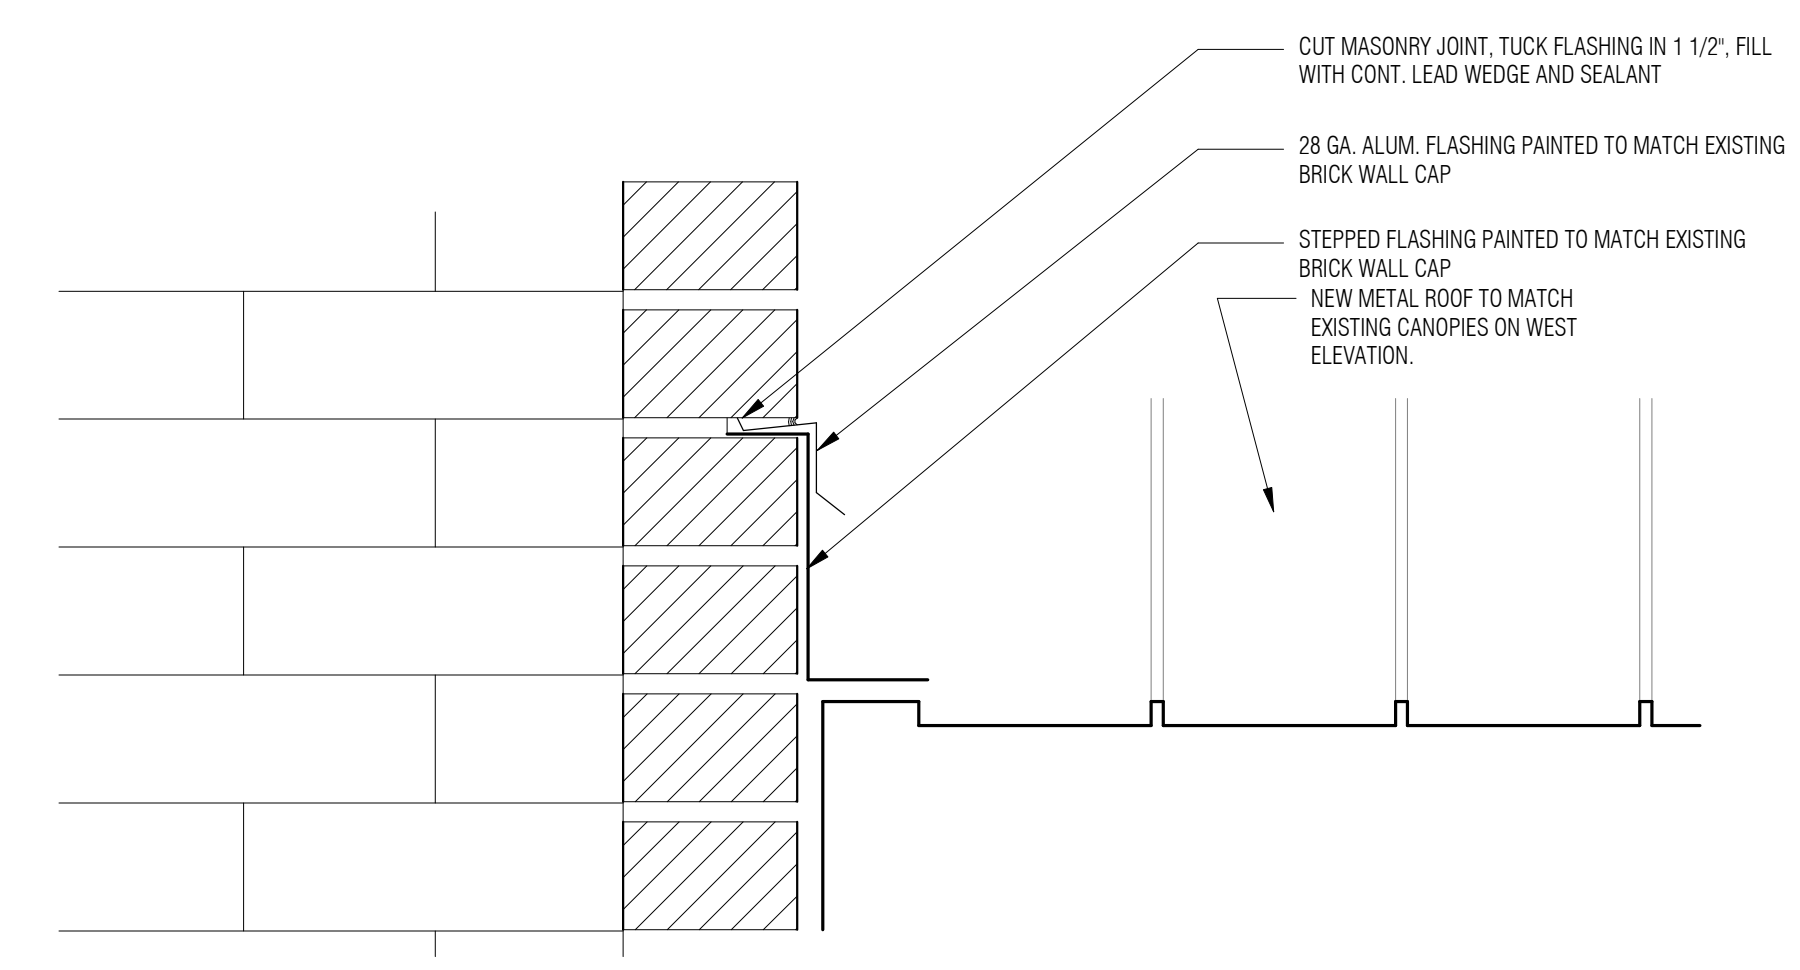

6 COUNTER FLASHING AT CANOPY SIDE WALL
3\"/>

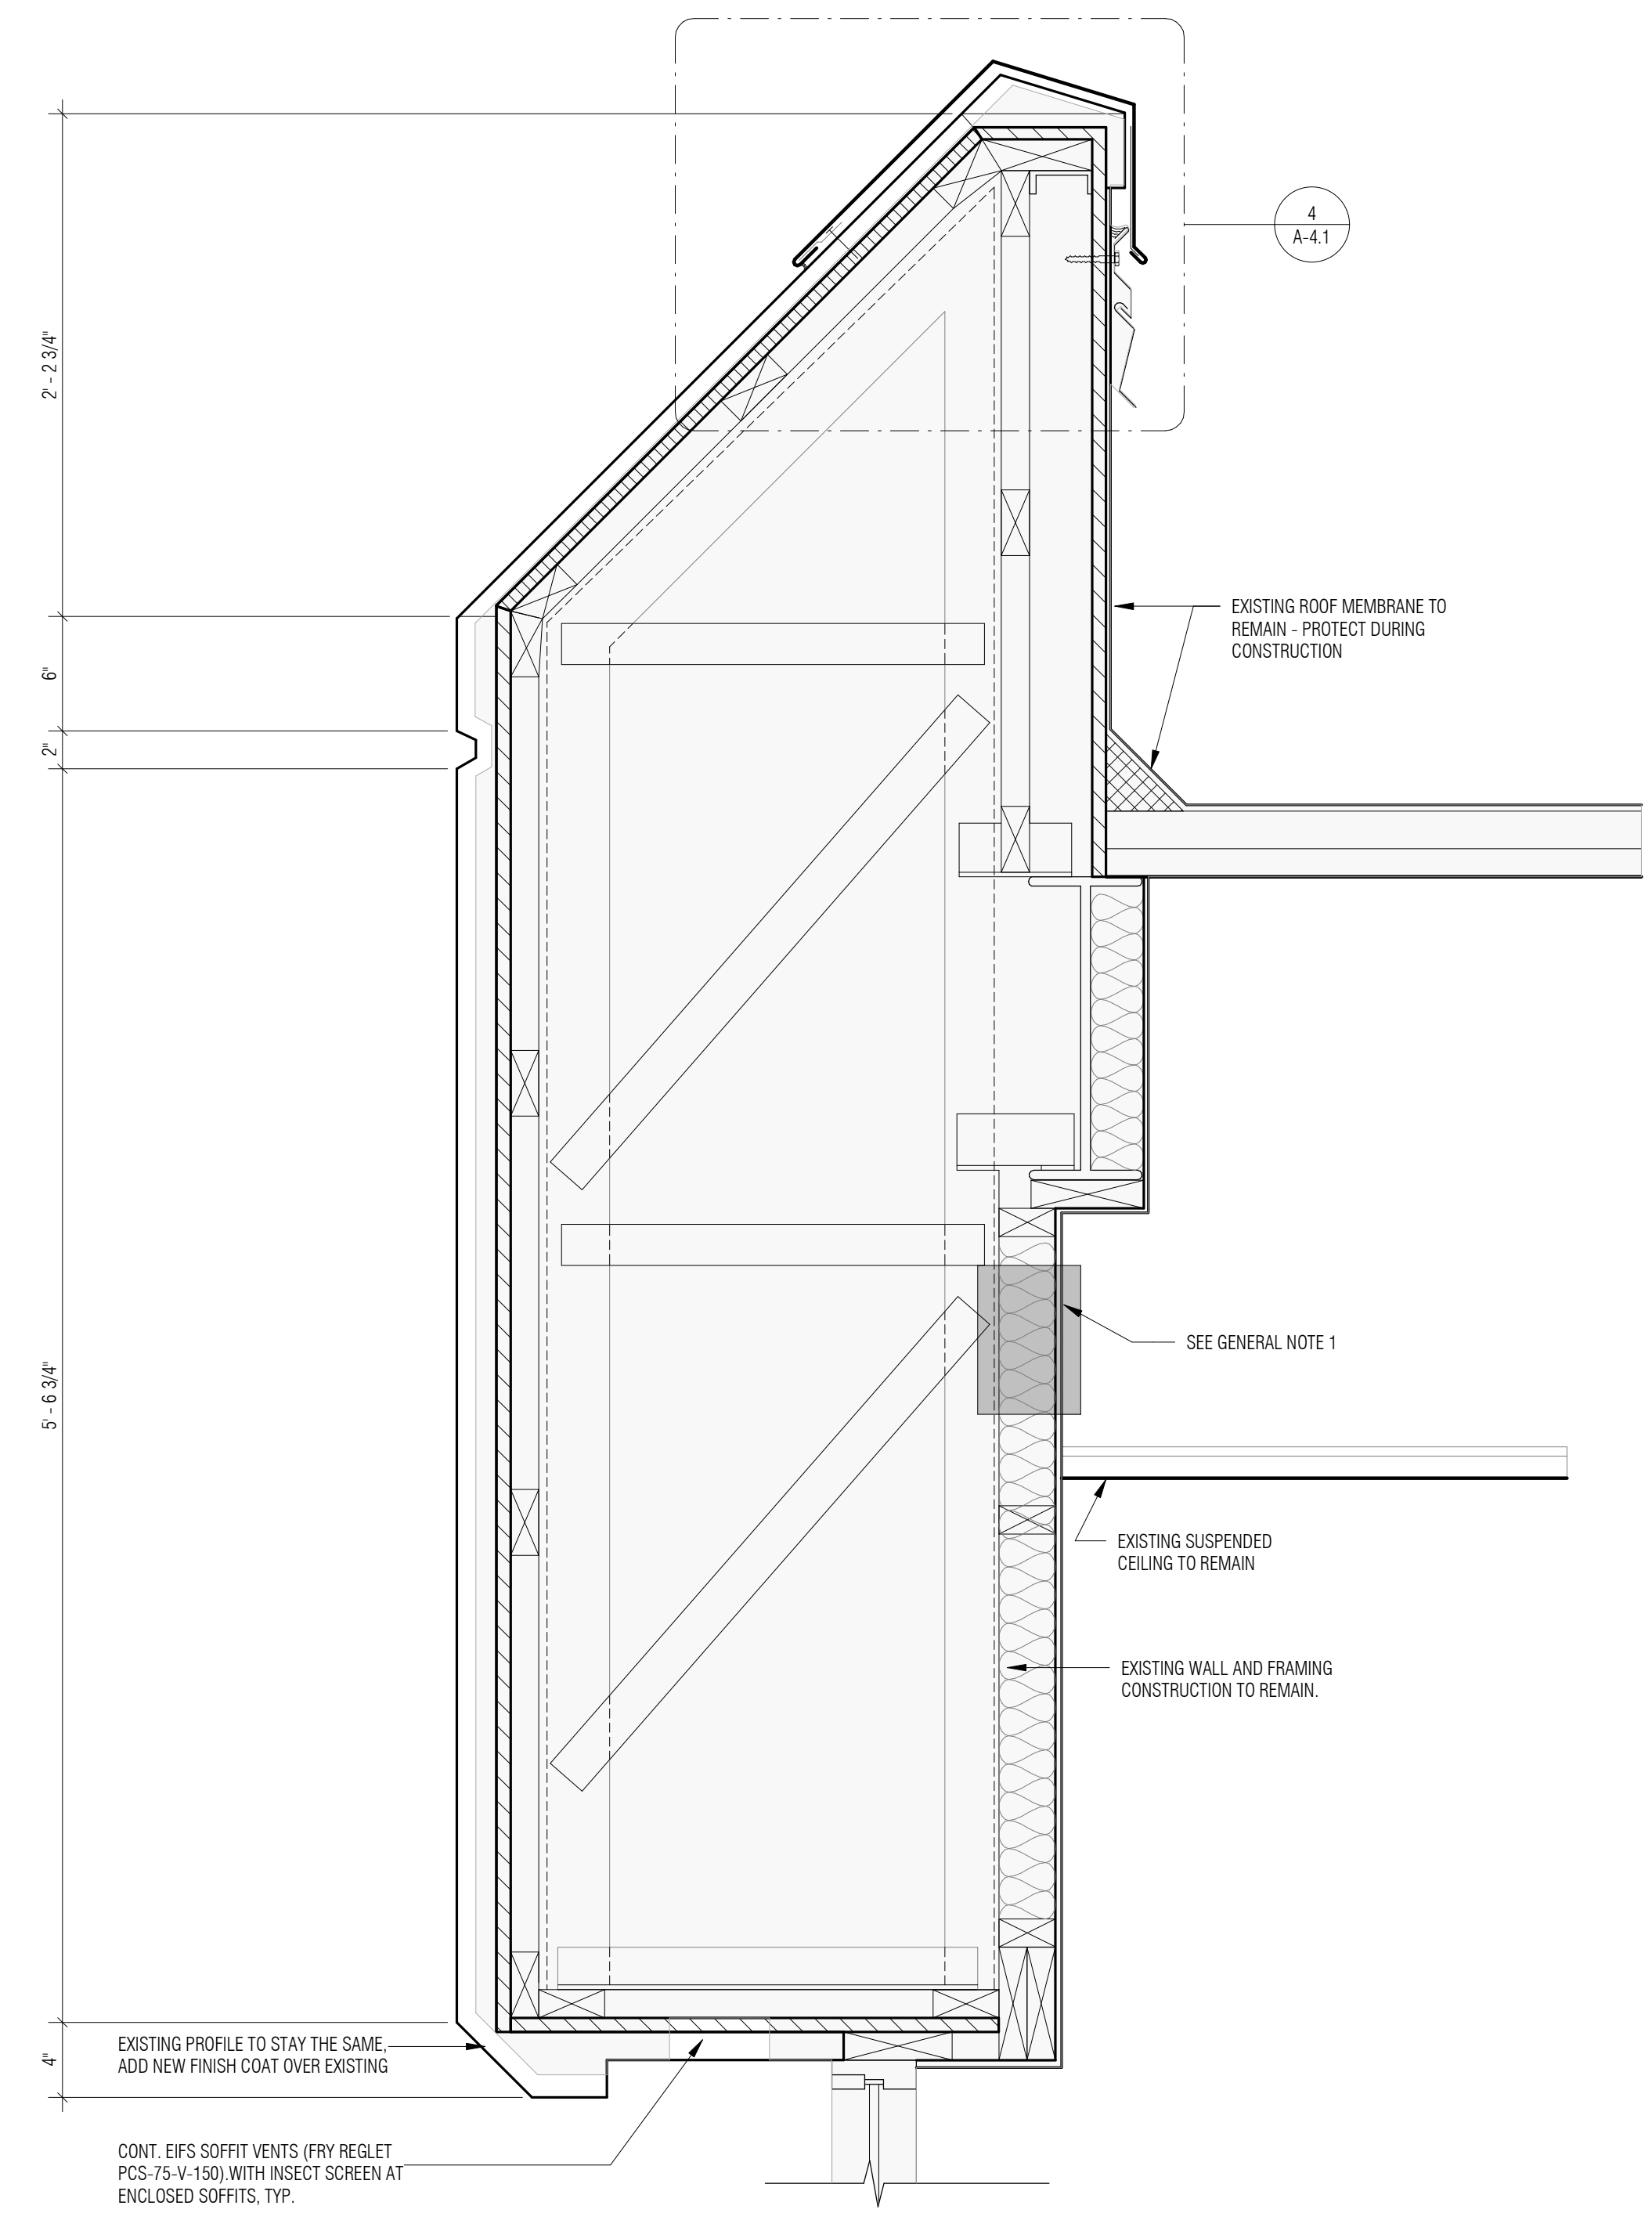

2 SOFFIT DETAIL
1 1/2\"/>


- GENERAL NOTES:**
- G.C. SHALL SPOT INVESTIGATE ENCLOSED CAVITIES FROM THE INTERIOR ABOVE THE CEILING AND SOFFIT BELOW AT EACH WALL WITH ENCLOSED SOFFITS. UPON EXAMINATION IF THERE IS ANY MOLD OR MILDEW FOUND NOTIFY OWNER AND ARCHITECT IMMEDIATELY AND RE-SEAL THE OPENING TO ENSURE NO NEGATIVE EFFECTS OF INDOOR AIR QUALITY INFILTRATE THE BUILDING. IF MOLD, MILDEW OR OTHER UNFORSEEN DAMAGE HAS BEEN DETERMINED THE G.C. CAN PROVIDE A CHANGE ORDER FOR ANY ADDITIONAL RELATED SCOPE OF WORK.
 - CLEANING OF EXISTING EIFS WILL BE PERFORMED WITH A HOSE AND SCRUB BRUSH - NO POWERWASHING. IF SPOTS ARE NOT BECOMING CLEAN USE A MILD DETERGENT ONLY. TEST IN A SMALL AREA AND NOTIFY ARCHITECT IF STAINS PERSIST.
 - ALL EIFS ON EXTERIOR FACADE IS TO BE RE-SURFACED. SEE DETAILS ON A4.1 AND A4.2.
 - ALL EXISTING JOINTS ARE TO REMAIN. IF ANY CRACKING IS NOTED WITHIN EXISTING JOINTS, ADDITIONAL REINFORCING MESH IS REQUIRED PRIOR TO RE-SKIMMING THE SURFACE. IF CRACKING HAS OCCURRED WHERE A JOINT HAS NOT BEEN STRUCK AND ALIGNS WITH AN EXISTING JOINT, PROVIDE A JOINT, MESH AND RE-SKIM THE SURFACE.
 - MAINTAIN EXISTING PROFILE OF EIFS U.N.O.
 - VERIFY ALL MATERIALS ARE INSTALLED IN ACCORDANCE WITH CURRENT INSTALLATION INSTRUCTIONS. ALL TERMINATIONS MUST BE FULLY ENCAPSULATED WITH MESH REINFORCED BASE COAT.
 - PROVIDE A BACK WRAPPED TYPE JOINT WITH BACKER ROD AND SEALANT AT SYSTEM TERMINATION AT SOFFIT / FASCIA TRANSITIONS.
 - REFERENCE KEY PLAN - THIS SHEET FOR EXTENT OF PROPOSED DETAILS.

LEGEND:

	EXISTING TO REMAIN
	NEW WORK

MATERIAL	APPROXIMATE QUANTITY*
METAL ROOF COPING	575 LF
EIFS SURFACE	~5,700 sf
BRIDGE FARGE COAT	~1,300 sf
EIFS SOFFIT VENT	~350 LF


*NOTE: QUANTITIES ARE APPROXIMATE. G.C. IS TO VERIFY.

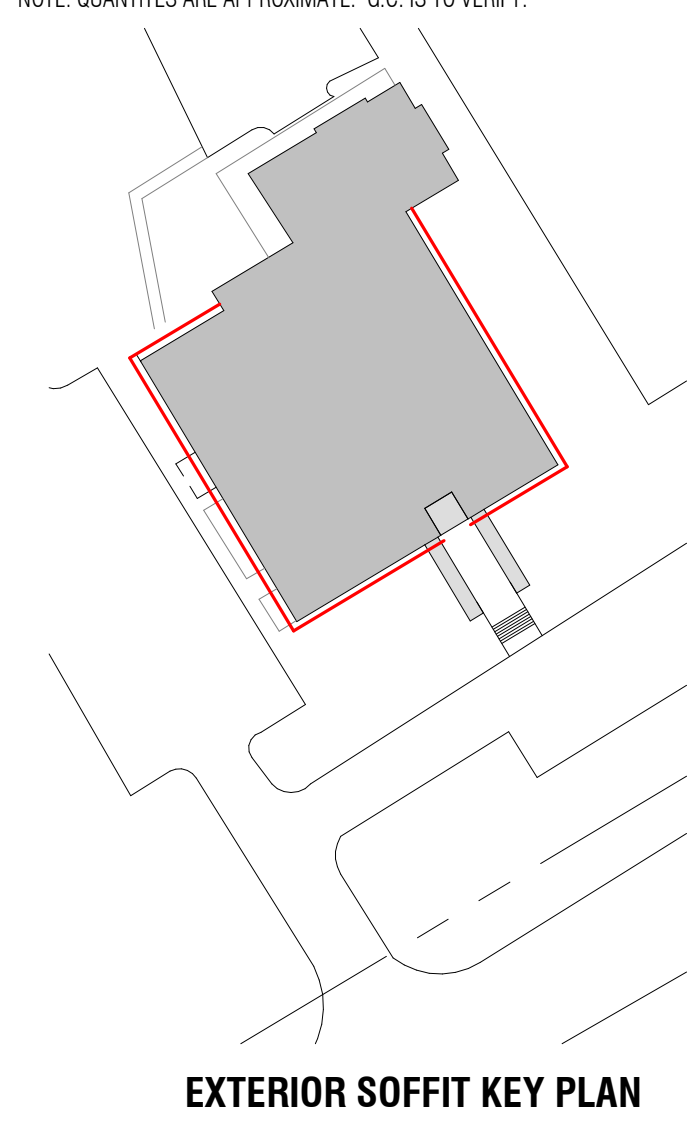


EXTERIOR SOFFIT KEY PLAN




G.C. TO PATCH AND REPAIR PARGE COAT ON CONCRETE WALLS IN KIND. IMAGES BELOW NOTE AREAS IN NEED BUT FURTHER INVESTIGATION IS NEEDED TO REPAIR DELAMINATING PARGE COAT.

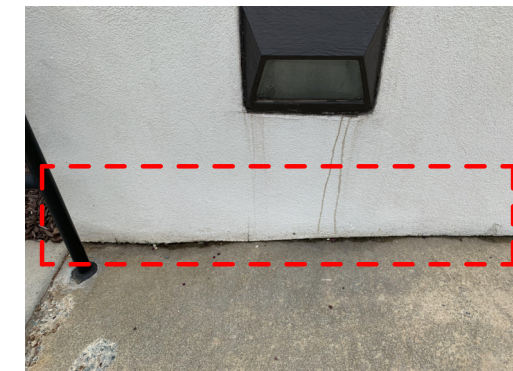

PARGE IMAGE 1

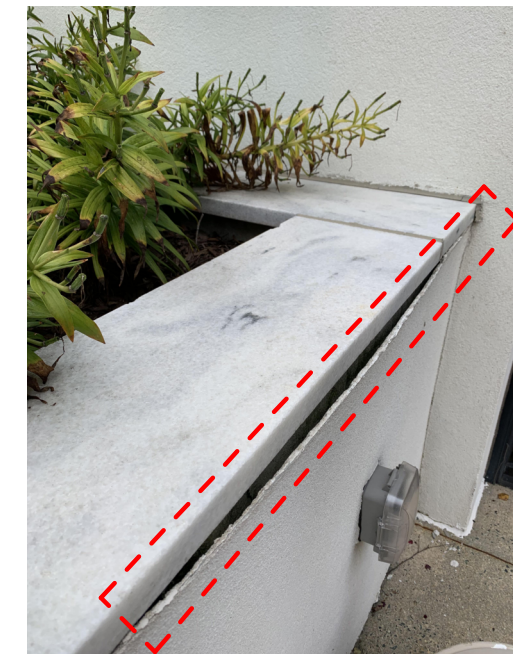

PARGE IMAGE 2

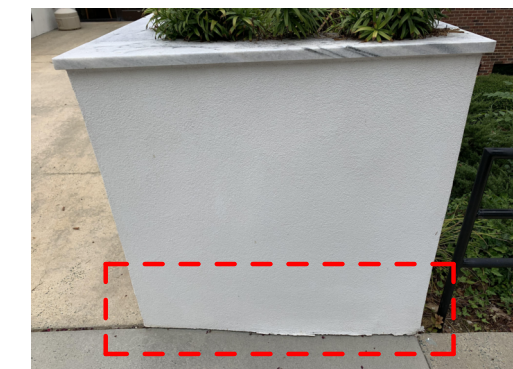

PARGE IMAGE 3



PARGE IMAGE 4




PARGE IMAGE 5 - PARGE COAT REPAIR WITHIN EXISTING PLANTERS

REMOVE DRAIN PIPE
EXISTING OVERFLOW DRAIN TO REMAIN

REMOVE SCUPPER BOX AND DOWNSPOUT. INSTALL PIPE DRAIN SIMILAR TO OVERFLOW. PATCH AND GROUT AS NECESSARY AND REFINISH


G.C. TO REMOVE ENTIRETY OF PARGE COAT WITHIN PLANTERS PRIOR TO INSTALLING NEW FLUID APPLIED MEMBRANE.

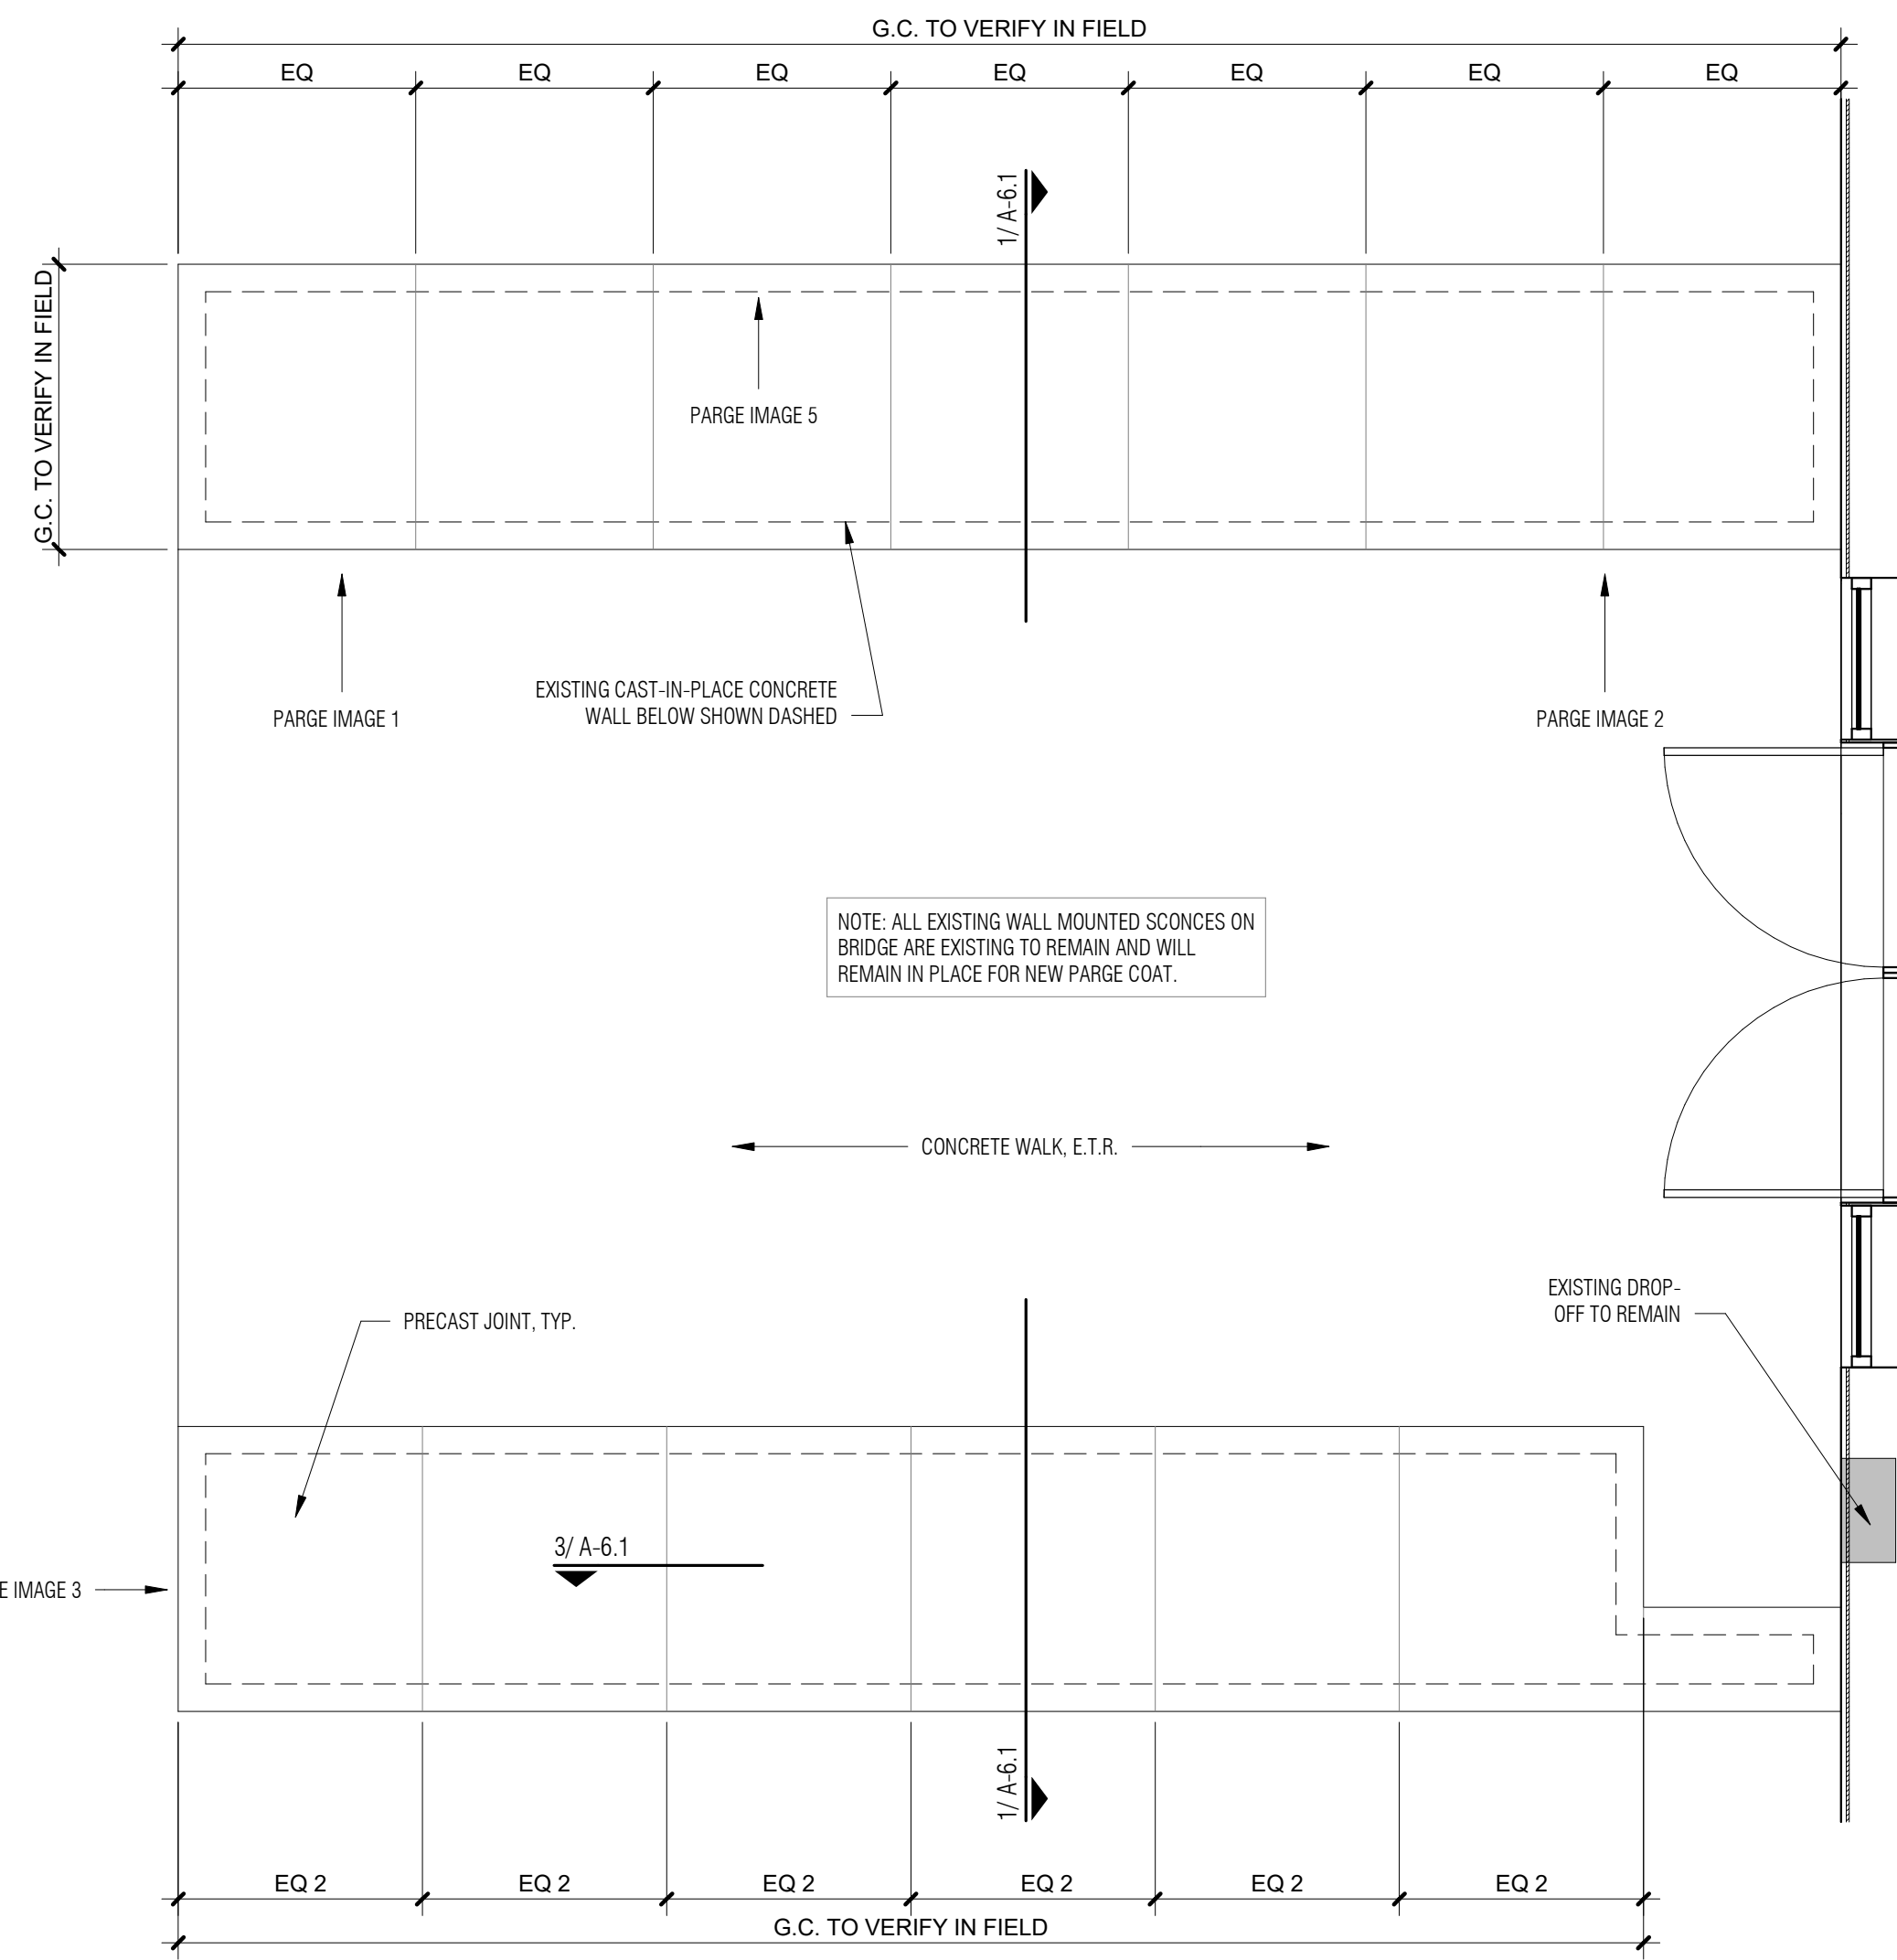

2 PLAN DETAIL @ ENTRY PLANTERS
3/8" = 1'-0"

MATERIAL	APPROXIMATE QUANTITY*
METAL ROOF COPING	575 LF
EIFS SURFACE	~5,700 sq ft
BRIDGE PARGE COAT	~1,300 sq ft
EIFS SOFFIT VENT	~350 LF


*NOTE: QUANTITIES ARE APPROXIMATE. G.C. IS TO VERIFY.

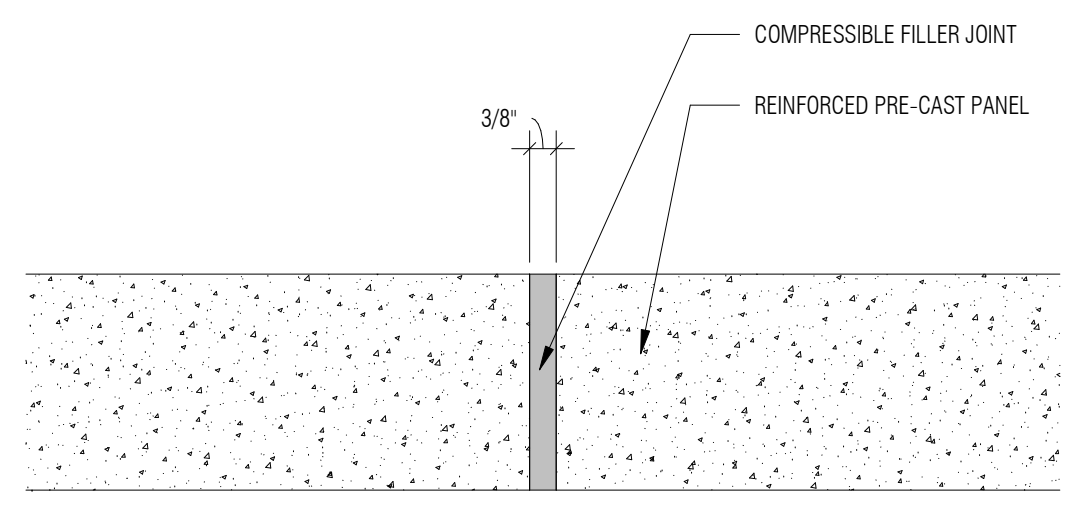

3 PRE-CAST TOP JOINT DETAIL
3" = 1'-0"

PLANTER GENERAL NOTES:
1. ALL SOIL AND PLANTINGS ARE TO BE REMOVED AND DISPOSED. REMOVE ALL INTERIOR PARGE COAT ON PLANTERS. ENSURE PROPER ADHESION OF NEW FLUID APPLIED MEMBRANE. PROVIDE ADEQUATE VENTING AS REQUIRED PRIOR TO INSTALLATION OF FLUID APPLIED MEMBRANE AS SEEN ON THIS DETAIL.
2. REMOVE AND RETURN ALL SALVAGEABLE EXISTING MARBLE STONE CAP TO OWASA.

PROVIDE DRIP AT UNDERSIDE OF PRECAST TOP
REINFORCED PRECAST CONCRETE TOP TO BE INSTALLED WITH DOWEL AND EPOXY. TYP., MIN. (4) DOWELS PER CAP AND 1" MIN. EMBED IN CAP AND WALL
EXISTING CAST IN PLACE CONCRETE WALLS TO REMAIN
NEW FLUID APPLIED MEMBRANE AROUND ENTIRETY OF EXISTING PLANTERS, TYP.

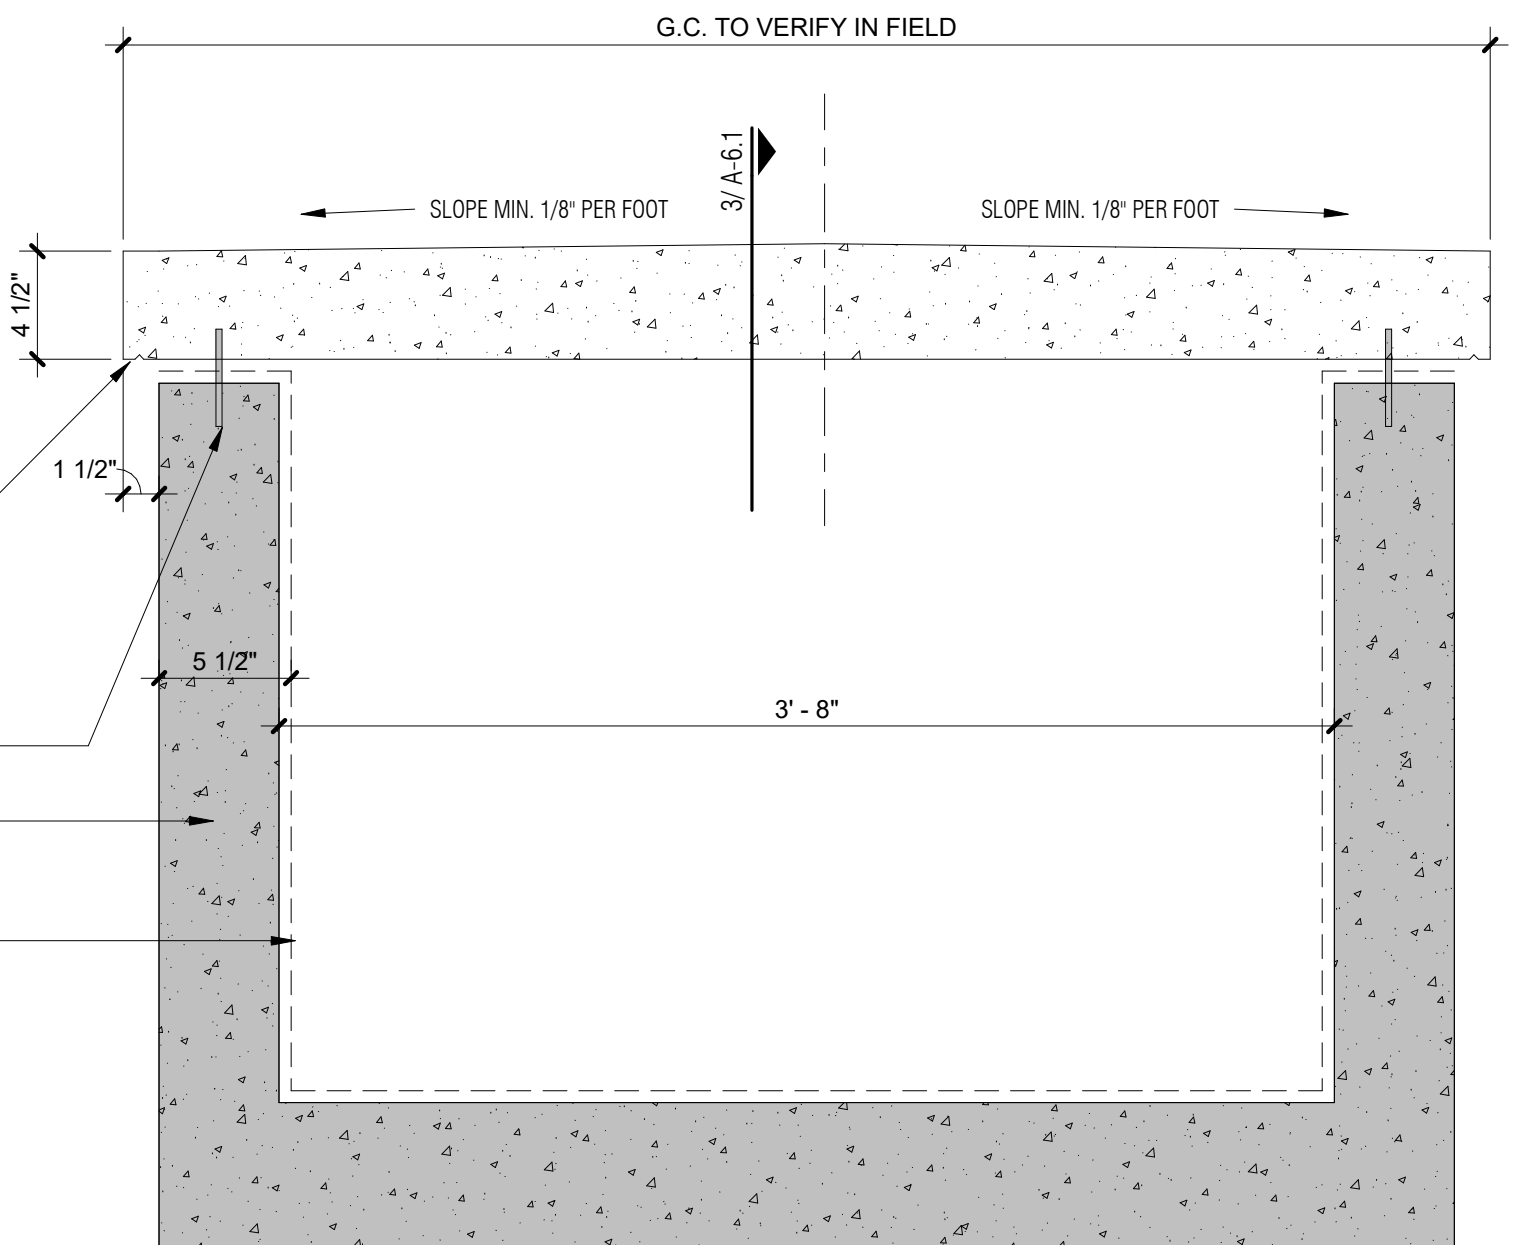

1 SECTION DETAIL @ PLANTER
1 1/2" = 1'-0"

11.08.23 PRE-BID AGENDA

OWASA ADMINISTRATION BLDG. COPING & EIFS IMPROVEMENTS CIP #280-17

1. Introductions
 - a. Introductions: name, affiliation, role during project
 - b. Circulate sign-in sheet
2. Correspondence
 - a. All questions to be directed to Brad Barber (bbarber@owasa.org). An addenda of questions asked with responses will be sent to all bidders.
3. Schedule
 - a. Bids Due: **Monday December 4, 2023 by 2pm** (This is an informal project – so there will be no public meeting to open bids)
 - b. No more questions by **November 22, 2023** after 5pm. All questions need to be submitted in writing – email is fine.
 - c. Project Duration 90 days from Notice to Proceed (Project to be at substantial completion at 60 consecutive calendar days)
4. Weather Delays
 - a. Agreement Form – Lump Sum Single Prime Contract Item 4.05 – G.C. requests for weather related delays to be made in writing and reference to the table indicated of expected number of days with 0.1 or more inches of precipitation.
5. Working on Holidays
 - a. Agreement Form – Lump Sum Single Prime Contract Item 4.06 – G.C. must notify Brad Barber by 3:30pm, (3) days in advance of the day of the contractor's request to work on a specific Saturday, Sunday or Holiday.
6. Contingency Allowance
 - a. Provide a line item for a contingency allowance of \$25,000.
7. OWASA Site Logistics
 - a. OWASA procedures
 - b. Lay Down Area
 - c. Required Work Plan and Diagram to keep all entries and exits operational during construction.
 - d. Keep site clean
8. Overview of drawings
 - a. G.C. to provide necessary protection of exterior building envelope in the case of inclement weather.

- b. G.C. shall spot investigate enclosed cavities from the interior above the ceiling and soffit below at each wall with enclosed soffits. Upon examination if there is any mold or mildew found notify owner and architect immediately and re-seal the opening to ensure no negative effects of indoor air quality infiltrate the building.
- c. Note specific EIFS details are indicated in respective key plans

9. Site Walk

10. Outstanding Questions?

O.W.A.S.A. OPERATIONS CENTER

JONES FERRY ROAD
CARRBORO, NORTH CAROLINA




FOR REFERENCE ONLY


INDEX OF DRAWINGS

- 1-A SITE GRADING & UTILITY PLAN
- 1-A-1 SANITARY SEWER LINE & PROFILE
- 1-B EROSION CONTROL PLAN
- 1-C SITE STAKING PLAN
- 1-D LANDSCAPE PLAN
- 1-E SITE DETAILS
- 2 LOWER LEVEL FLOOR PLAN
- 3 UPPER LEVEL FLOOR PLAN
- 4 FLOOR PLAN AT WAREHOUSE - BRIDGE DETAILS
- 5 ROOF PLAN, DETAILS
- 6 EXTERIOR ELEVATIONS
- 7 EXTERIOR ELEVATIONS
- 8 INTERIOR ELEVATIONS
- 9 LONGITUDINAL SECTION AND STAIR AND RAILING DETAILS
- 10 DETAIL SECTIONS
- 11 DETAIL SECTIONS
- 12 DETAIL SECTIONS
- 13 ALUMINUM WINDOW AND DOOR DETAILS
- 14 ALUMINUM WINDOW AND DOOR DETAILS, SKYLIGHT DETAILS
- 15 FINISH SCHEDULES
- 16 LOWER LEVEL REFLECTED CEILING PLAN
- 17 UPPER LEVEL REFLECTED CEILING PLAN
- 18 REFLECTED CEILING PLAN AT WAREHOUSE
- S-1 FOUNDATION PLAN AND DETAILS
- S-2 FLOOR FRAMING PLAN AND DETAILS

- S-3 ROOF FRAMING PLAN AND DETAILS
- P-1 PLUMBING DETAILS AND RISER DIAGRAM
- P-2 LOWER LEVEL FLOOR PLAN - PLUMBING WASTE AND VENT
- P-3 UPPER LEVEL FLOOR PLAN - PLUMBING WASTE AND VENT
- SP-1 LOWER LEVEL FLOOR PLAN - SPRINKLER SYSTEM
- SP-2 UPPER LEVEL FLOOR PLAN - SPRINKLER SYSTEM
- SP-3 WAREHOUSE FLOOR PLAN - SPRINKLER SYSTEM
- M-1 H V A C SCHEDULES
- M-2 H V A C DETAILS
- M-3 LOWER LEVEL PLAN - HEATING AND AIR CONDITIONING
- M-4 UPPER LEVEL PLAN - HEATING AND AIR CONDITIONING
- M-5 H V A C WAREHOUSE PLAN AND MECH. EQUIP. ROOM PLAN
- M-6 LOWER LEVEL FLOOR PLAN - HYDRONIC PIPING SYSTEM
- M-7 UPPER LEVEL FLOOR PLAN - HYDRONIC PIPING SYSTEM
- M-8 H V A C DETAILS
- M-9 H V A C CONTROLS
- E-1 ELECTRICAL SCHEDULES
- E-2 LOWER LEVEL FLOOR PLAN - LIGHTING
- E-3 UPPER LEVEL FLOOR PLAN - LIGHTING
- E-4 WAREHOUSE FLOOR PLAN - LIGHTING AND POWER
- E-5 LOWER LEVEL FLOOR PLAN - POWER AND COMMUNICATION
- E-6 UPPER LEVEL FLOOR PLAN - POWER AND COMMUNICATION
- E-7 PANELBOARD SCHEDULES

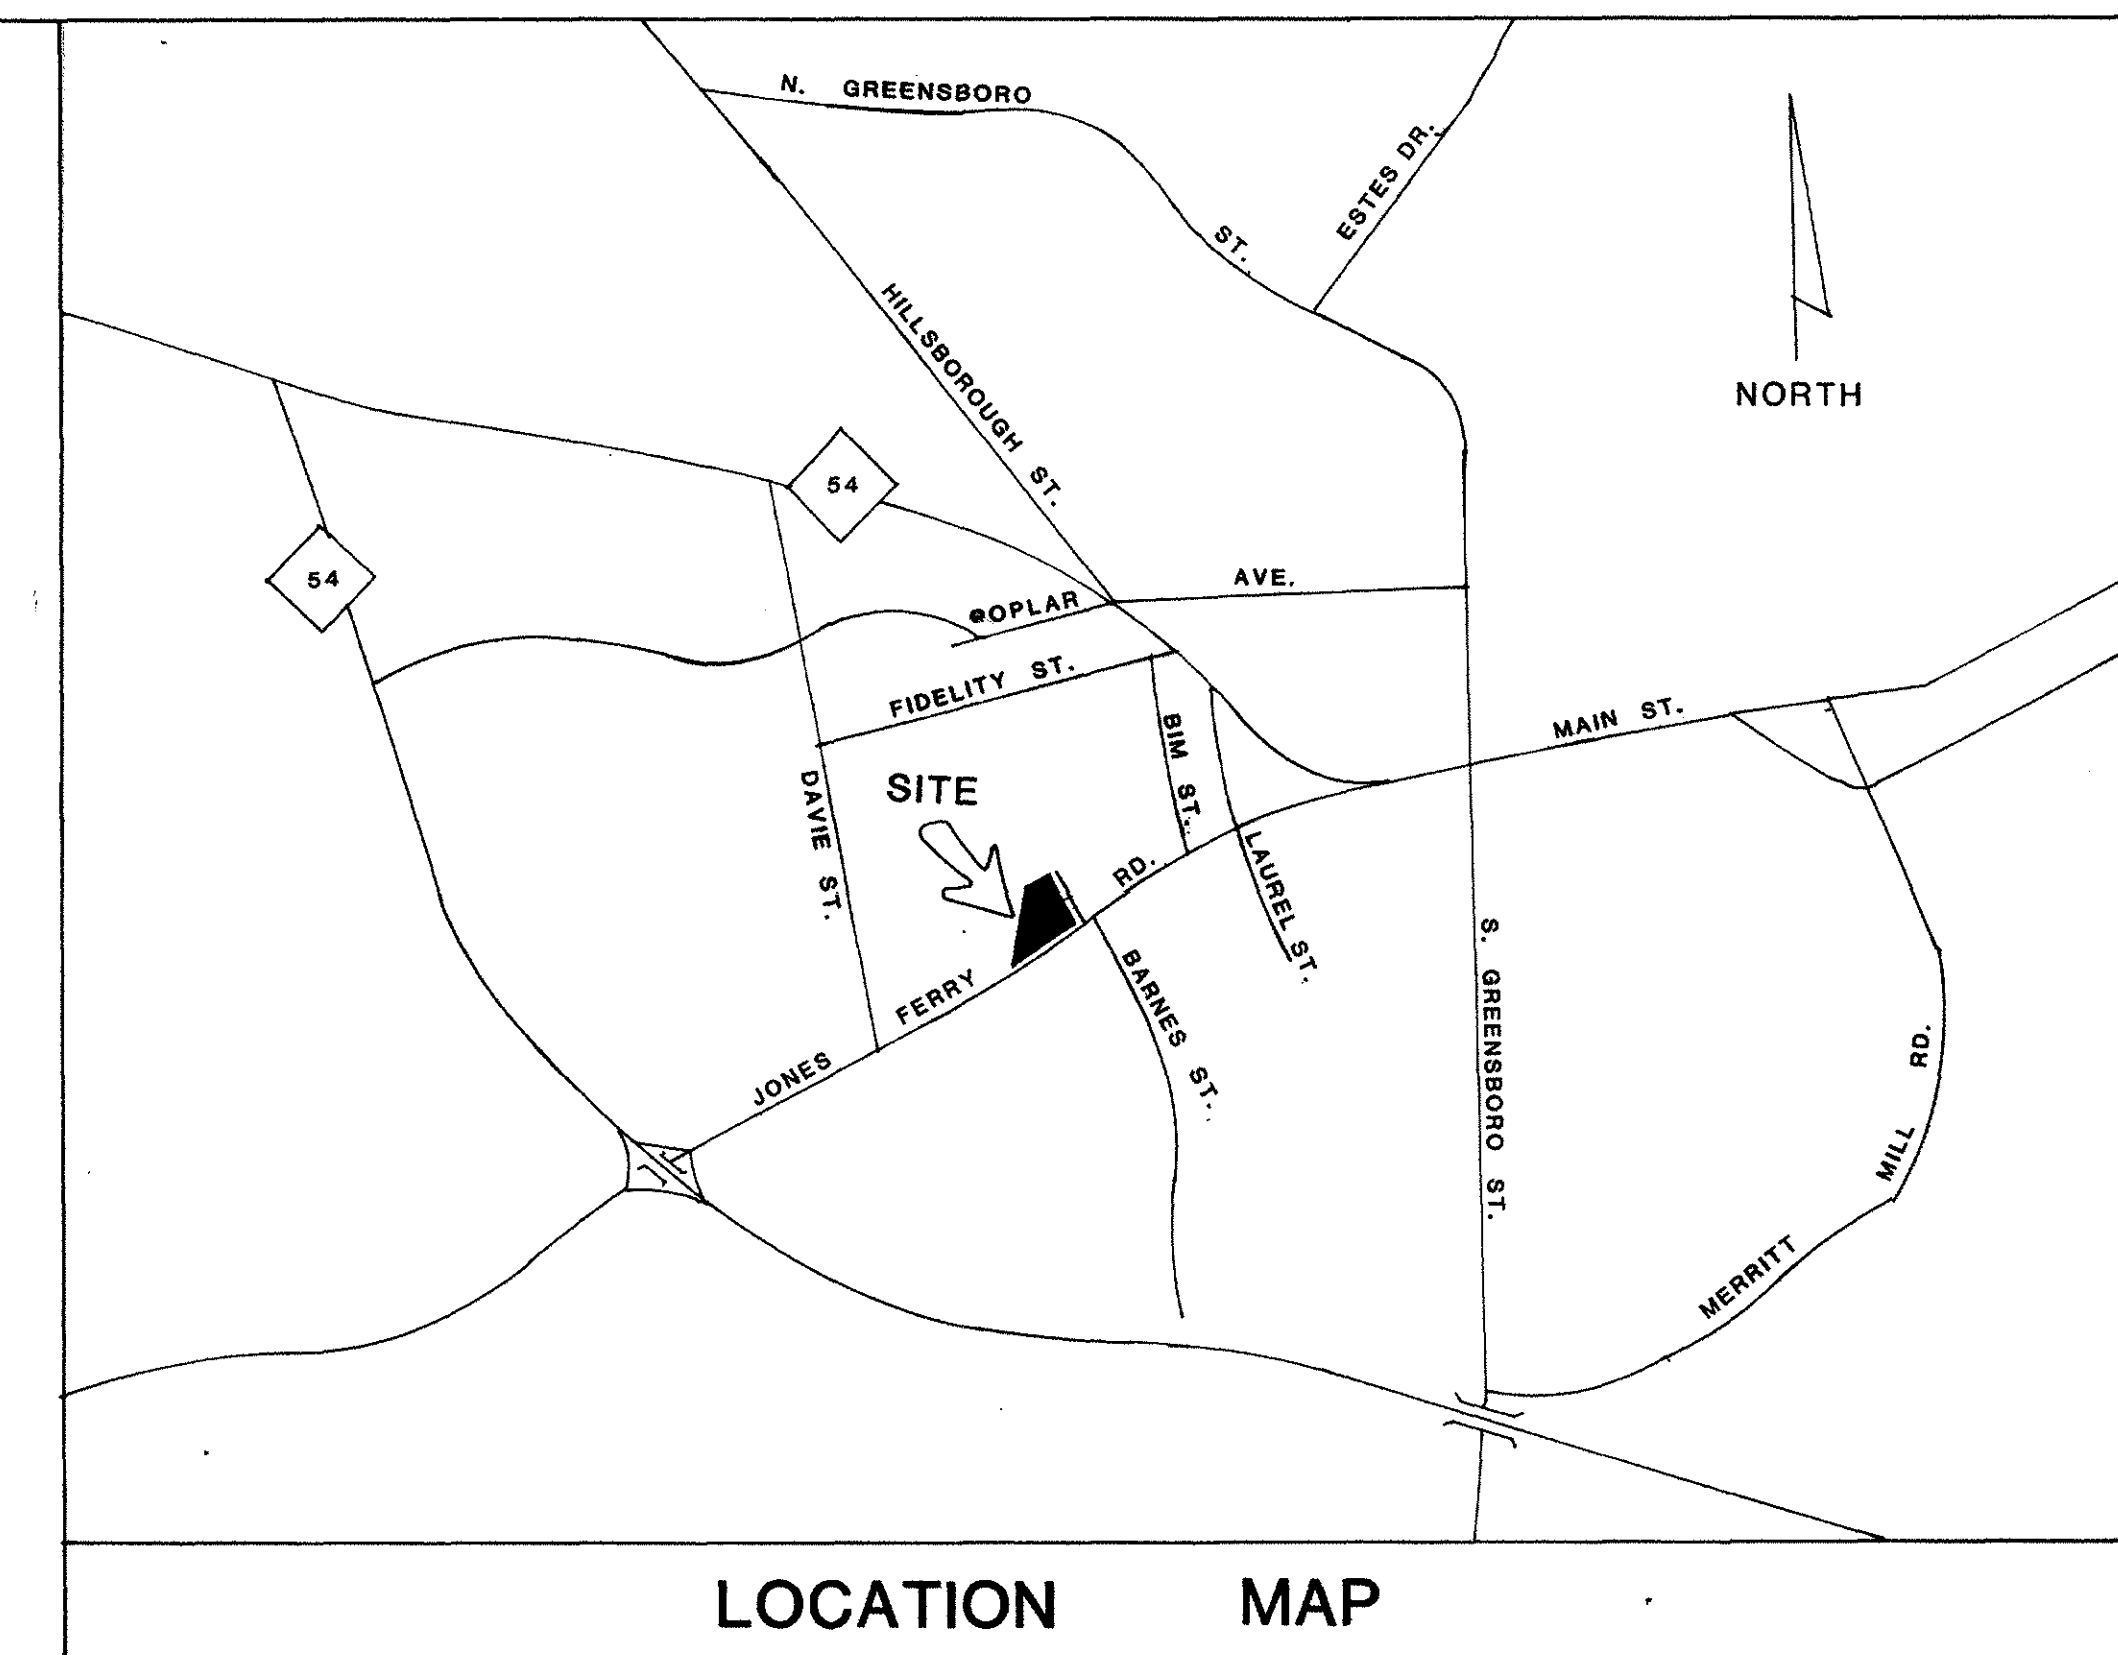

LOCATION MAP

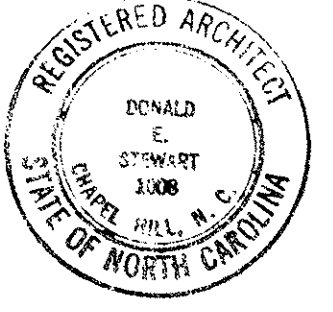

CP&AA
architects
chapel hill, n.c.

city planning and architectural associates
planners
919/939-7128

DATE: DECEMBER 1988
DRAWN BY:
CHECKED BY:

O.W.A.S.A. OPERATIONS CENTER
CARRBORO, NORTH CAROLINA

The use of these plans and specifications shall be restricted to the original site indicated. They may not be reproduced, copied, or published in any form without the written consent of the architect. This is to be understood in whole or in part. It is prohibited. This is to be understood in whole or in part. It is prohibited. This is to be understood in whole or in part. It is prohibited. This is to be understood in whole or in part. It is prohibited.

job no. 548
sheet no.

AS BUILT 8/17/90




city planning and architectural associates
architects : planners
chapel hill, n.c.
no/100-101

DATE: DECEMBER, 1988
DRAWN BY:
CHECKED BY:

O.W.A.S.A. OPERATIONS CENTER
CARRBORO, NORTH CAROLINA
LOWER LEVEL FLOOR PLAN

This set of plans and specifications shall be construed in accordance with the standard practice of the building industry for which they were prepared and published. No amendments shall be made to these specifications or plans. The contractor shall be responsible for obtaining all necessary permits and for complying with all applicable laws, codes and regulations. The contractor shall be responsible for obtaining all necessary approvals and for complying with all applicable laws, codes and regulations. The contractor shall be responsible for obtaining all necessary approvals and for complying with all applicable laws, codes and regulations.

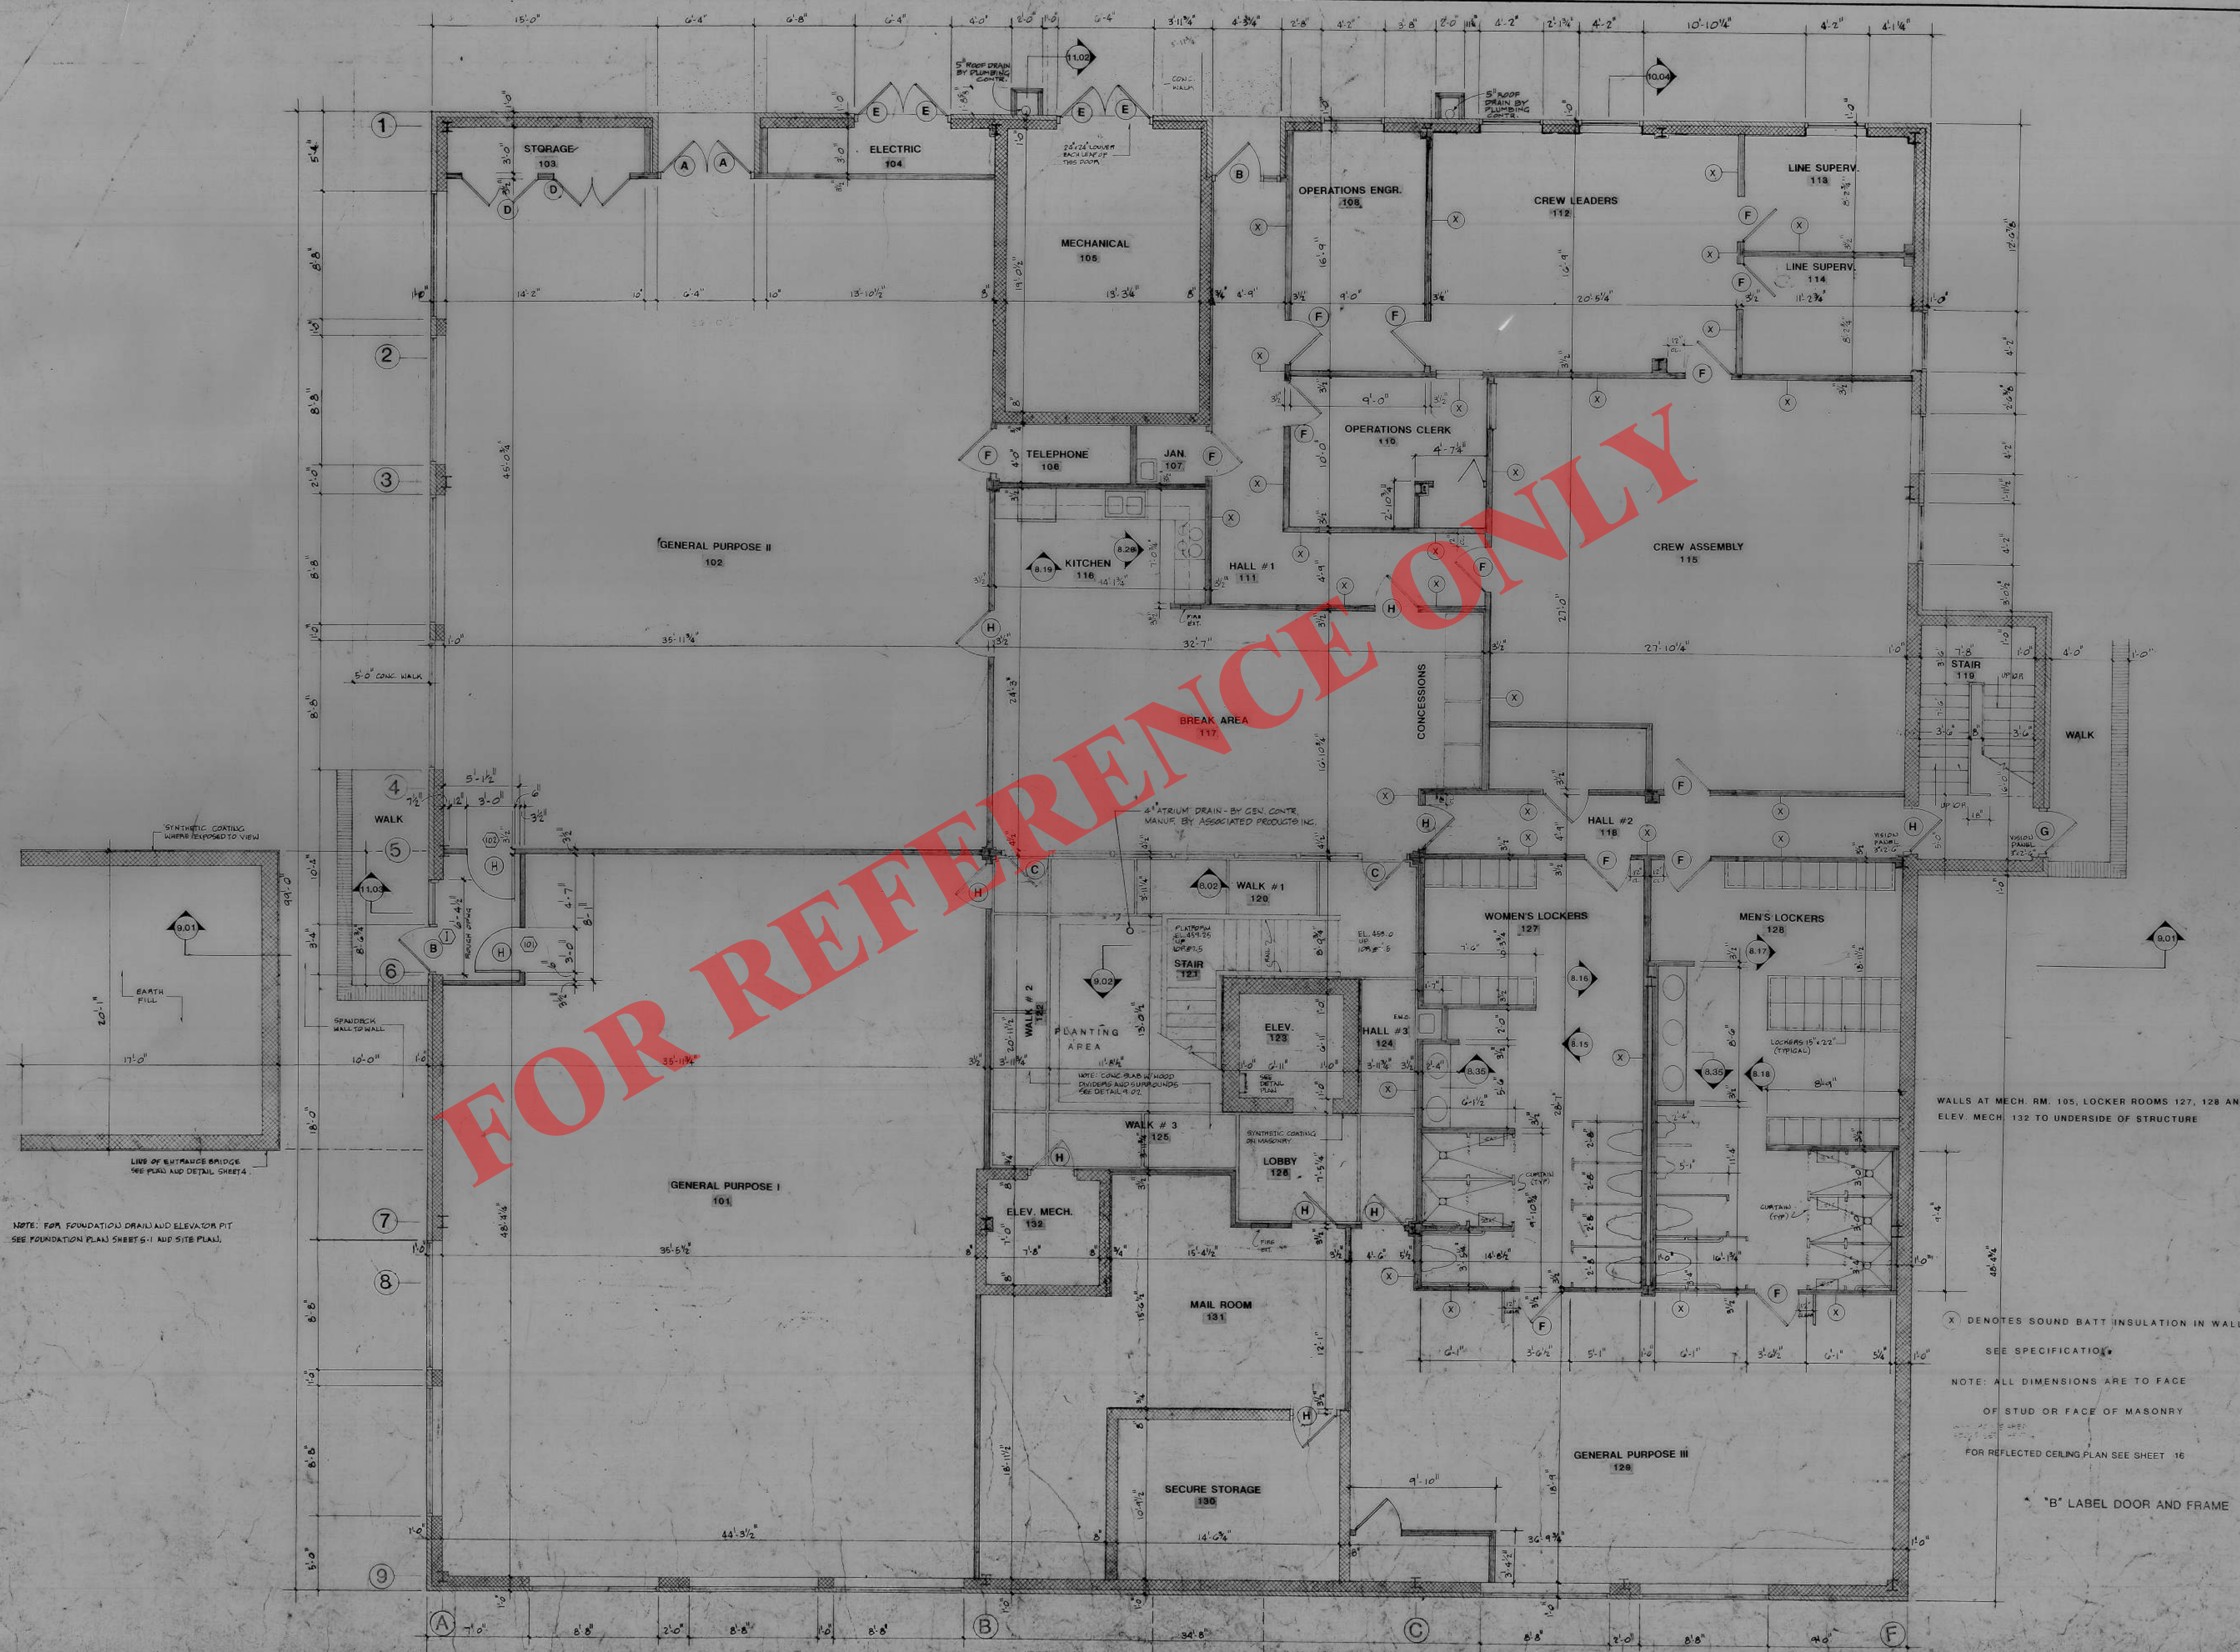


FOR REFERENCE ONLY

NOTE: FOR FOUNDATION DRAIN AND ELEVATOR PIT SEE FOUNDATION PLAN SHEET 5-1 AND SITE PLAN.


X DENOTES SOUND BATT INSULATION IN WALL
SEE SPECIFICATIONS
NOTE: ALL DIMENSIONS ARE TO FACE
OF STUD OR FACE OF MASONRY
FOR REFLECTED CEILING PLAN SEE SHEET 16
* B LABEL DOOR AND FRAME

LOWER LEVEL FLOOR PLAN
SCALE 1/4" = 1'-0"

PLAN DETAIL 3.01

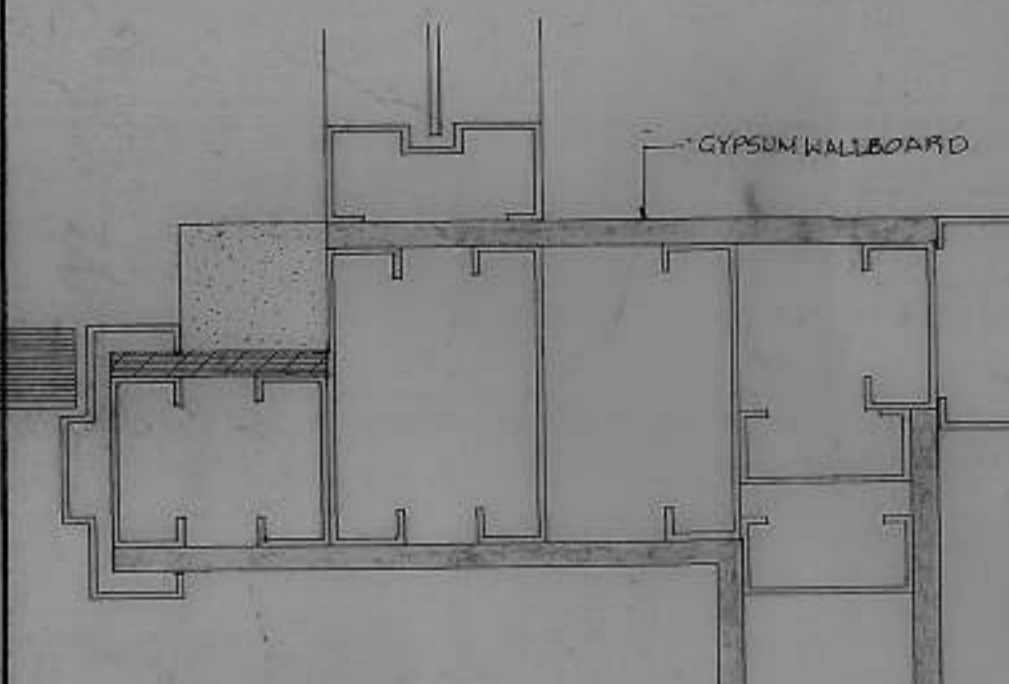

PLAN DETAIL 3.02

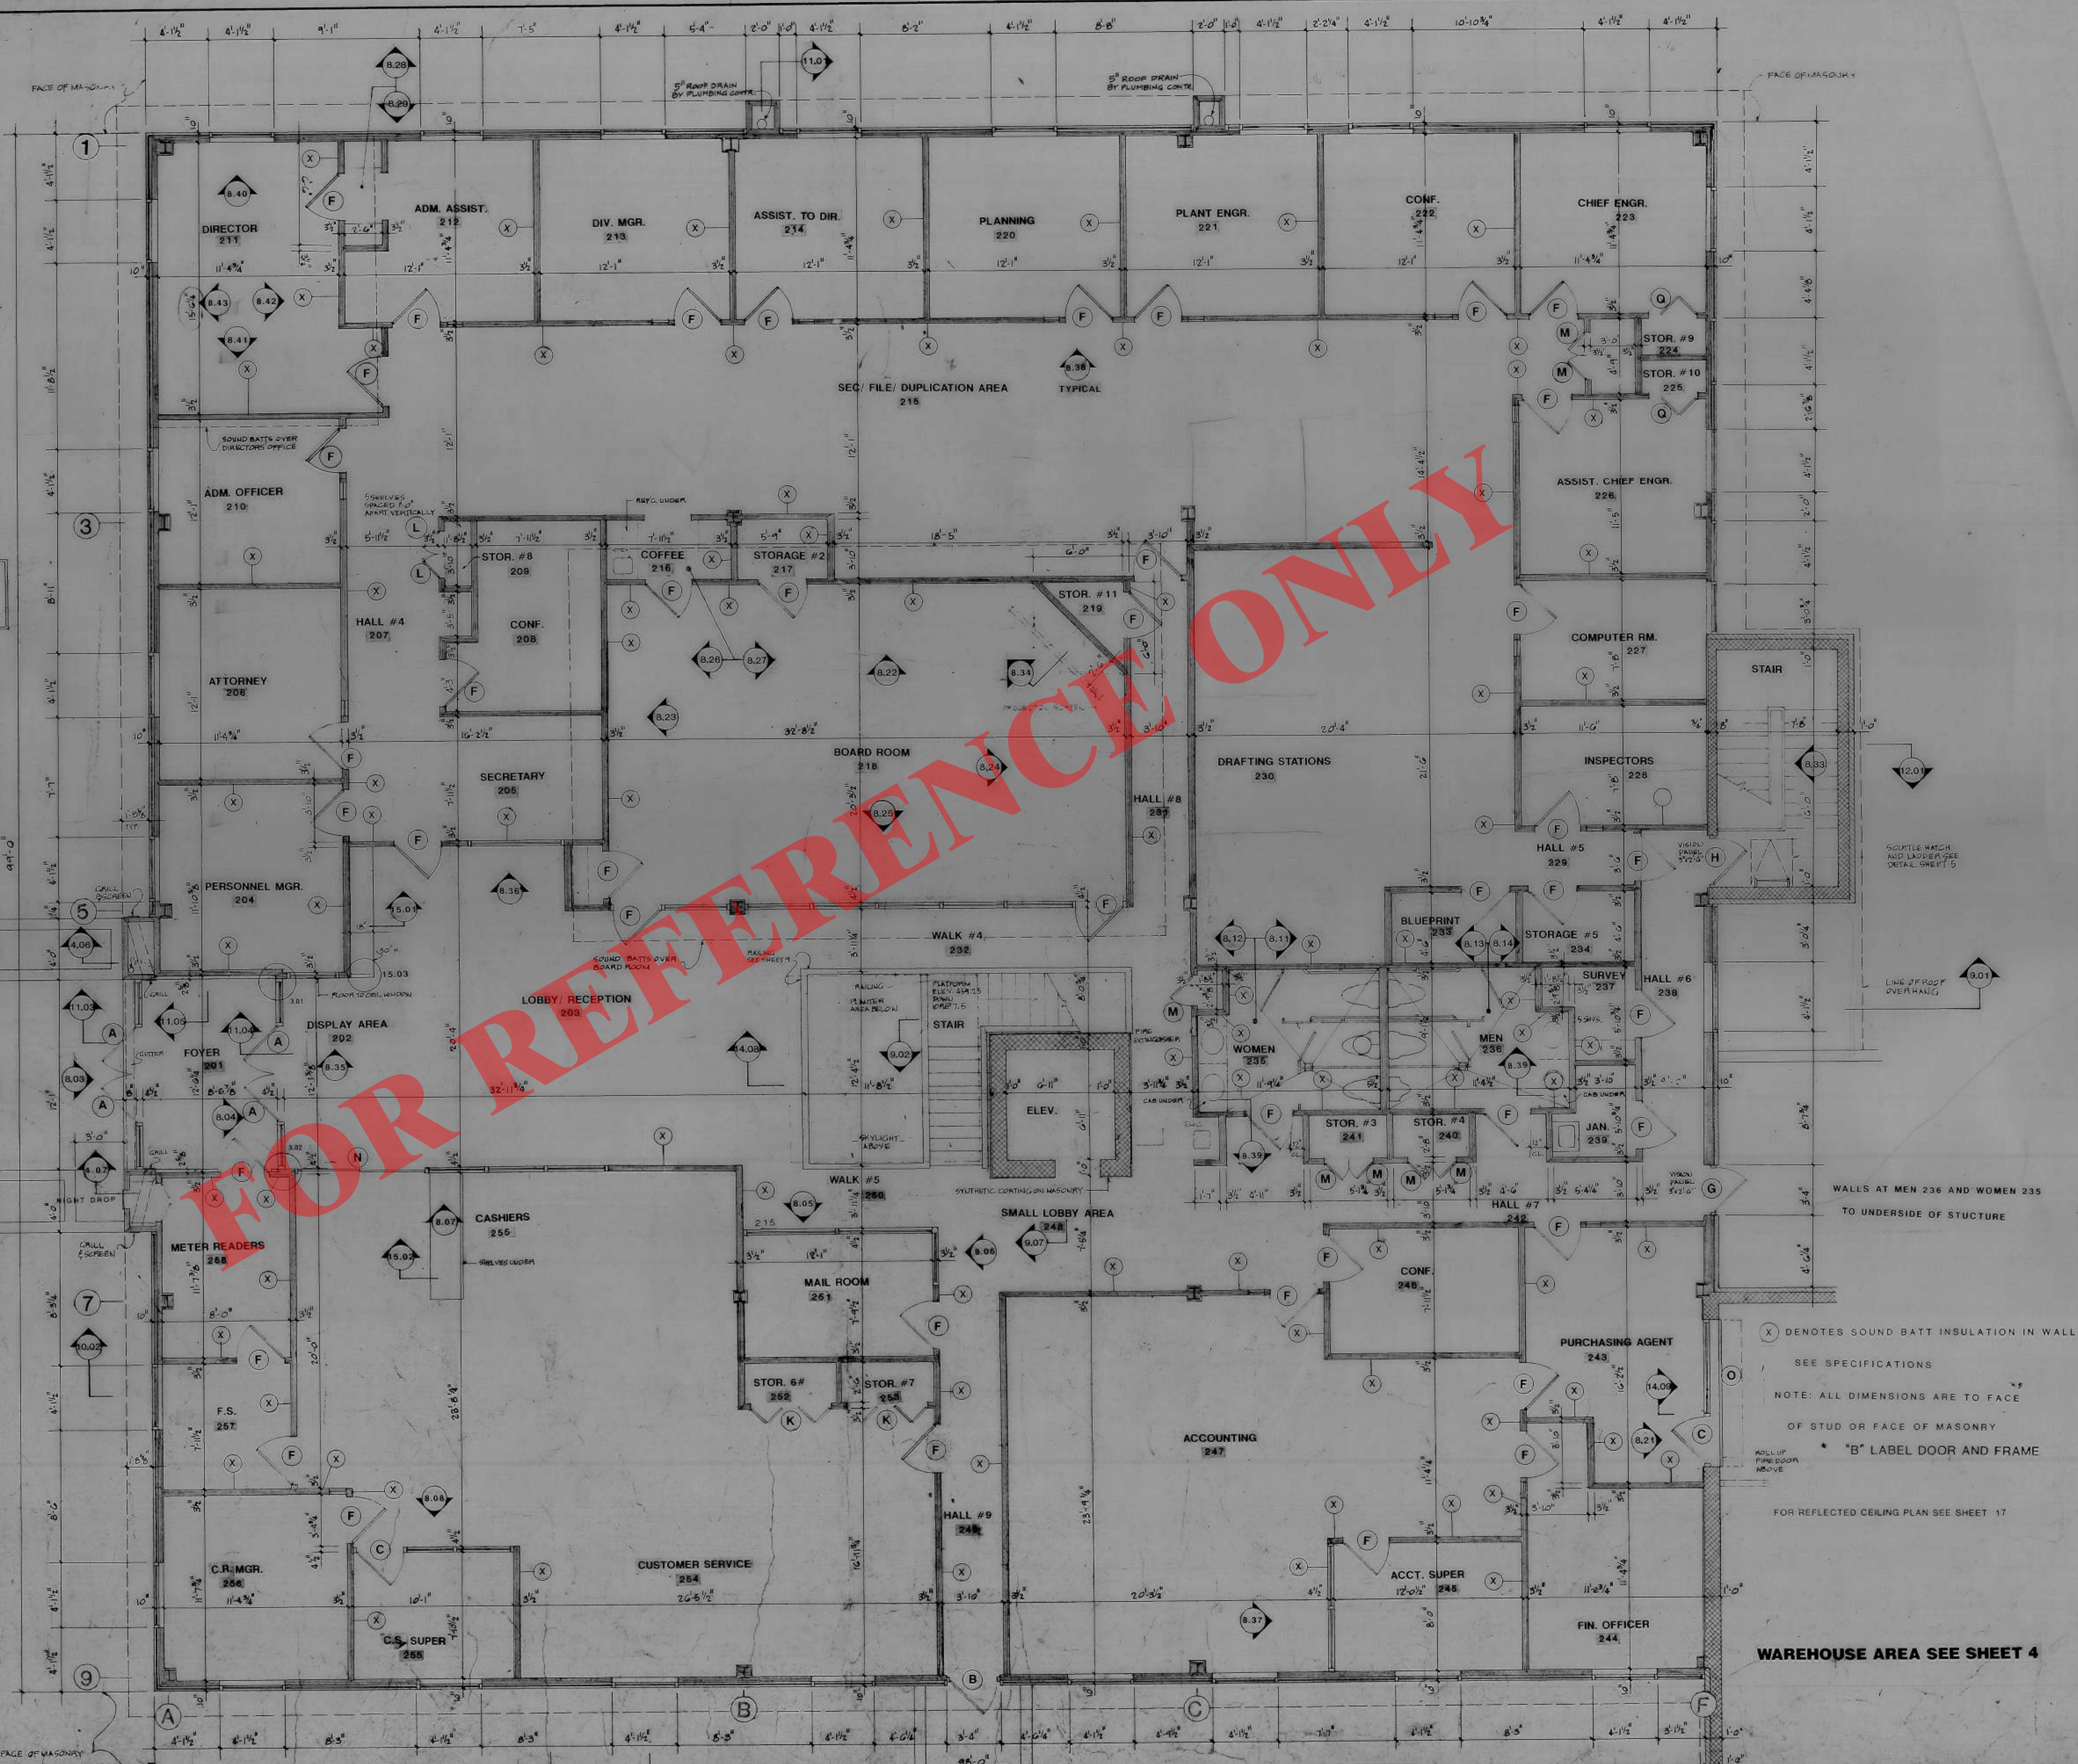

UPPER LEVEL FLOOR PLAN

SCALE 1/4" = 1'-0"

WAREHOUSE AREA SEE SHEET 4

X DENOTES SOUND BATT INSULATION IN WALL
SEE SPECIFICATIONS
NOTE: ALL DIMENSIONS ARE TO FACE
OF STUD OR FACE OF MASONRY
* "B" LABEL DOOR AND FRAME
ROLL UP FINE SCOPES ABOVE
FOR REFLECTED CEILING PLAN SEE SHEET 17



city planning and architectural associates
architects
chapel hill, n.c.
11/19/79

DATE: DECEMBER, 1979
DRAWN BY:
CHECKED BY:

O.W.A.S.A. OPERATIONS CENTER
CARRBORO, NORTH CAROLINA
UPPER LEVEL FLOOR PLAN

The use of these plans and specifications shall be restricted to the project and location shown hereon. Any reproduction or publication of these plans and specifications in whole or in part, without the written consent of the architect, is prohibited. Title to the plans and specifications herein is in the architect's office. The architect assumes no liability for the construction of these buildings.




cpaa
city planning and
architectural associates
architects : planners
chapel hill, n.c.

revisions:
date: DECEMBER, 1988
drawn by:
checked by:

O.W.A.S.A. OPERATIONS CENTER
CARRBORO, NORTH CAROLINA
FLOOR PLAN AT WAREHOUSE BRIDGE DETAILS

The use of these plans and specifications shall be restricted to the project for which they were prepared and publication thereof is not intended to constitute an offer of professional services. For any particular project, the user shall consult with the architect or engineer for the project and shall obtain the necessary permits and approvals from the appropriate authorities. The user shall be responsible for the accuracy and completeness of the information furnished to the architect or engineer and for the proper interpretation of the drawings and specifications of these documents.

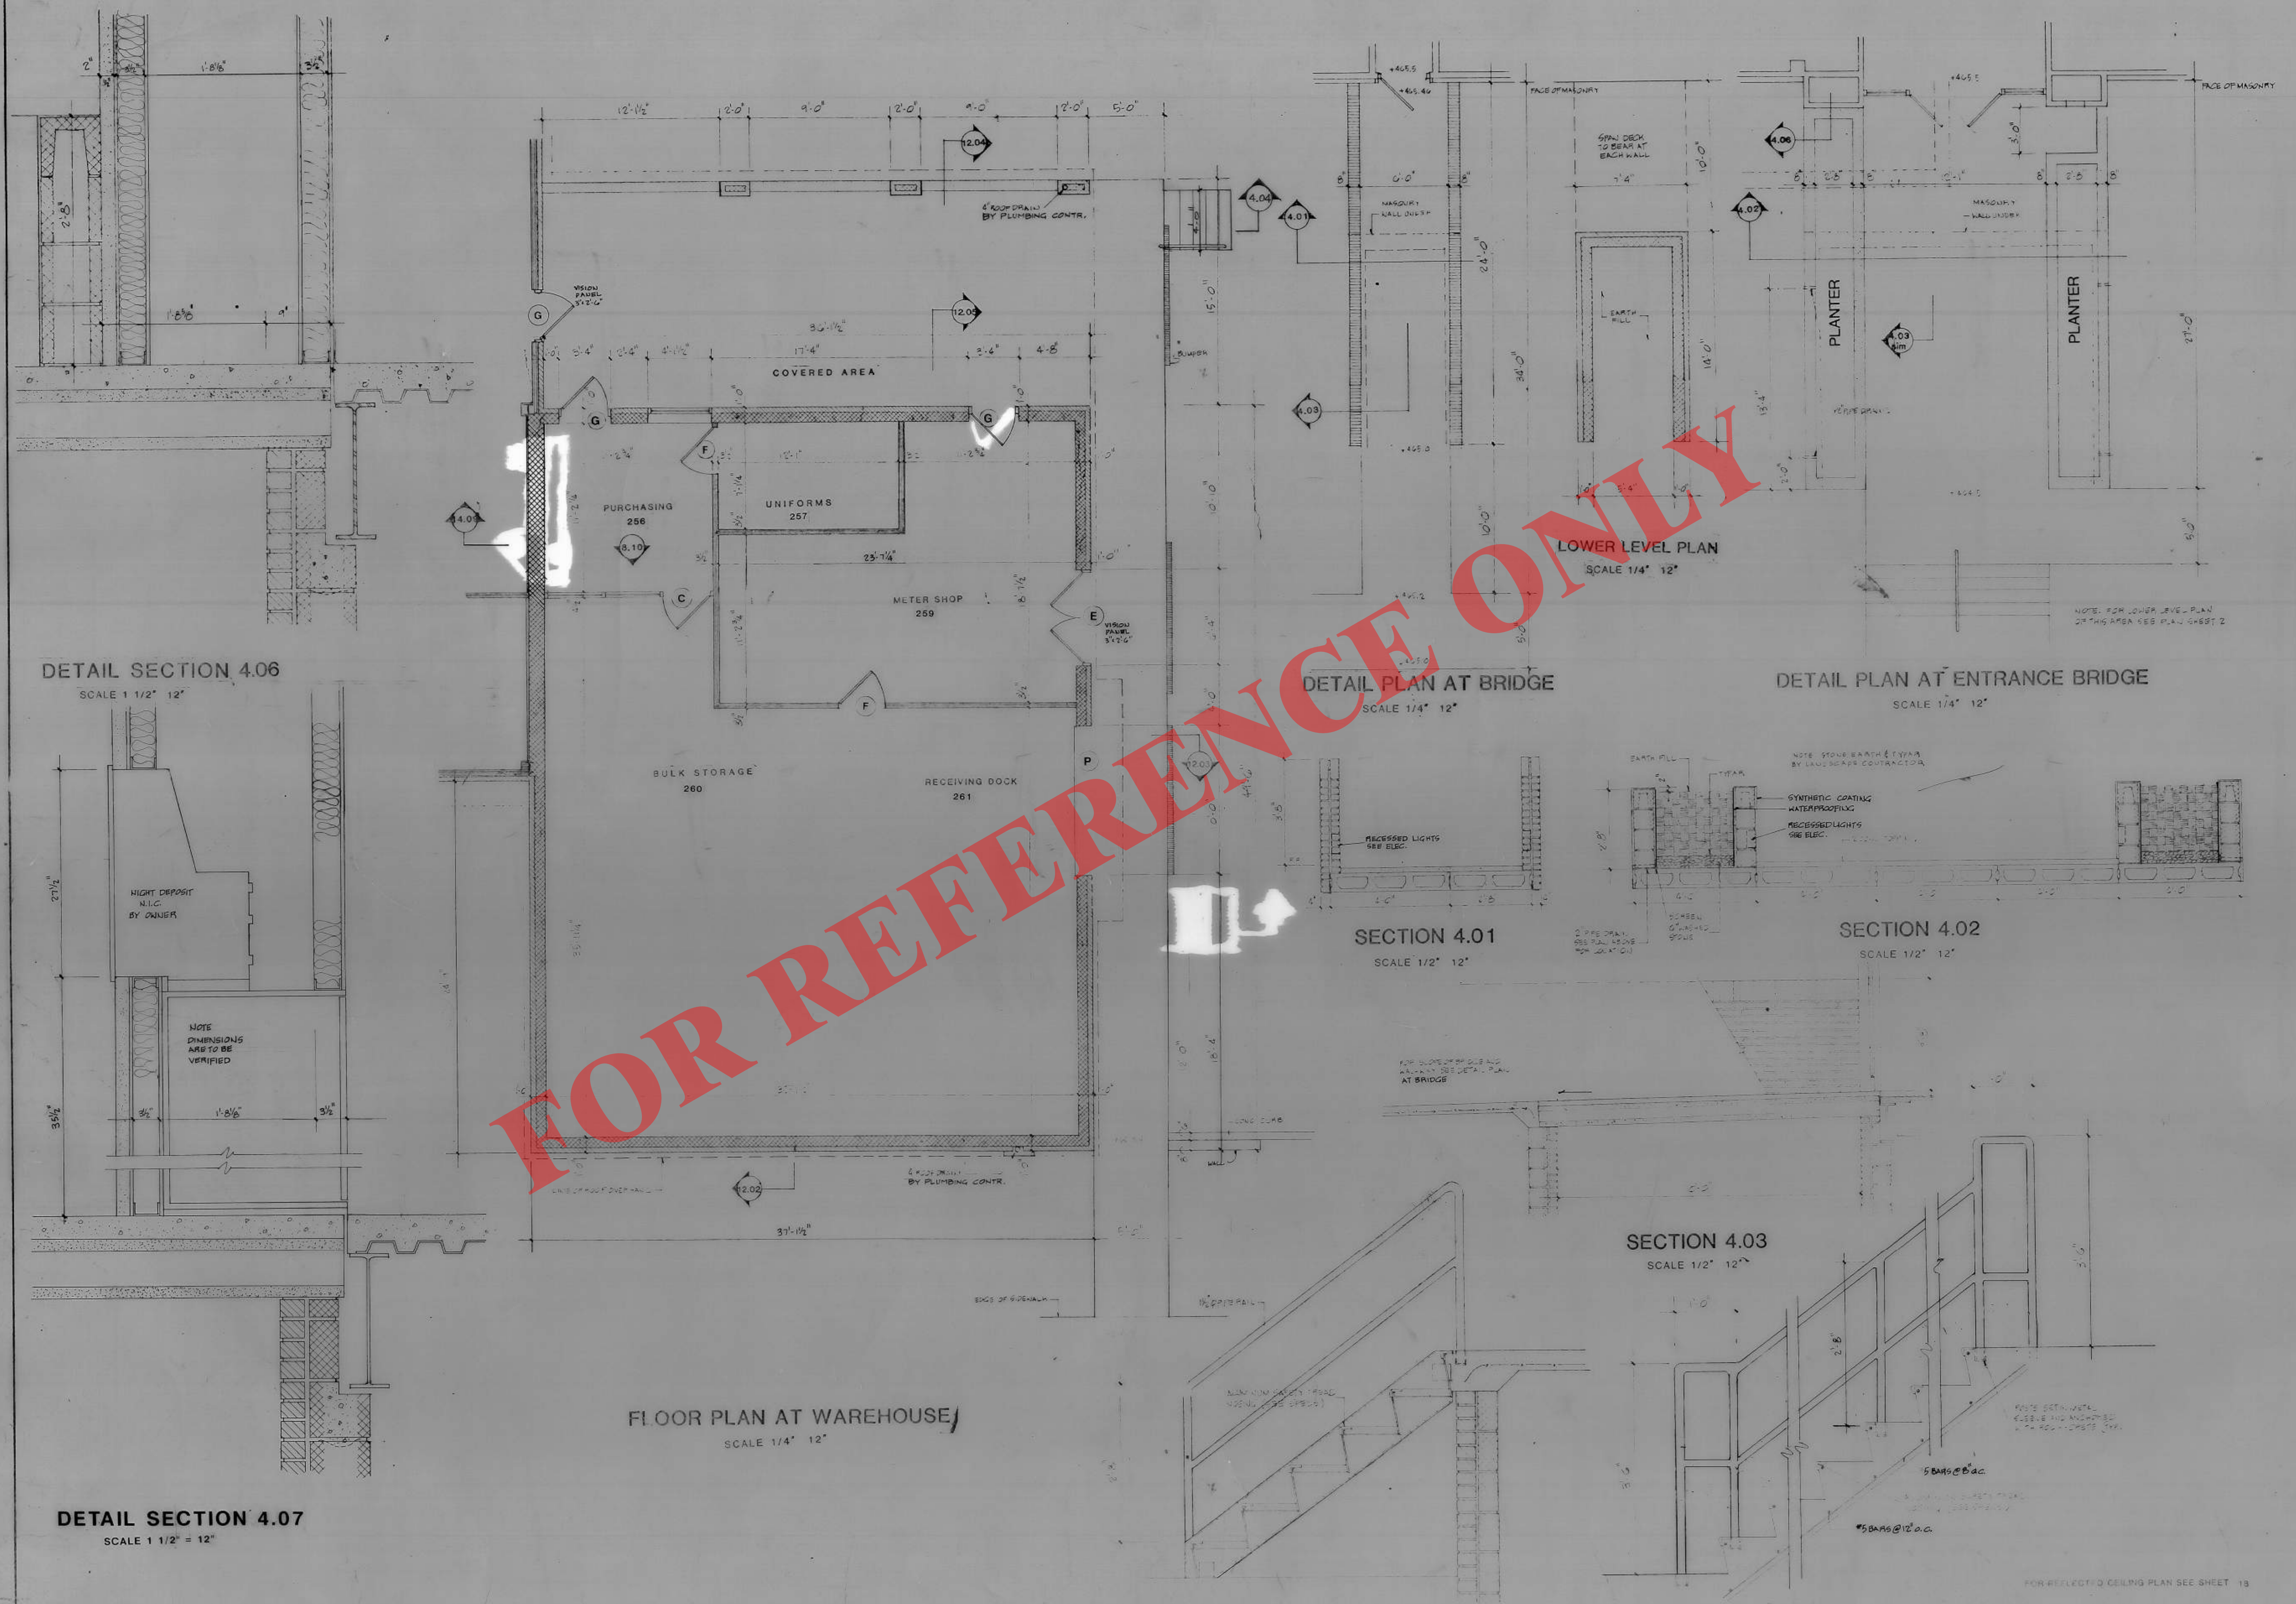

DETAIL SECTION 4.06
SCALE 1 1/2" = 12"

DETAIL PLAN AT BRIDGE
SCALE 1/4" = 12"

DETAIL PLAN AT ENTRANCE BRIDGE
SCALE 1/4" = 12"

SECTION 4.01
SCALE 1/2" = 12"

SECTION 4.02
SCALE 1/2" = 12"

SECTION 4.03
SCALE 1/2" = 12"

FLOOR PLAN AT WAREHOUSE
SCALE 1/4" = 12"

DETAIL SECTION 4.07
SCALE 1 1/2" = 12"

EXTERIOR METAL STAIR DETAIL 4.04
SCALE 1" = 12"

EXTERIOR CONCRETE STAIR DETAIL 4.05
SCALE 1" = 12"





city planning and architectural associates
planners
architects
CHAPEL HILL, N.C. 27517-7118

DATE: DECEMBER, 1988
DRAWN BY:
CHECKED BY:


O.W.A.S.A. OPERATIONS CENTER
CARRBORO, NORTH CAROLINA
ROOF PLAN, DETAILS

The use of these plans and specifications shall be restricted to the project site for which they were prepared and published. Their use on any other project, in whole or in part, is prohibited. This is the responsibility of the user. These plans and specifications shall constitute public notice of the acceptance of these specifications.

sheet no.
5
JOB NO. 549
AS BUILT 8/17/90

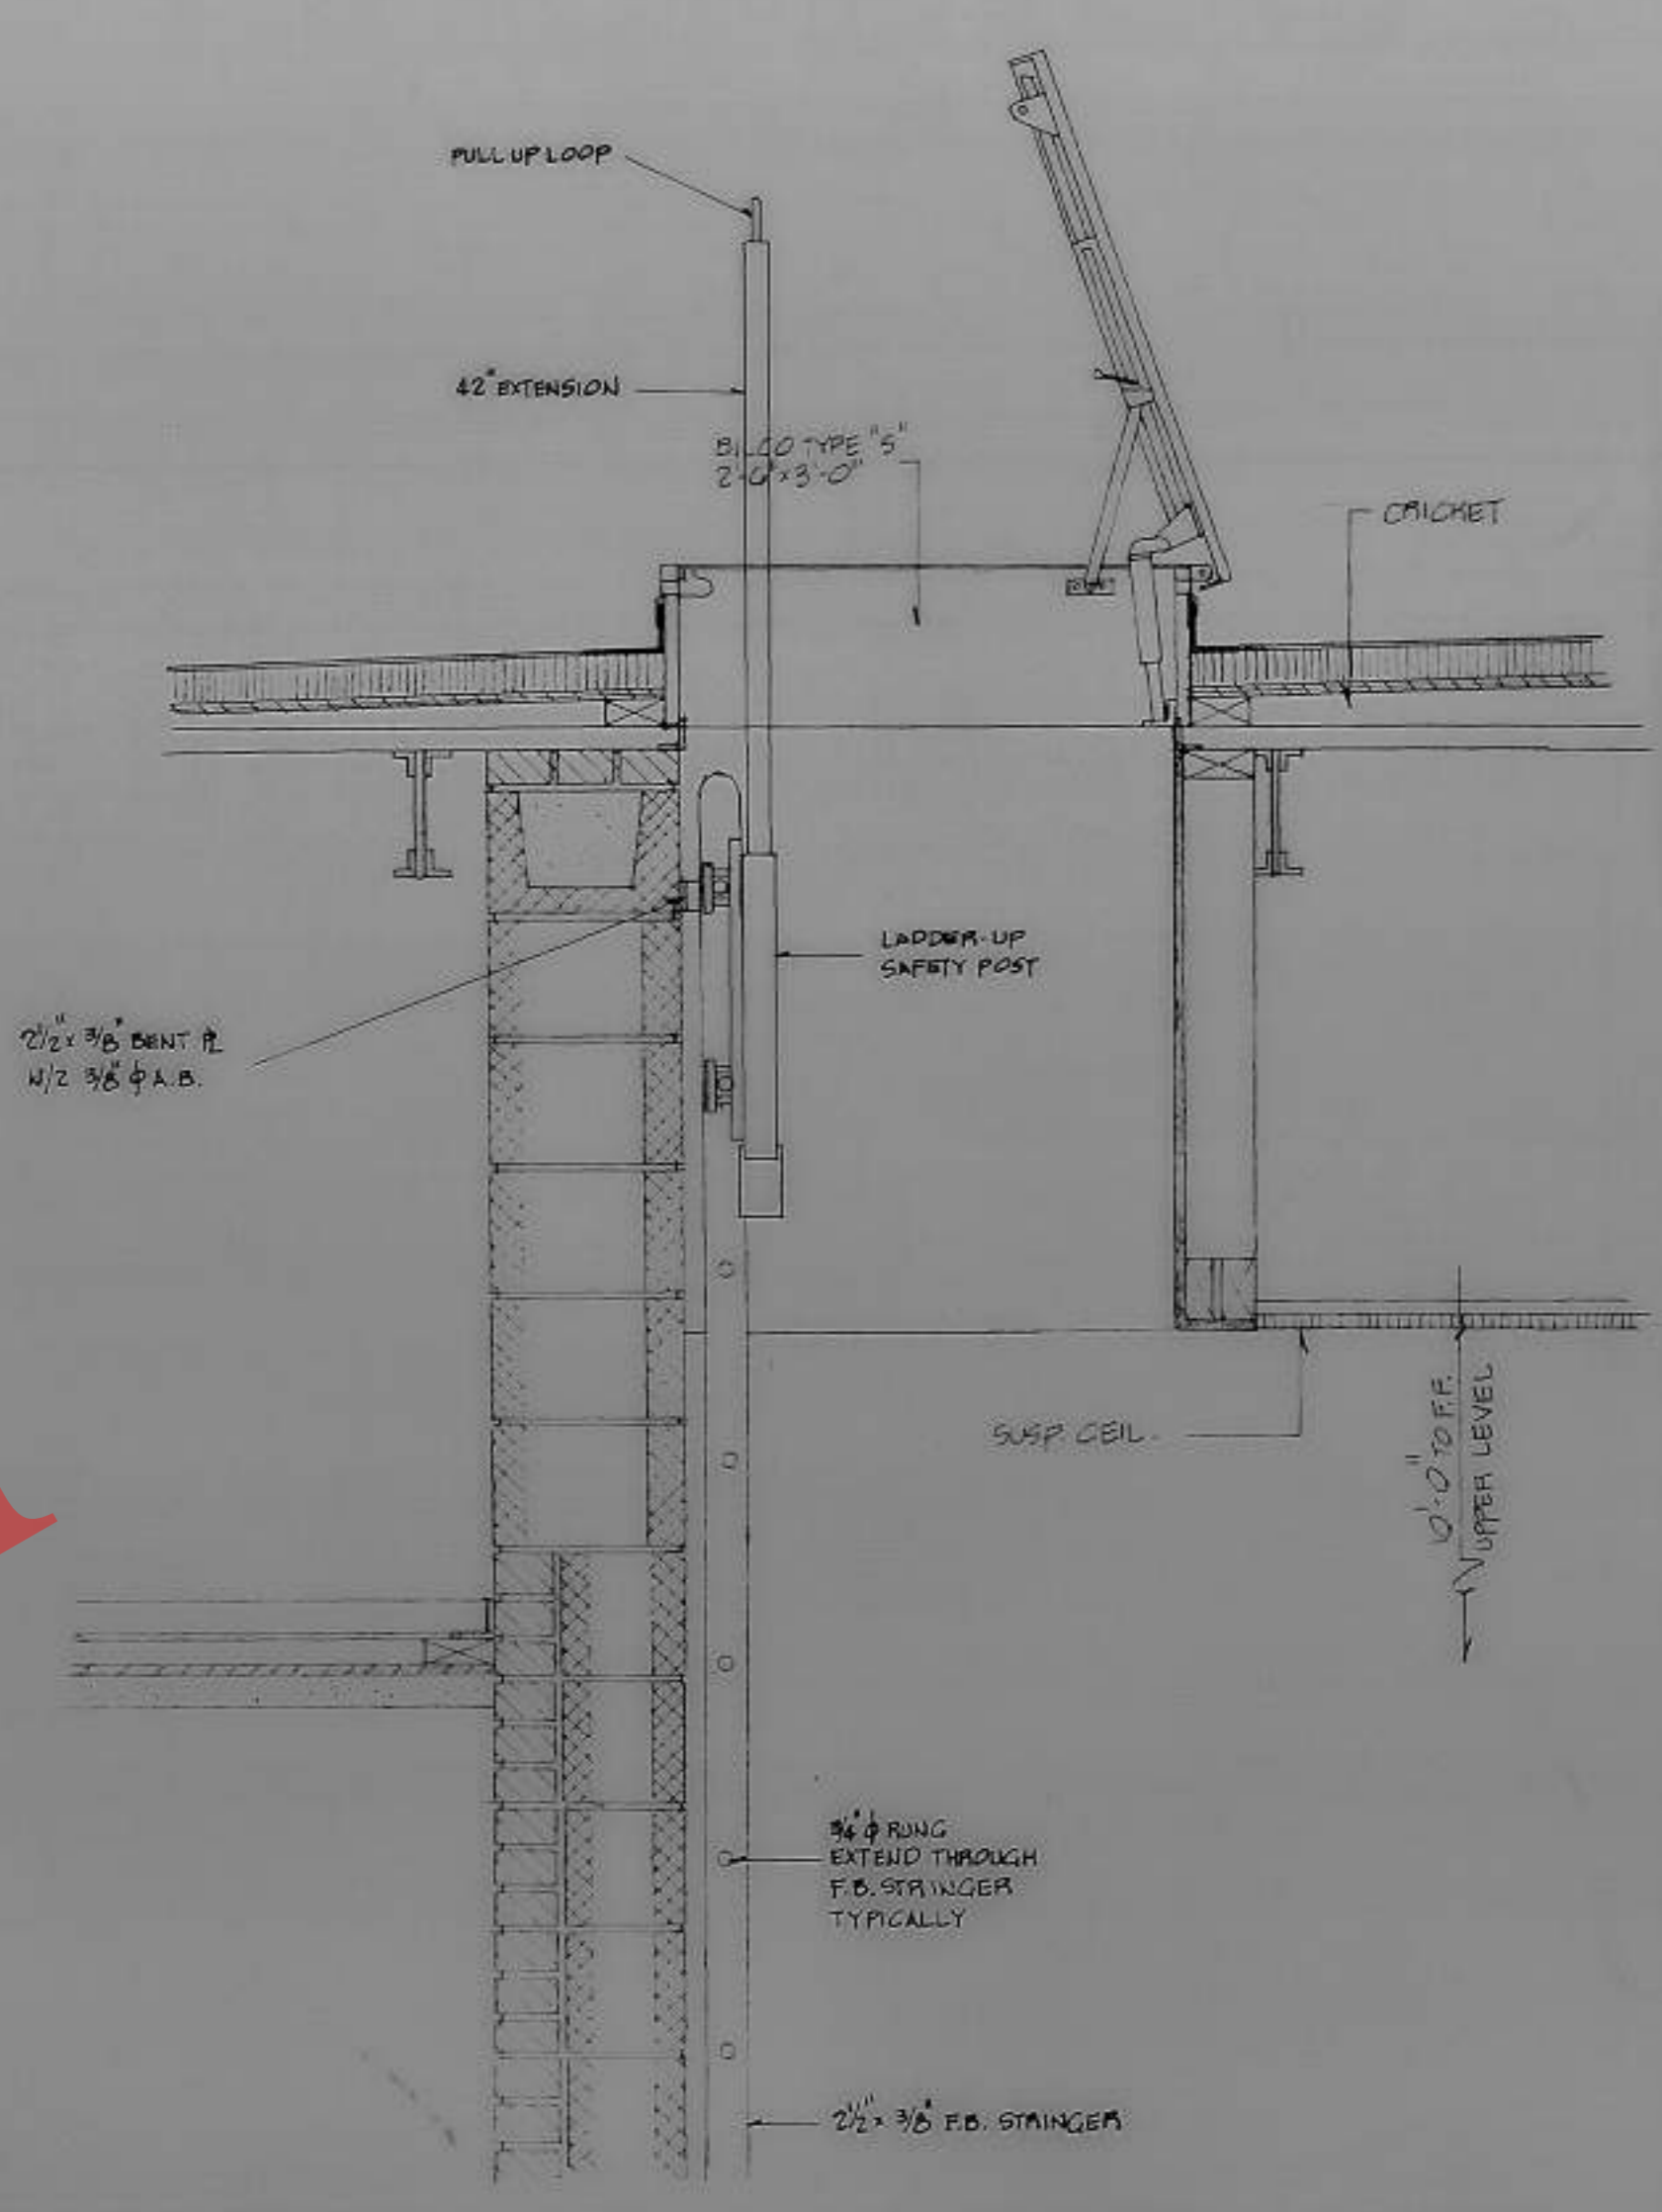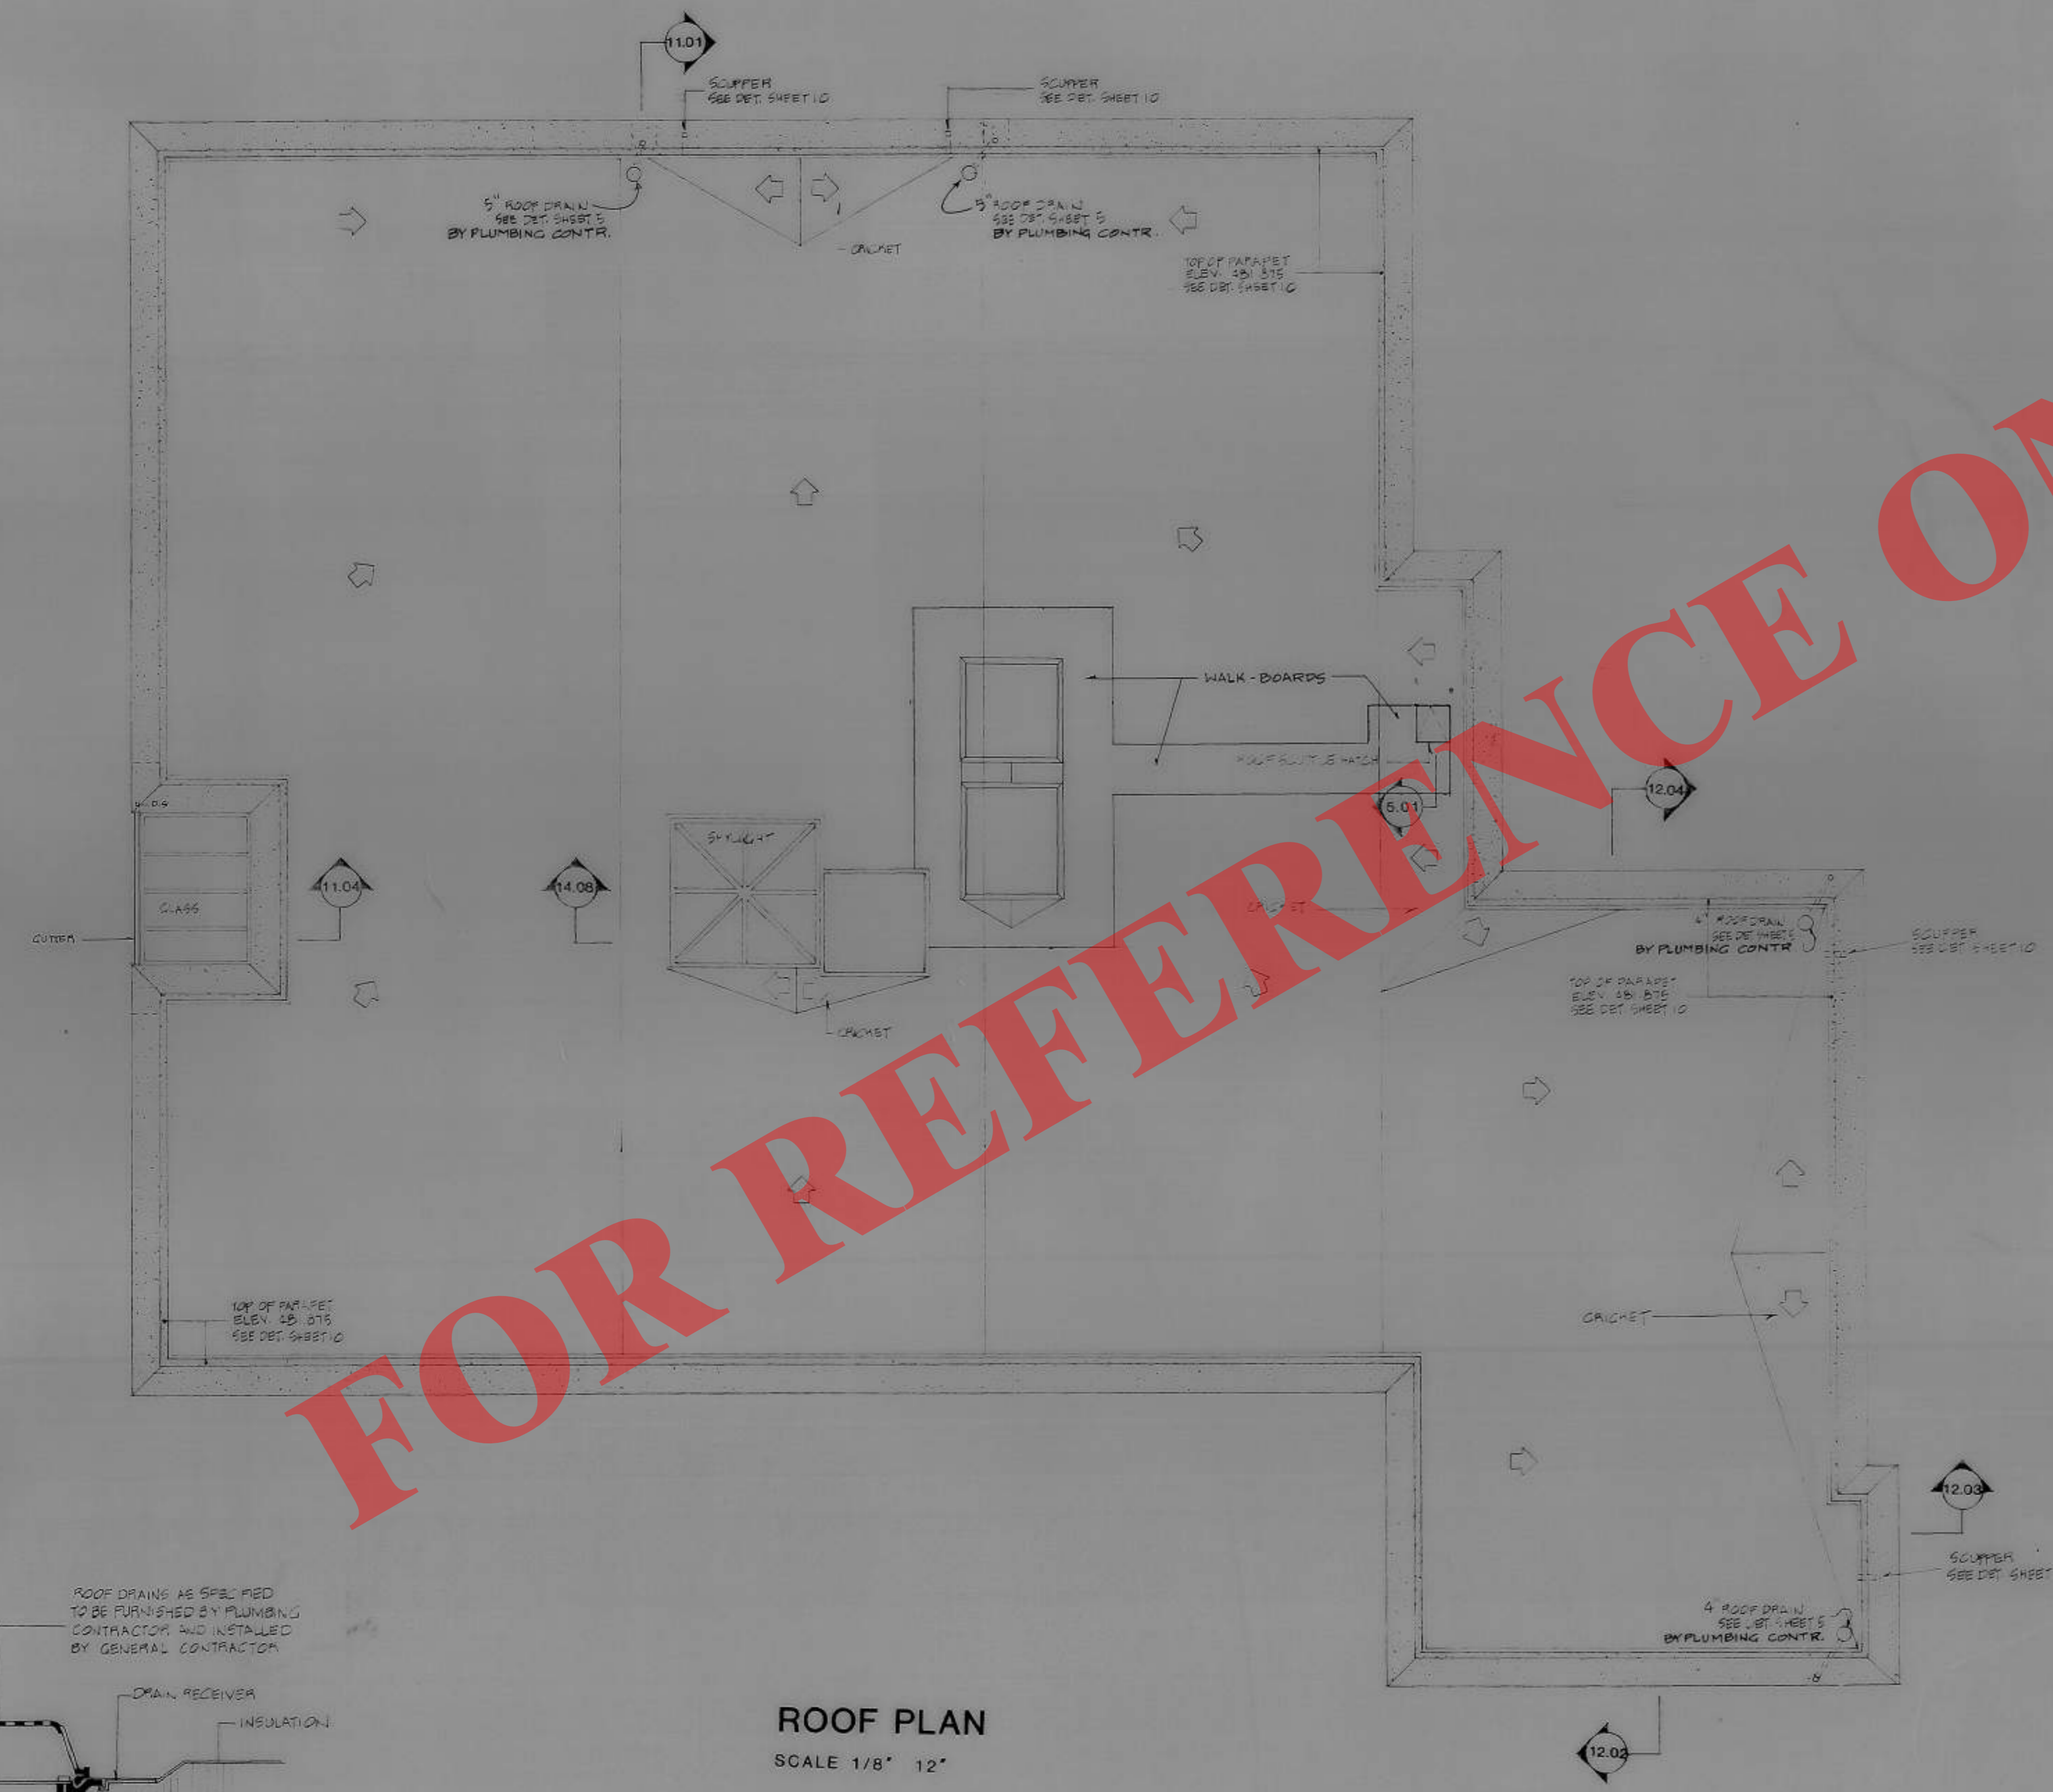

DETAIL AT ROOF SCUTTLE 5.01
SCALE 1" = 12"

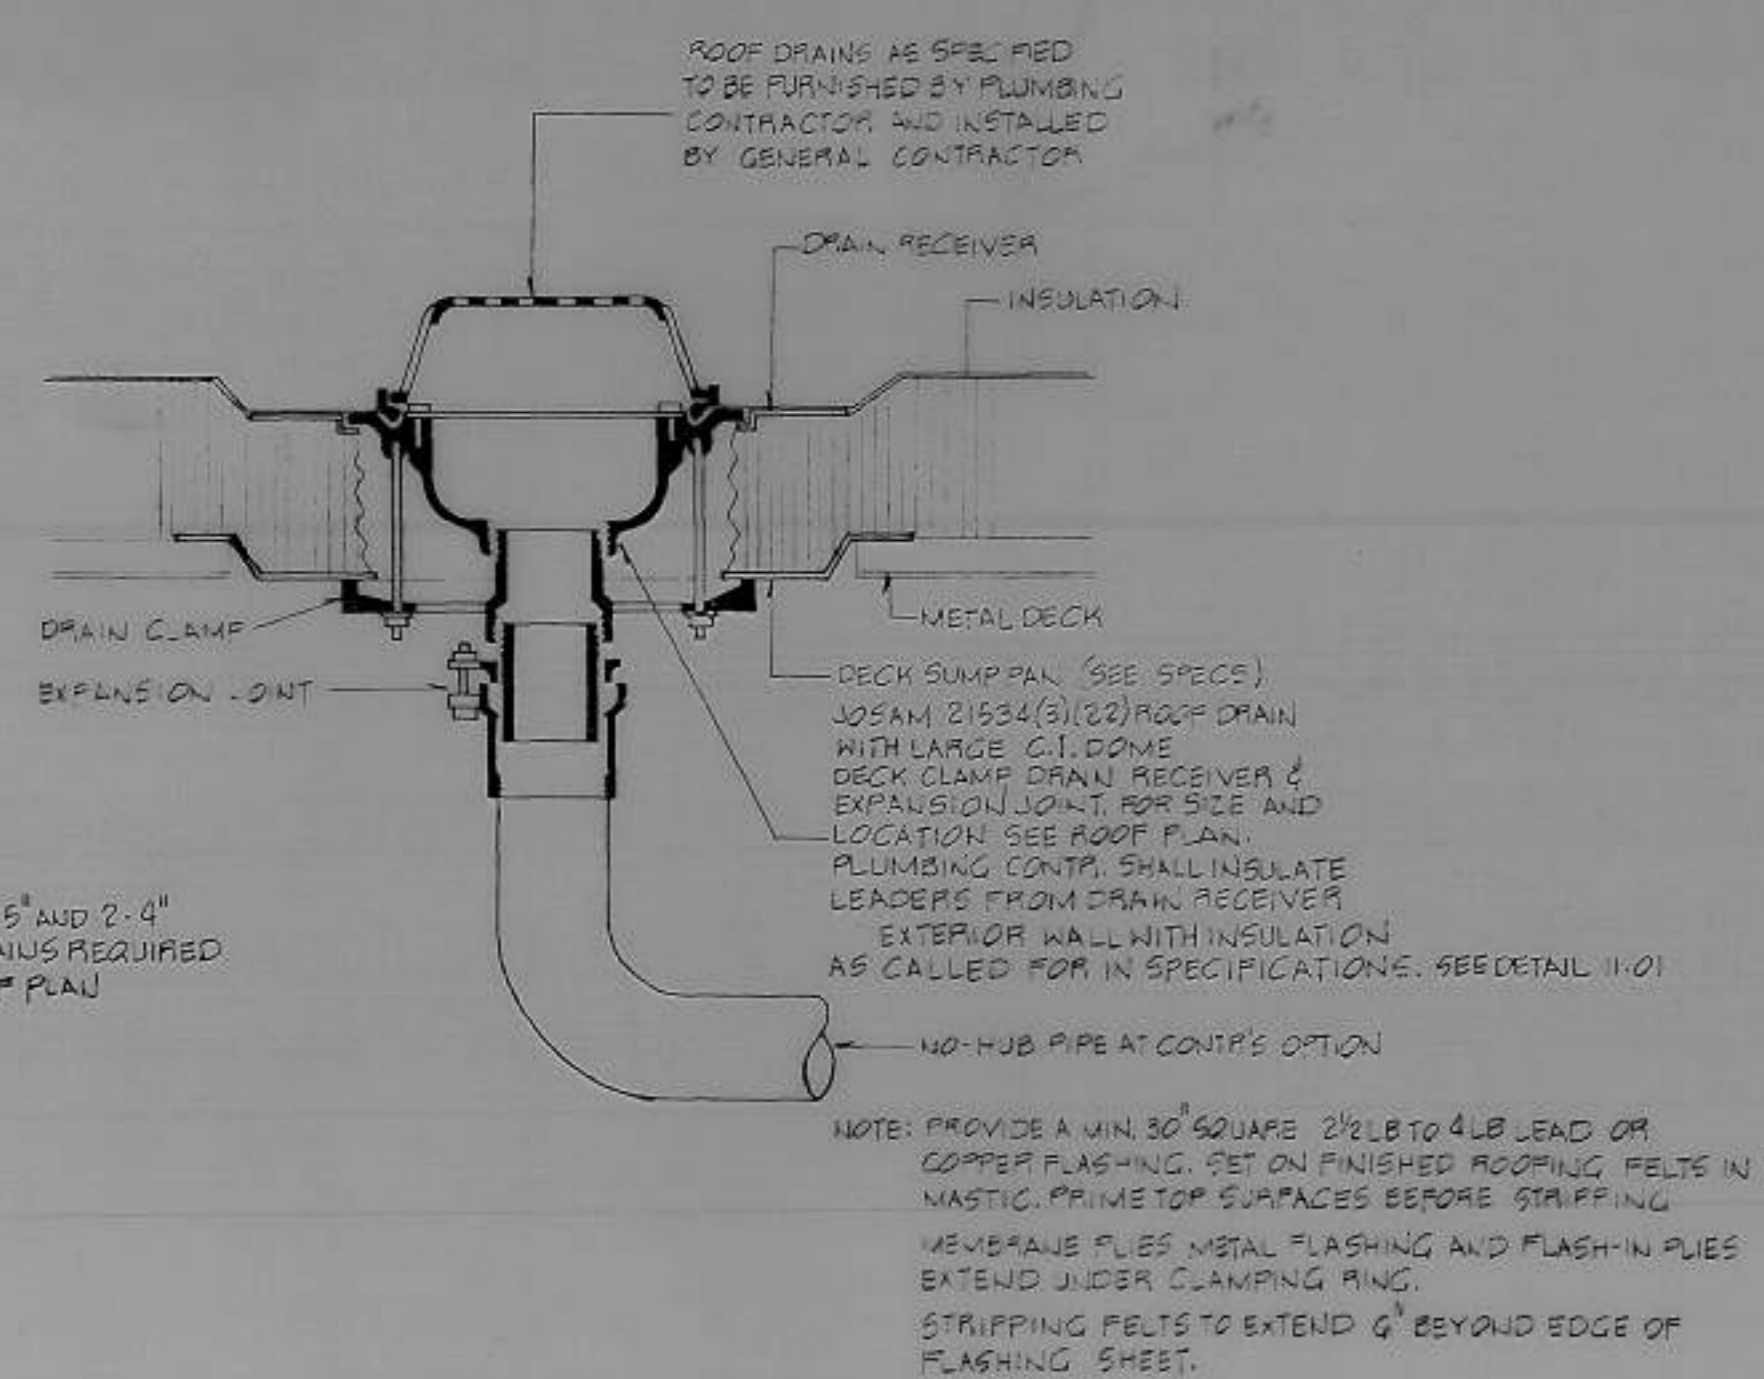

DETAIL AT ROOF DRAIN
SCALE 1 1/2" = 12"

FOR REFERENCE ONLY

NOTE:
ROOF DRAINS & PIPING BY PLUMBING CONTRACTOR.




city planning and
architectural associates
planners
architects
Chapel Hill, N.C.

revisions: 07-20-89
checked by:
drawn by:
date: December, 1988


O.W.A.S.A. OPERATIONS CENTER
CARBORO, NORTH CAROLINA
EXTERIOR ELEVATIONS

The use of these plans and specifications shall be restricted to the project for which they were prepared and published. No part of these plans and specifications shall be used for any other project without the written consent of the architect. The architect shall not be responsible for the construction of these structures.


sheet no. 6
JOB NO. 048
AS BUILT 8/17/90

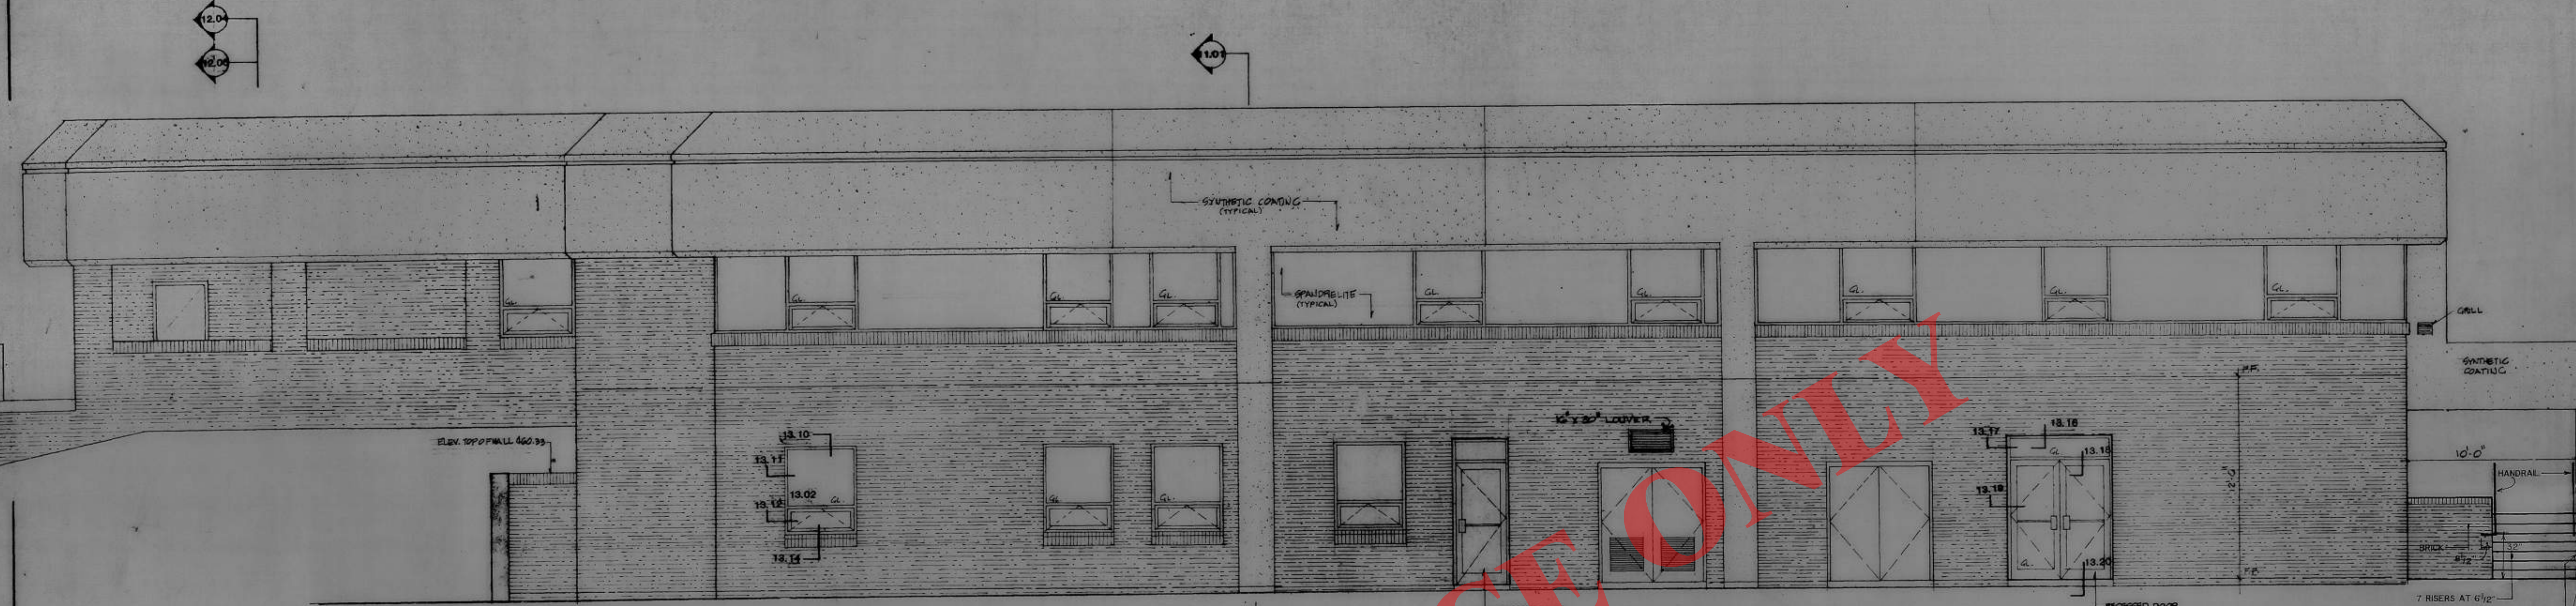


WEST ELEVATION
SCALE 1/4" = 12"

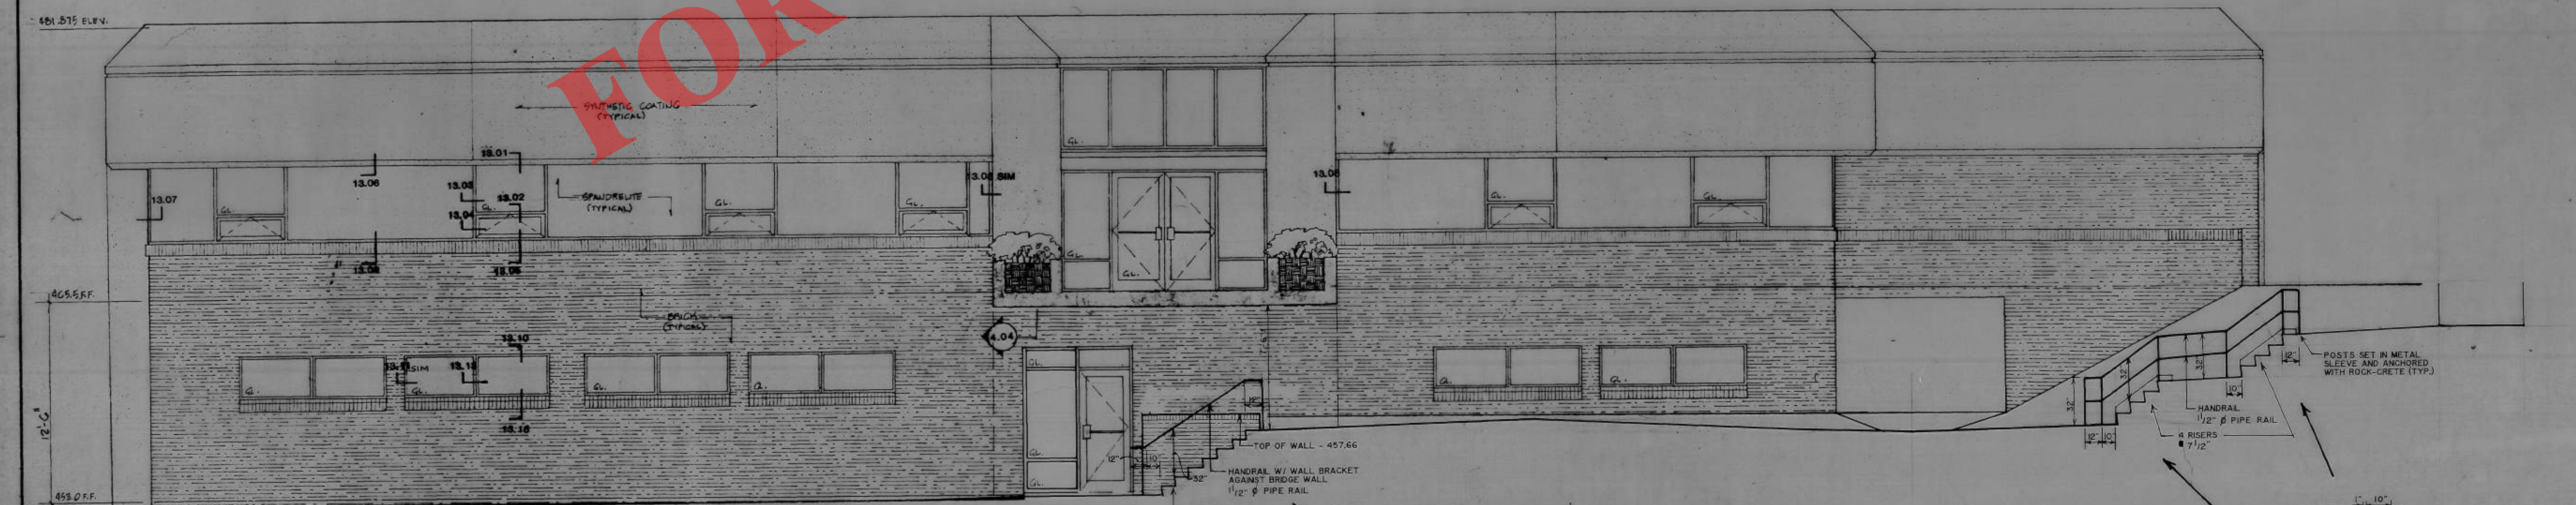

SOUTH ELEVATION
SCALE 1/4" = 12"

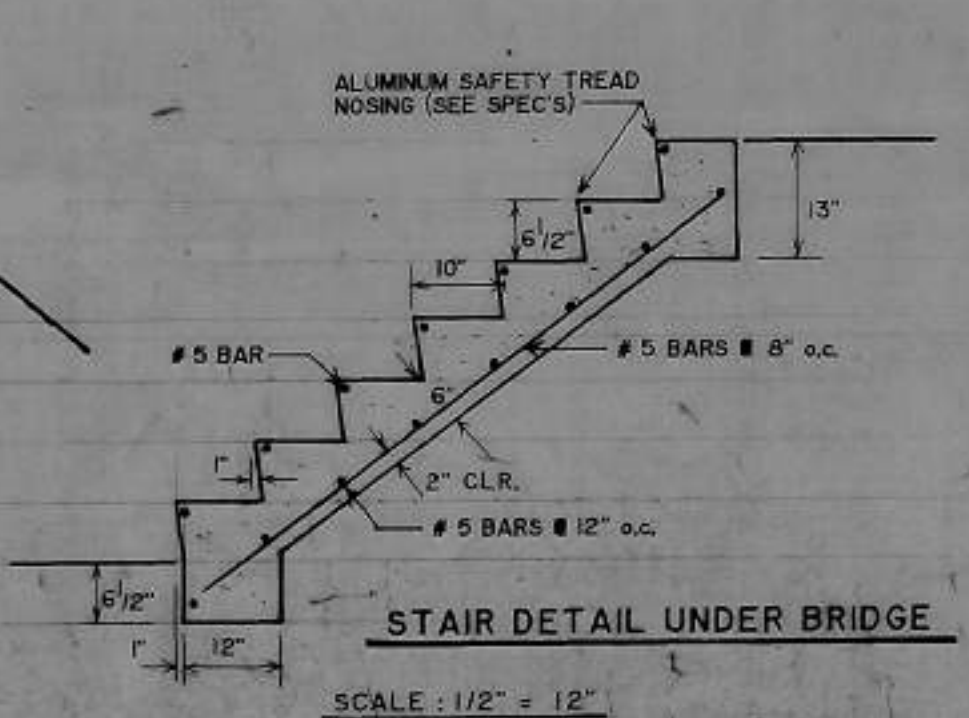

SCALE: 1/2" = 12"

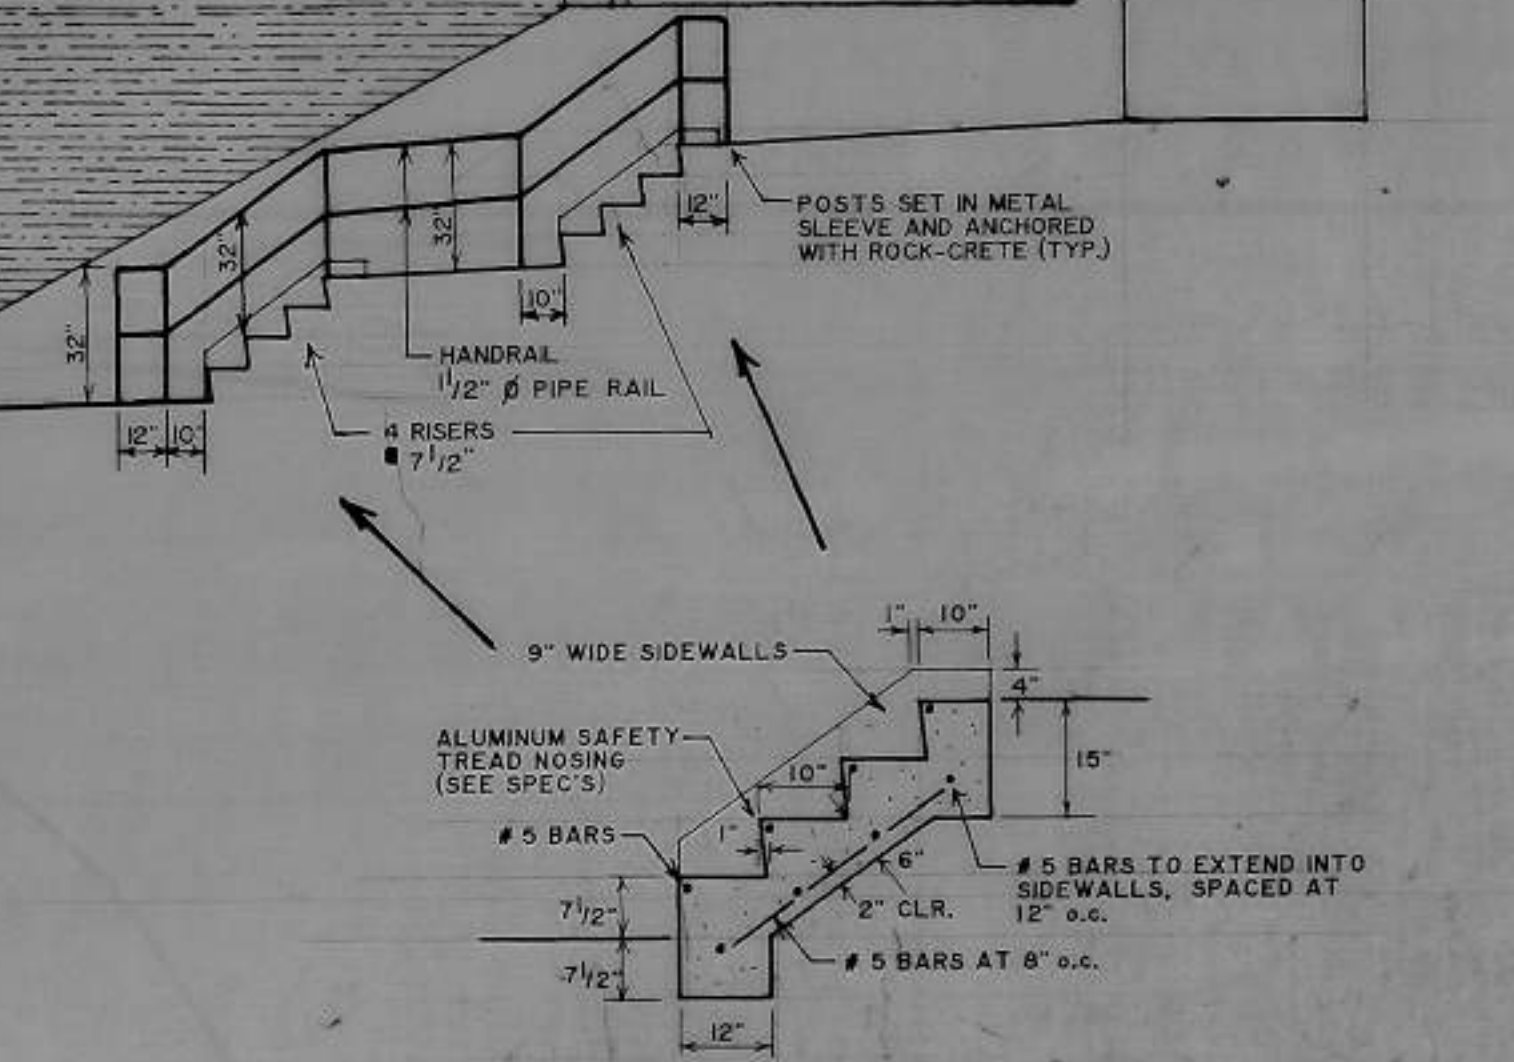

CONCRETE STAIR DETAIL W/ SIDEWALLS
SCALE: 1/2" = 12"




cp aa
 architects
 city planning and
 architectural associates
 planners
 chapel hill, n.c. 27517-1192

DATE: DECEMBER, 1988
 DRAWN BY: [blank]
 CHECKED BY: [blank]


O.W.A.S.A. OPERATIONS CENTER
 CARRBORO, NORTH CAROLINA
EXTERIOR ELEVATIONS

The use of these plans and specifications shall be restricted to the project and location shown on these plans. Any use for other projects or locations without the written consent of the architect is prohibited. The use of these plans and specifications shall constitute an acknowledgment of the responsibility of the architect.

sheet no.
7

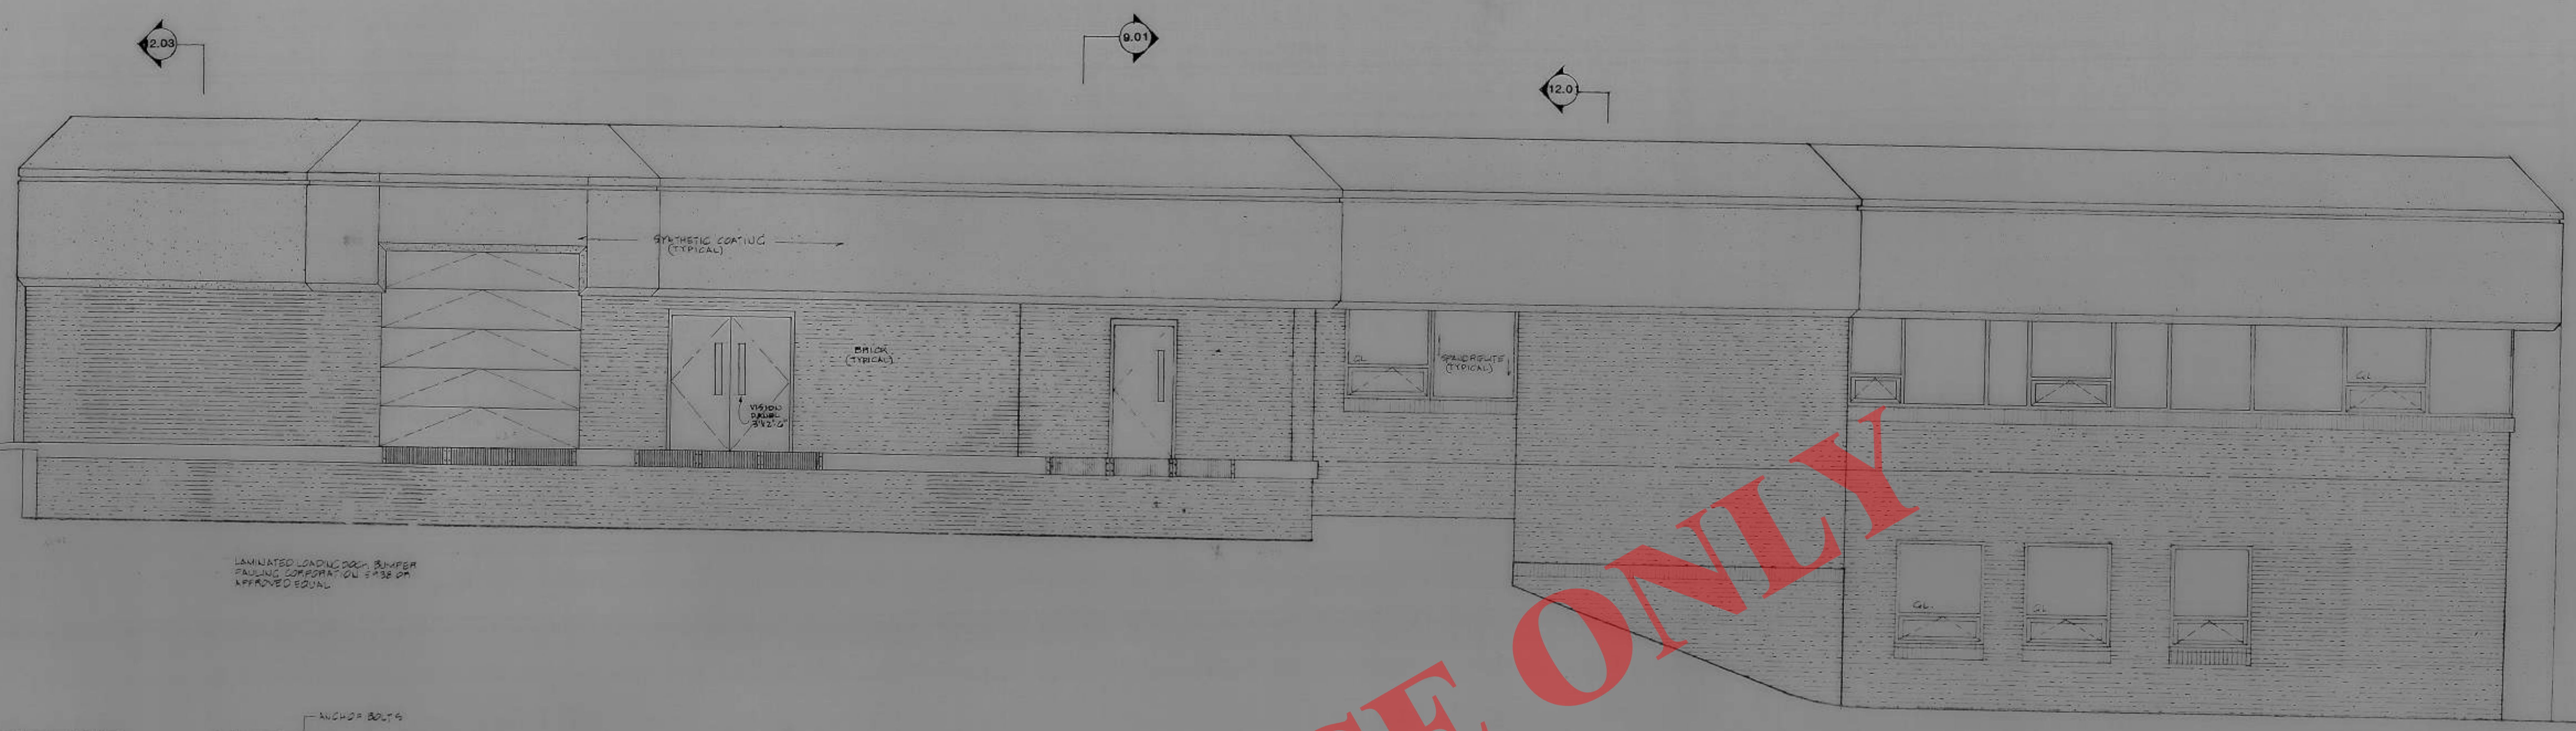


NORTH ELEVATION
 SCALE 1/4" = 12"

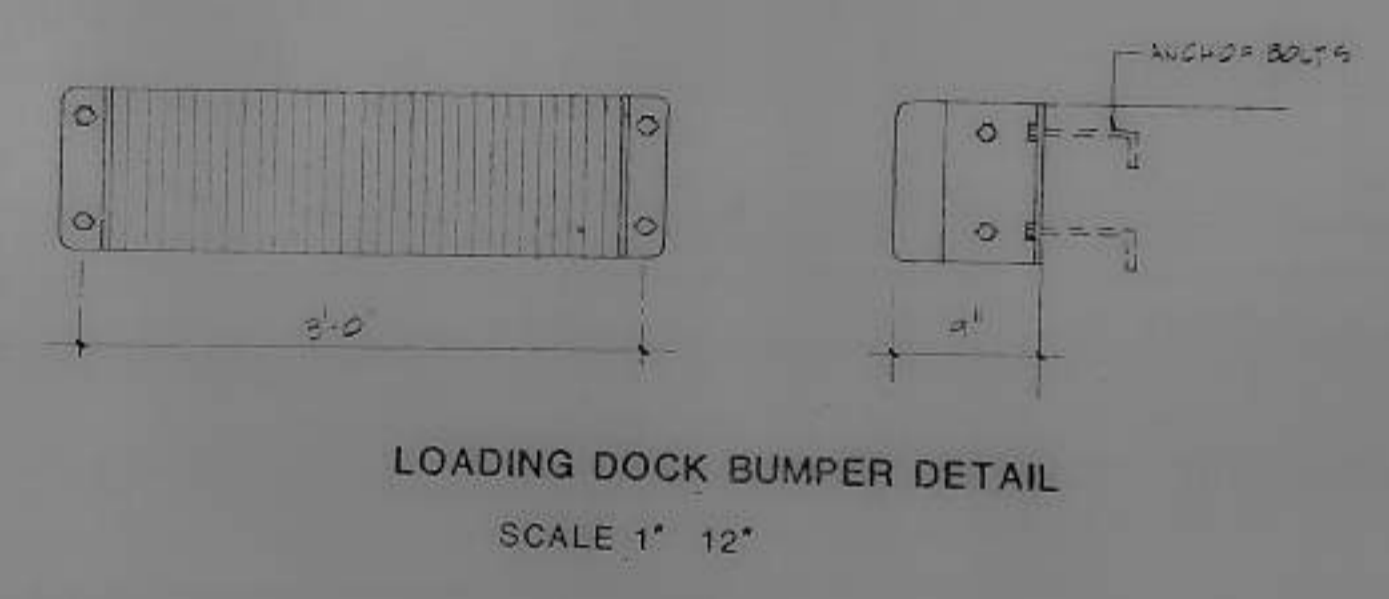

LOADING DOCK BUMPER DETAIL
 SCALE 1" = 12"

FOR REFERENCE ONLY

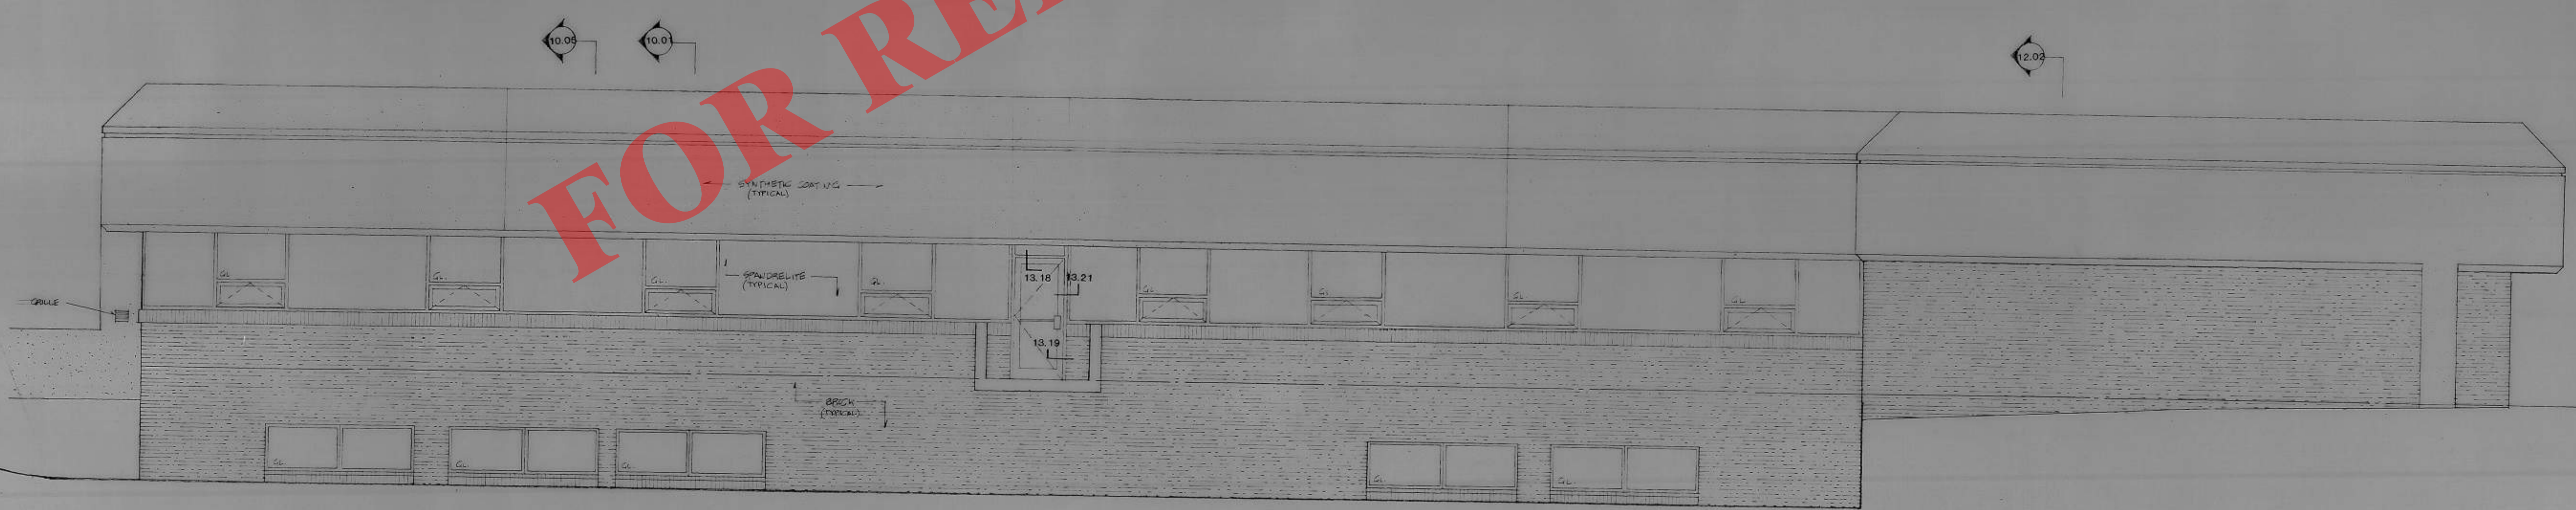

EAST ELEVATION
 SCALE 1/4" = 12"



city, planning and
architectural associates
architects : planners
chapel hill, n.c. 917/937-1154


DATE: DECEMBER, 1988
DRAWN BY:
CHECKED BY:

O.W.A.S.A. OPERATIONS CENTER
CARRBORO, NORTH CAROLINA


The use of these plans and specifications shall be restricted to the project for which they were prepared and no reproduction or publication shall be made without the written consent of the architect. This is to be held by the architect in whole or in part is prohibited. This is to be held by the architect in whole or in part is prohibited. This is to be held by the architect in whole or in part is prohibited.

sheet no. 549
JOB NO. 849
AS BUILT 8/17/90

LONGITUDINAL SECTION, AND STAIR AND RAILING DETAILS

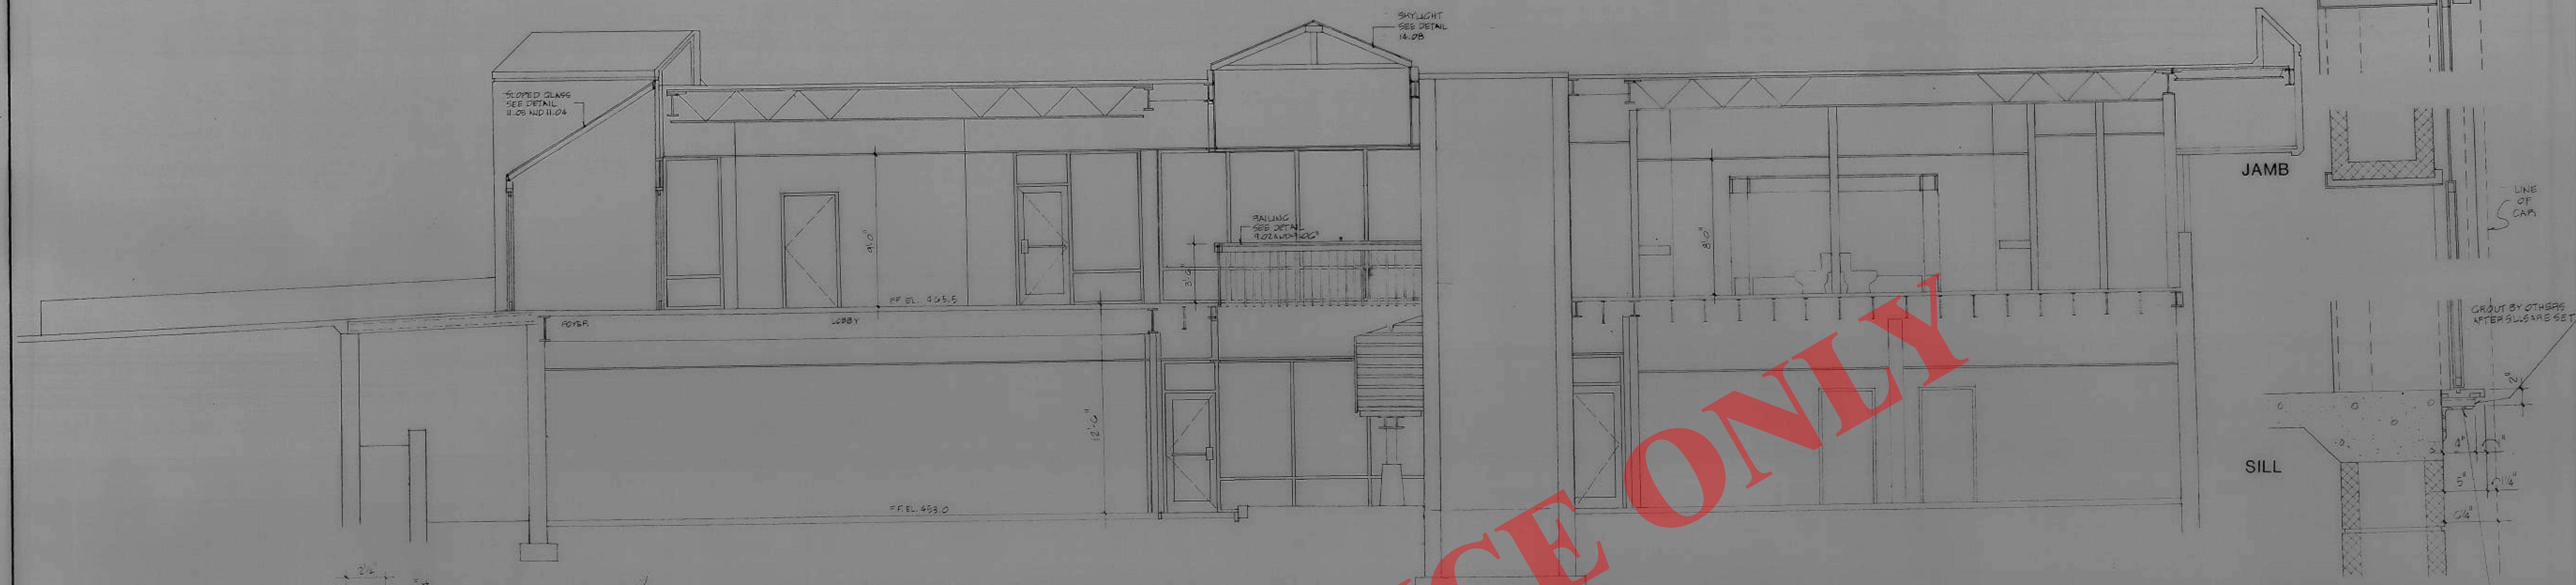


LONGITUDINAL SECTION 9.01
SCALE 1/4" = 12"

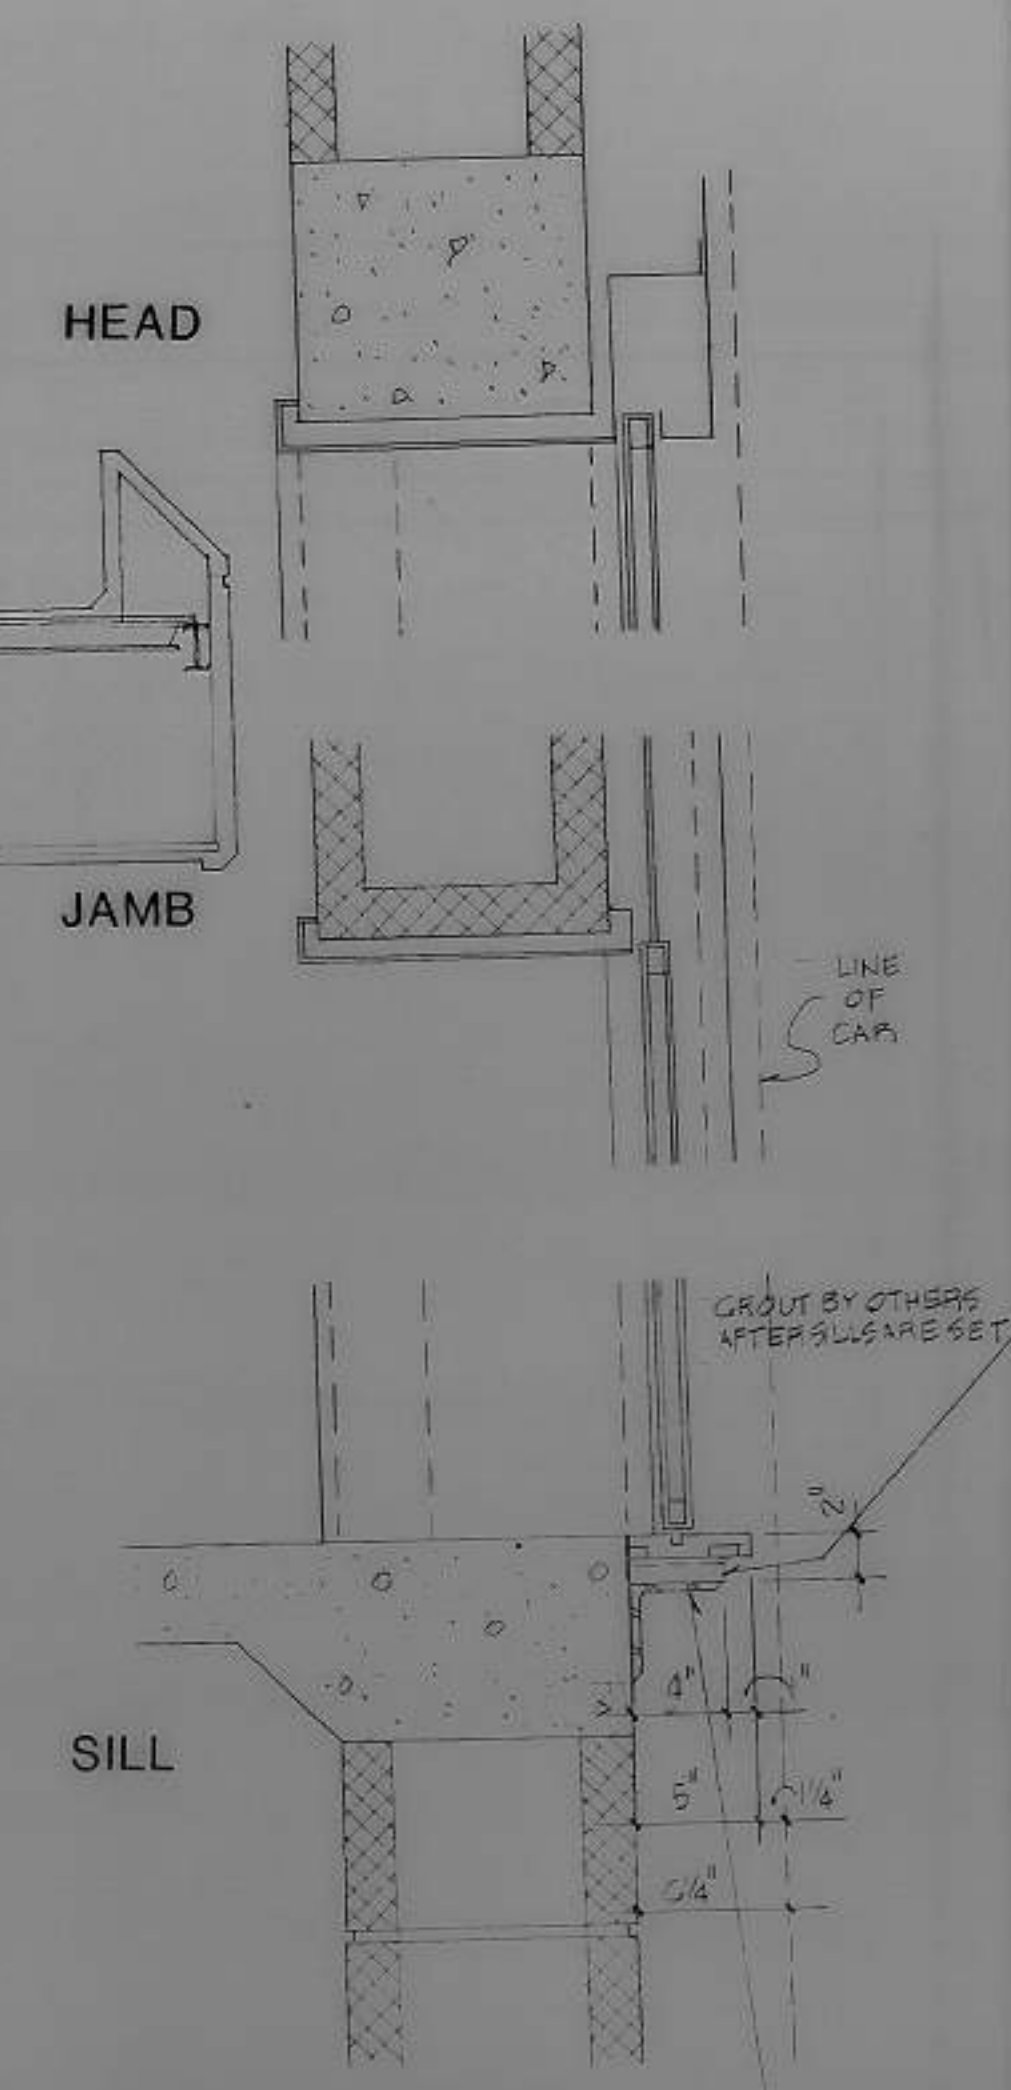


SECTION THRU ELEV. DOOR
SCALE 1 1/2" = 12"


HANDRAIL DETAIL 9.06
SCALE 3" = 12"

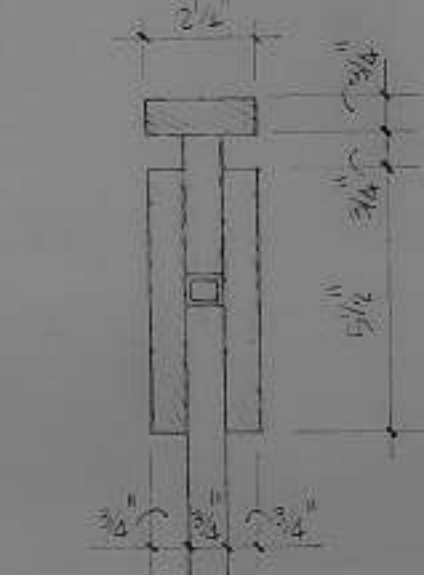


ISOMETRIC
NO SCALE

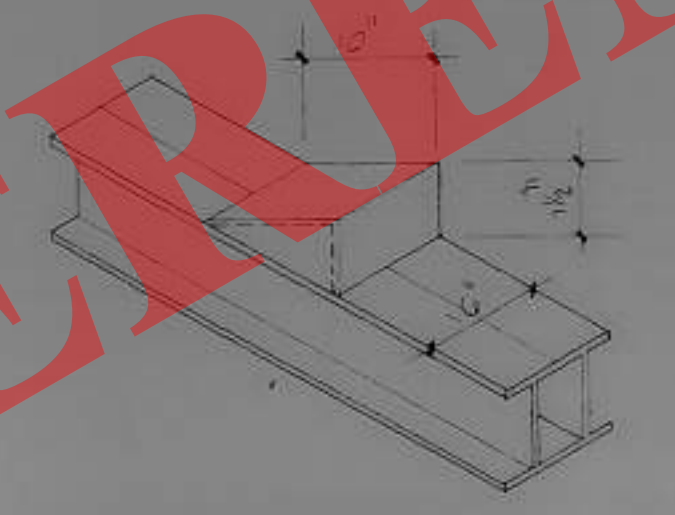


SECTION 9.03
SCALE 3/4" = 12"

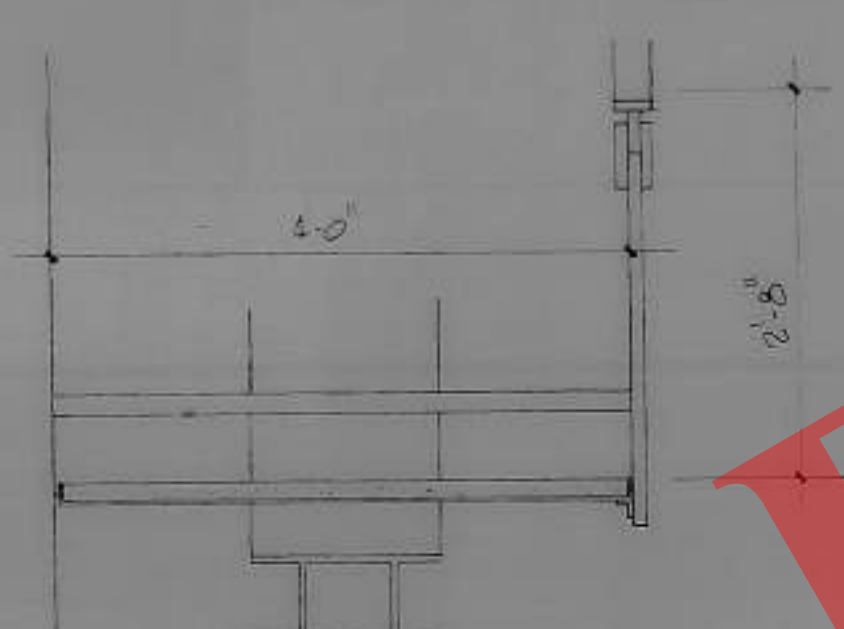


SECTION 9.04
SCALE 3/4" = 12"

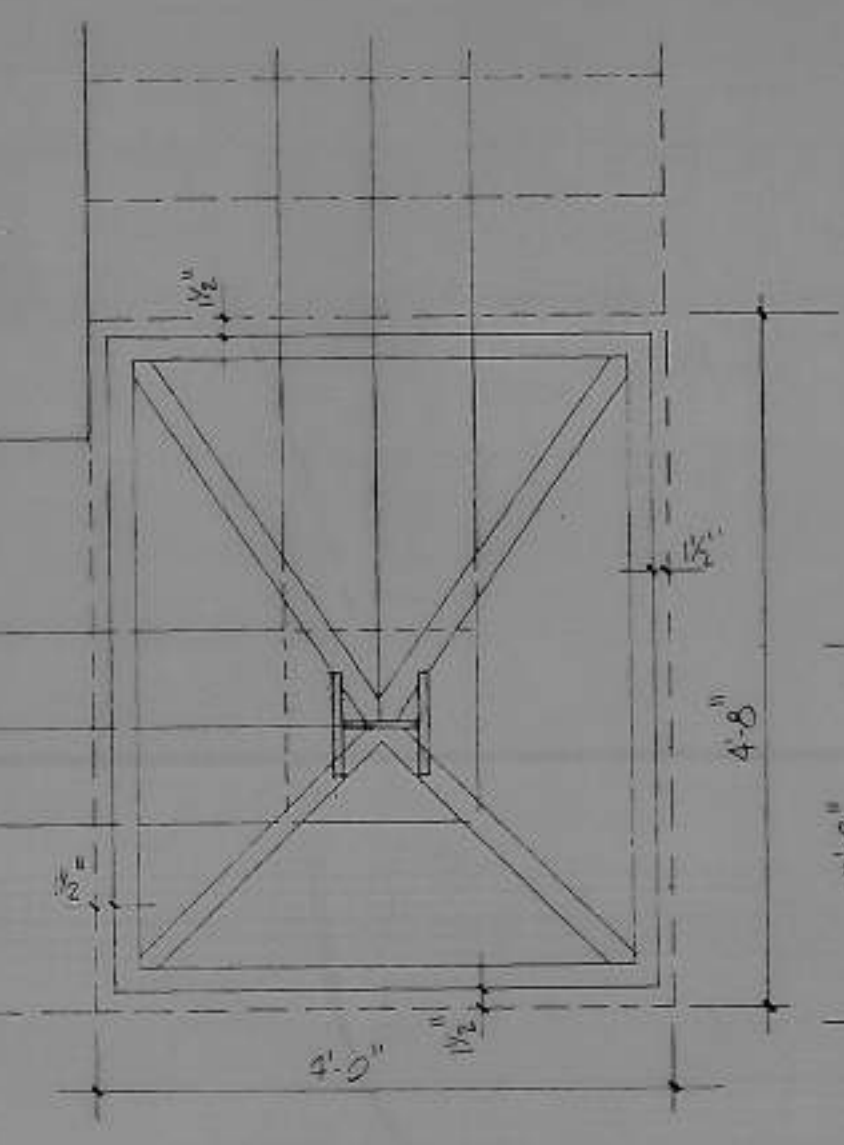


DETAIL ELEV. 9.05
SCALE 3/4" = 12"

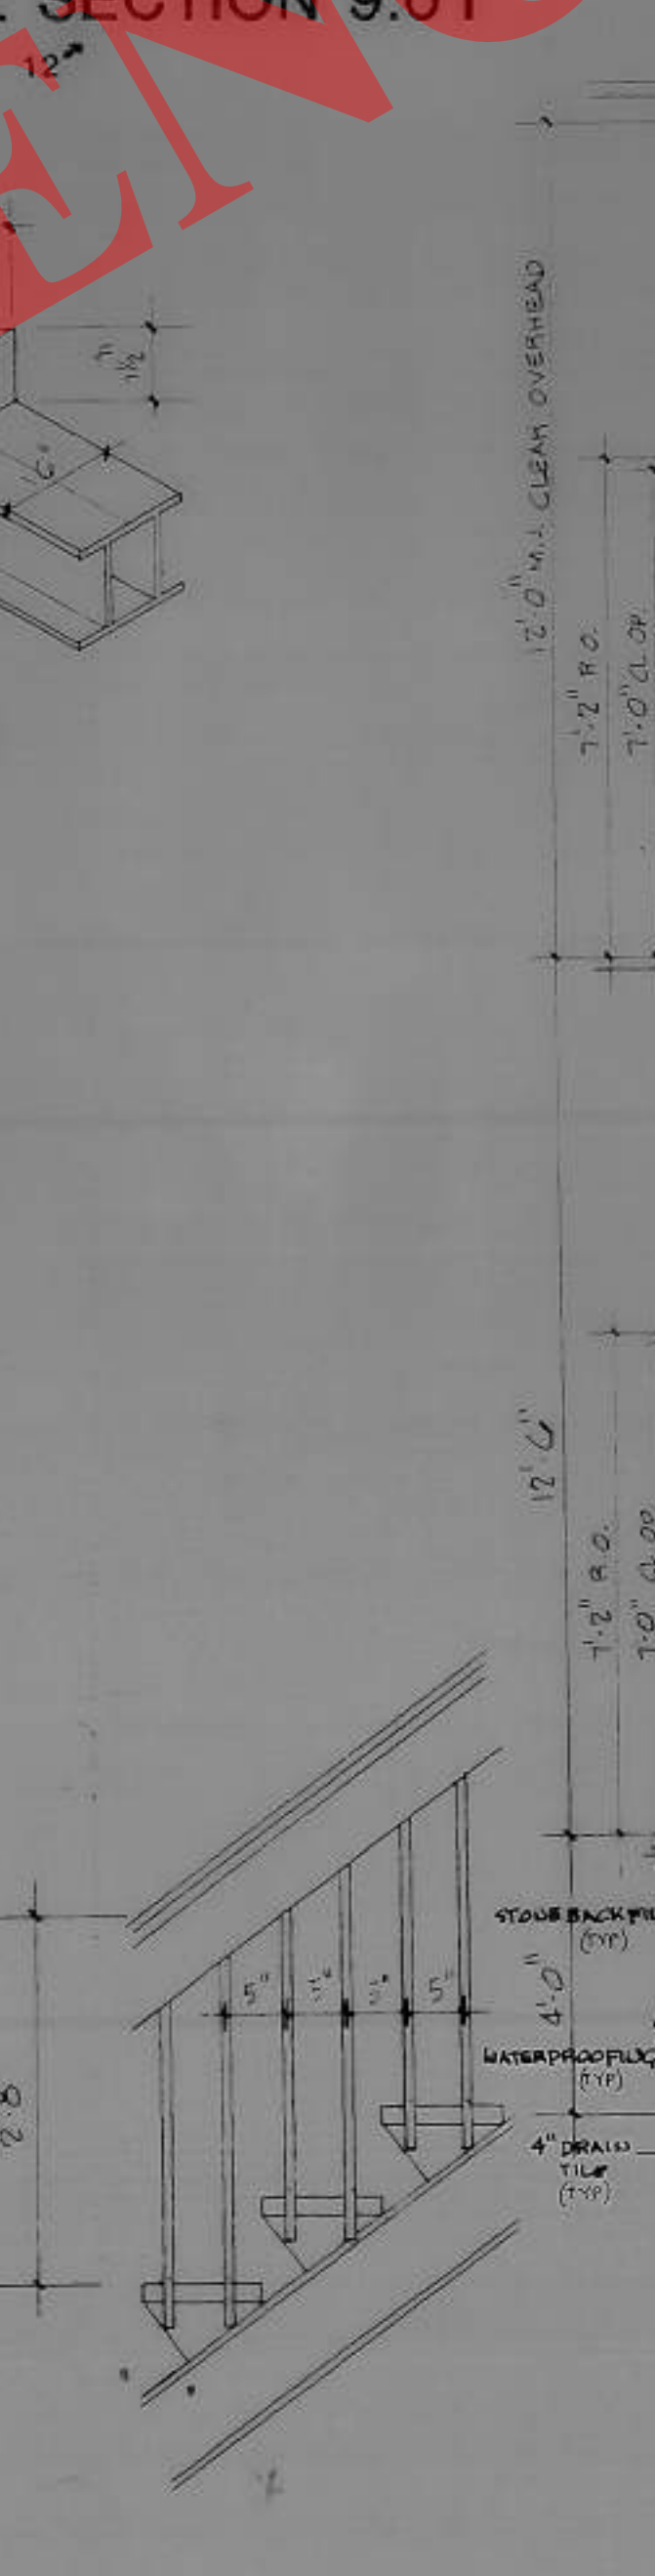


DETAIL SECTION 9.02
SCALE 3/4" = 12"

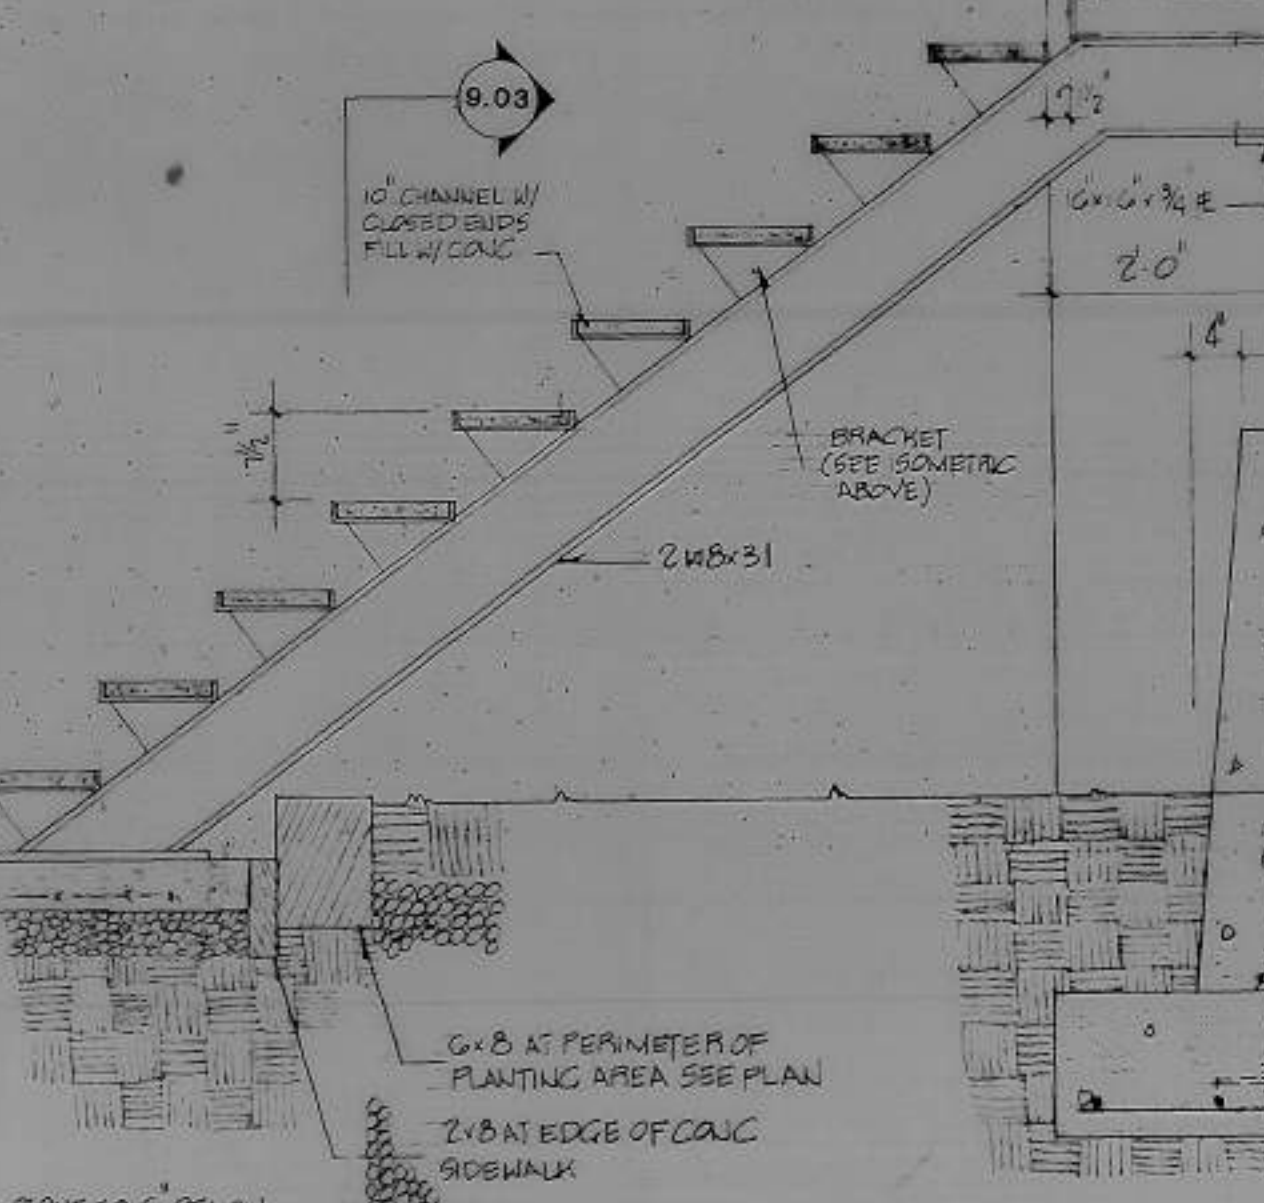


DETAIL SECTION 9.07
SCALE 3/8" = 12"

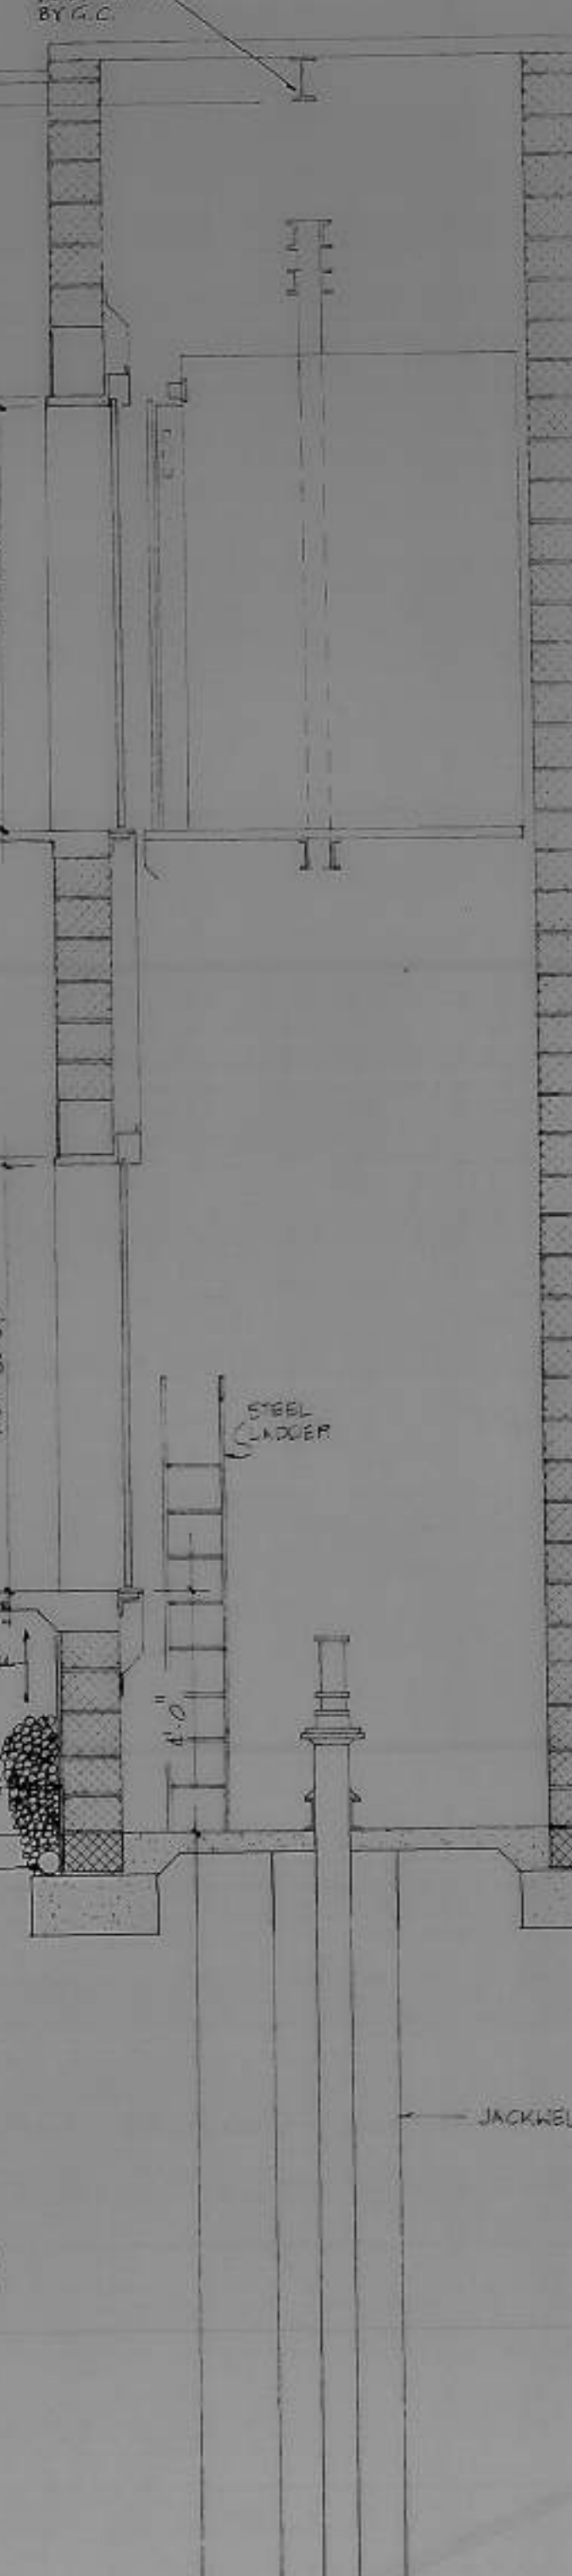


DETAIL SECTION 9.08
SCALE 3/8" = 12"

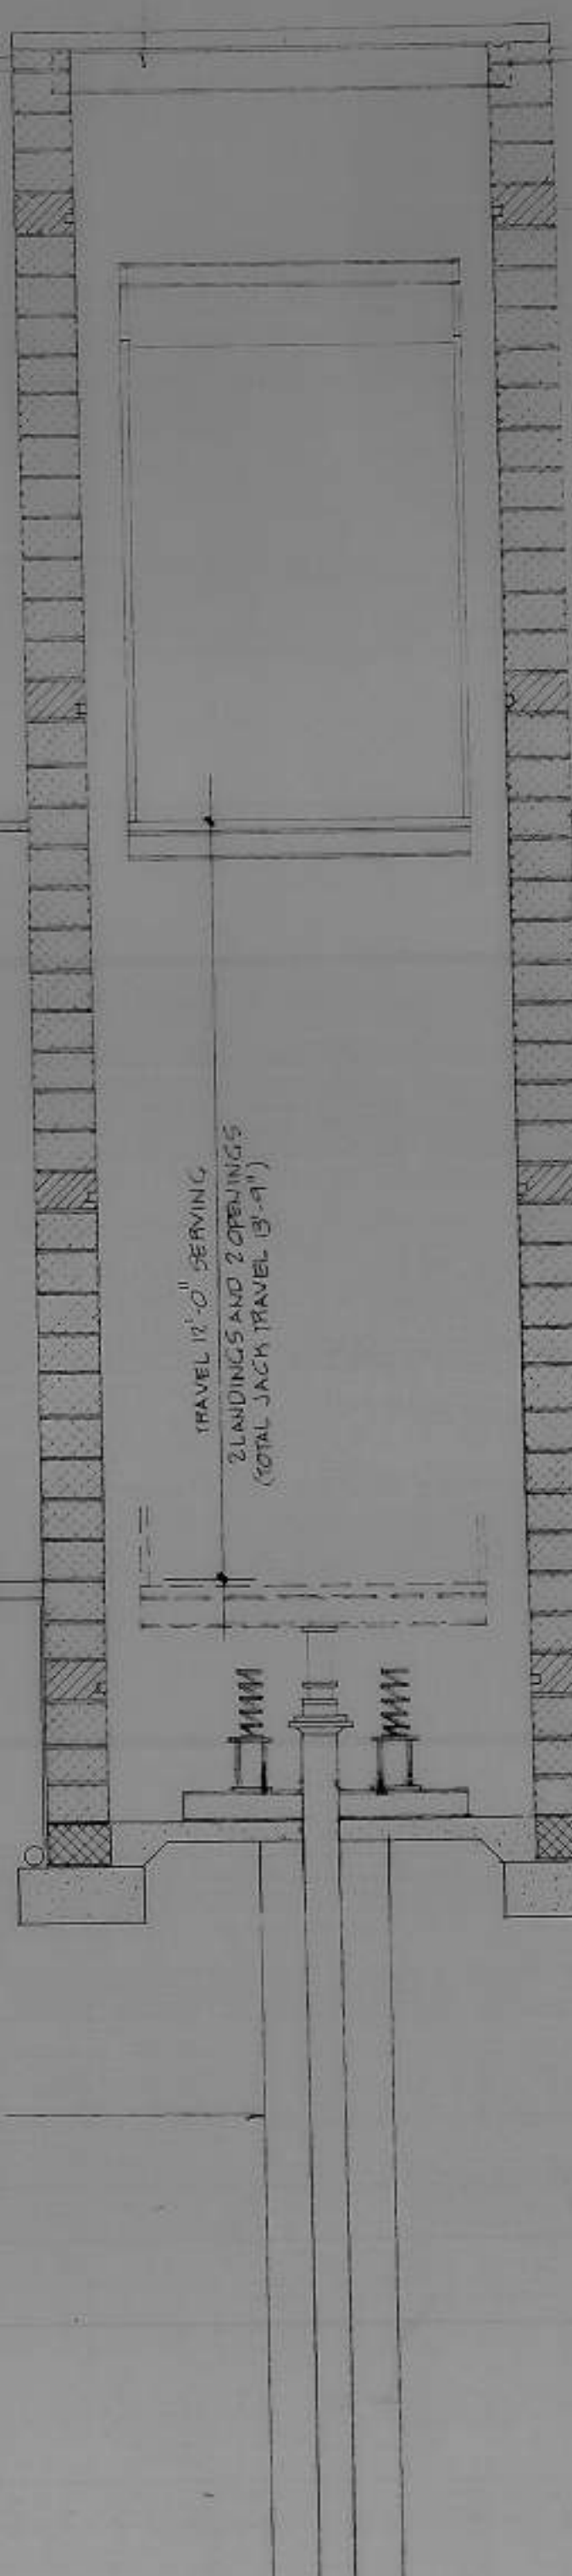


DETAIL PLAN AT ELEV. MECH.
SCALE 1/2" = 12"

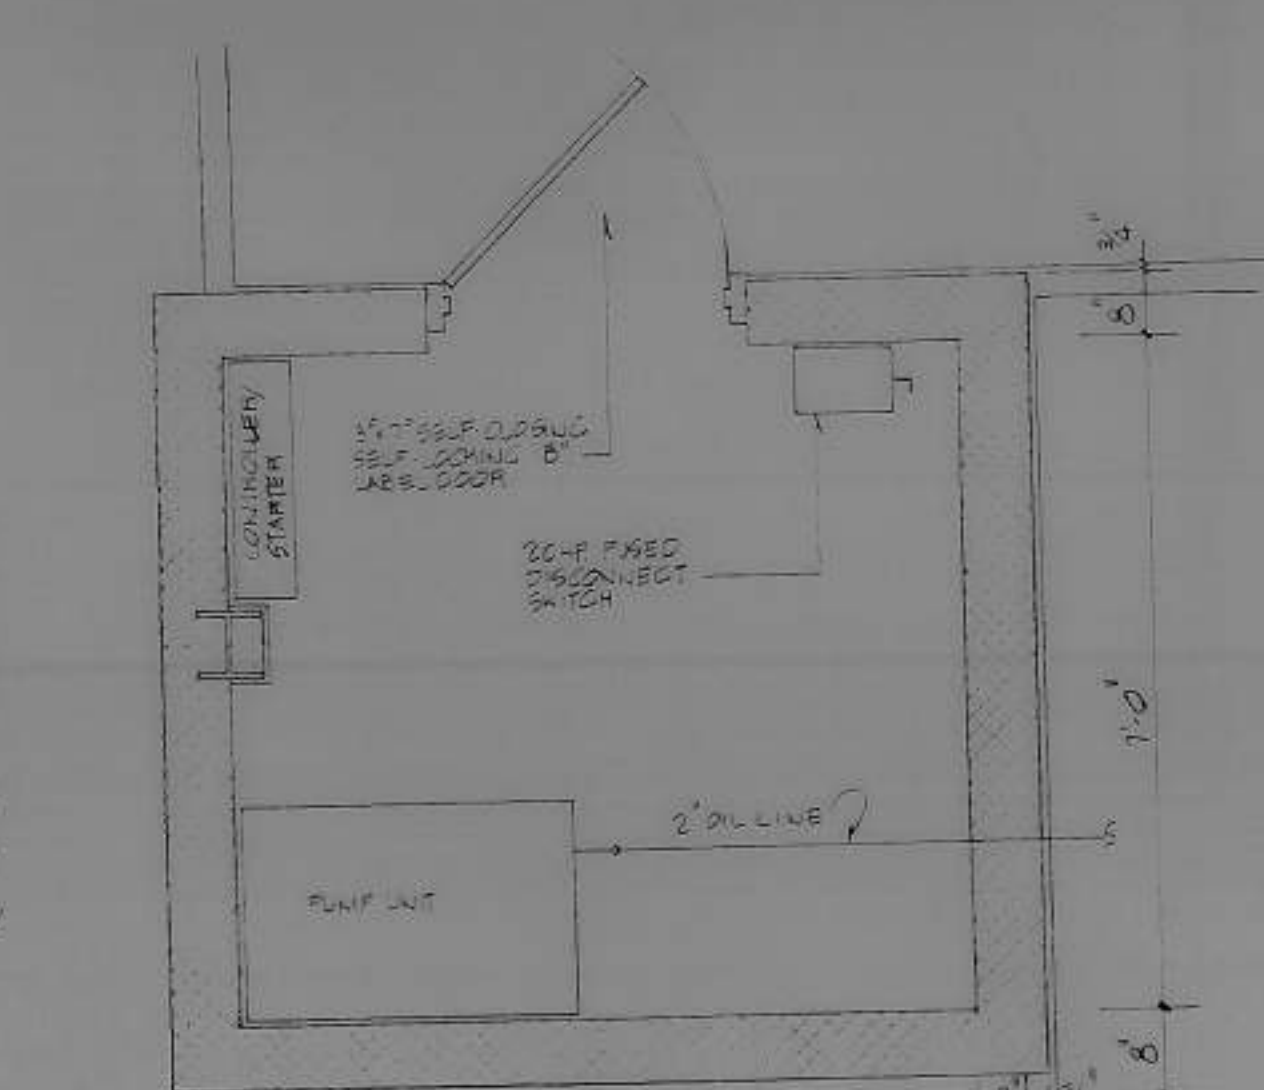


DETAIL PLAN AT ELEV.
SCALE 1/2" = 12"

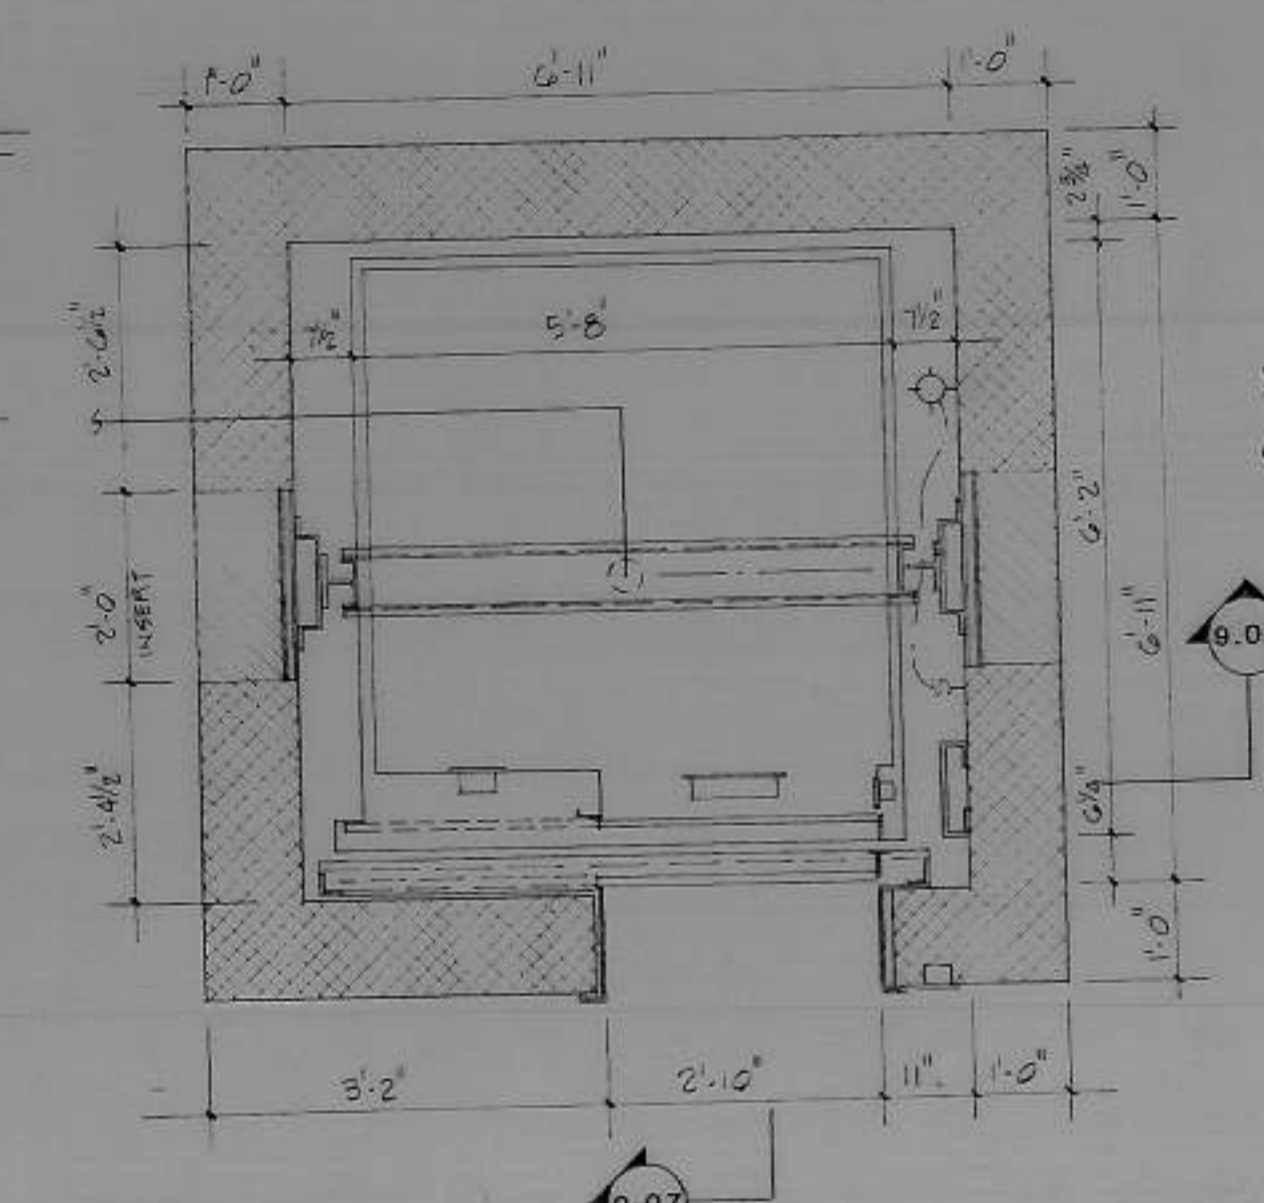


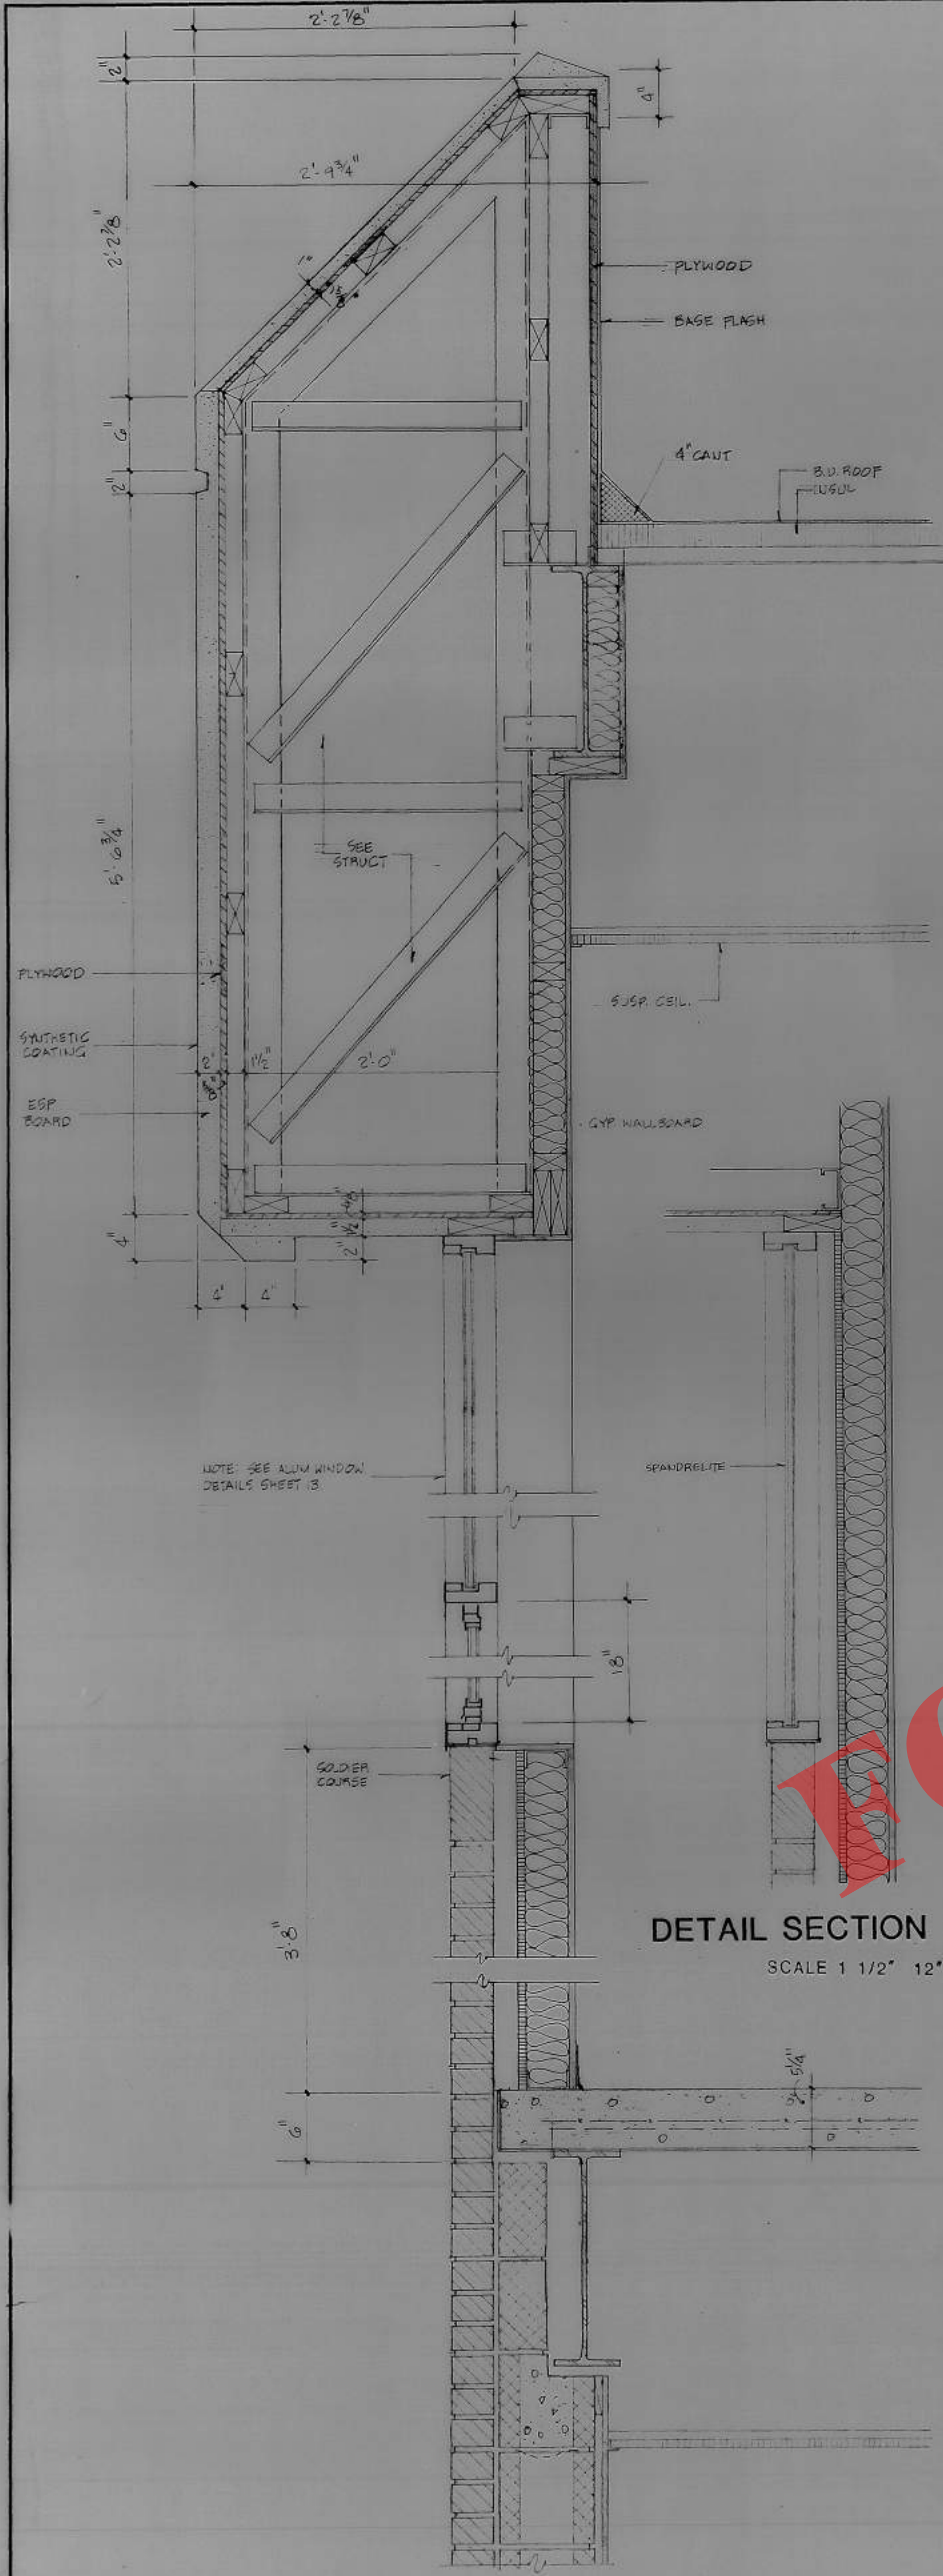

DETAIL SECTION 10.01
SCALE 1 1/2" = 12"

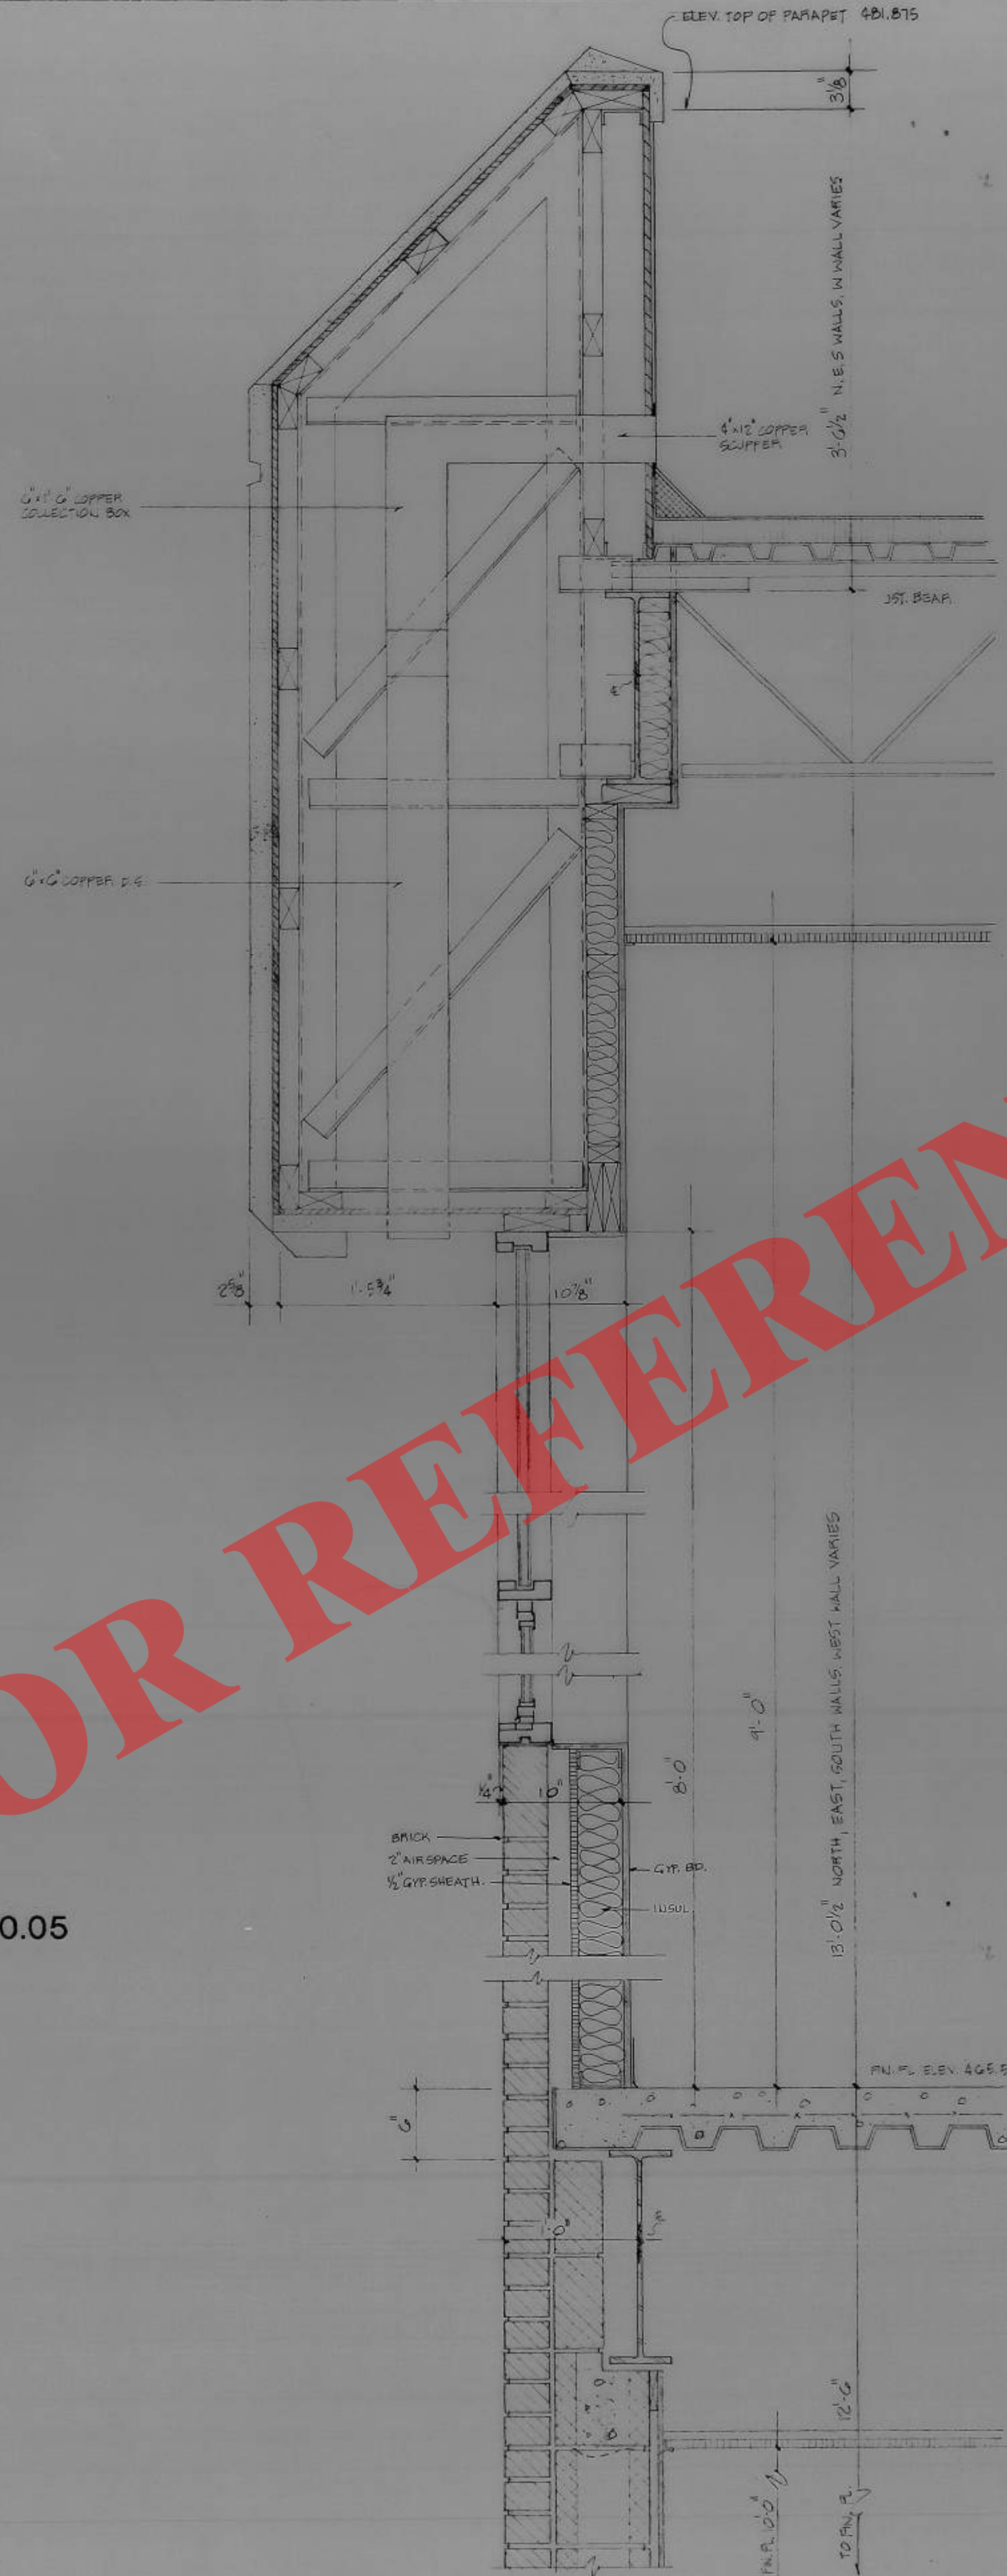


DETAIL SECTION 10.02
SCALE 1 1/2" = 12"

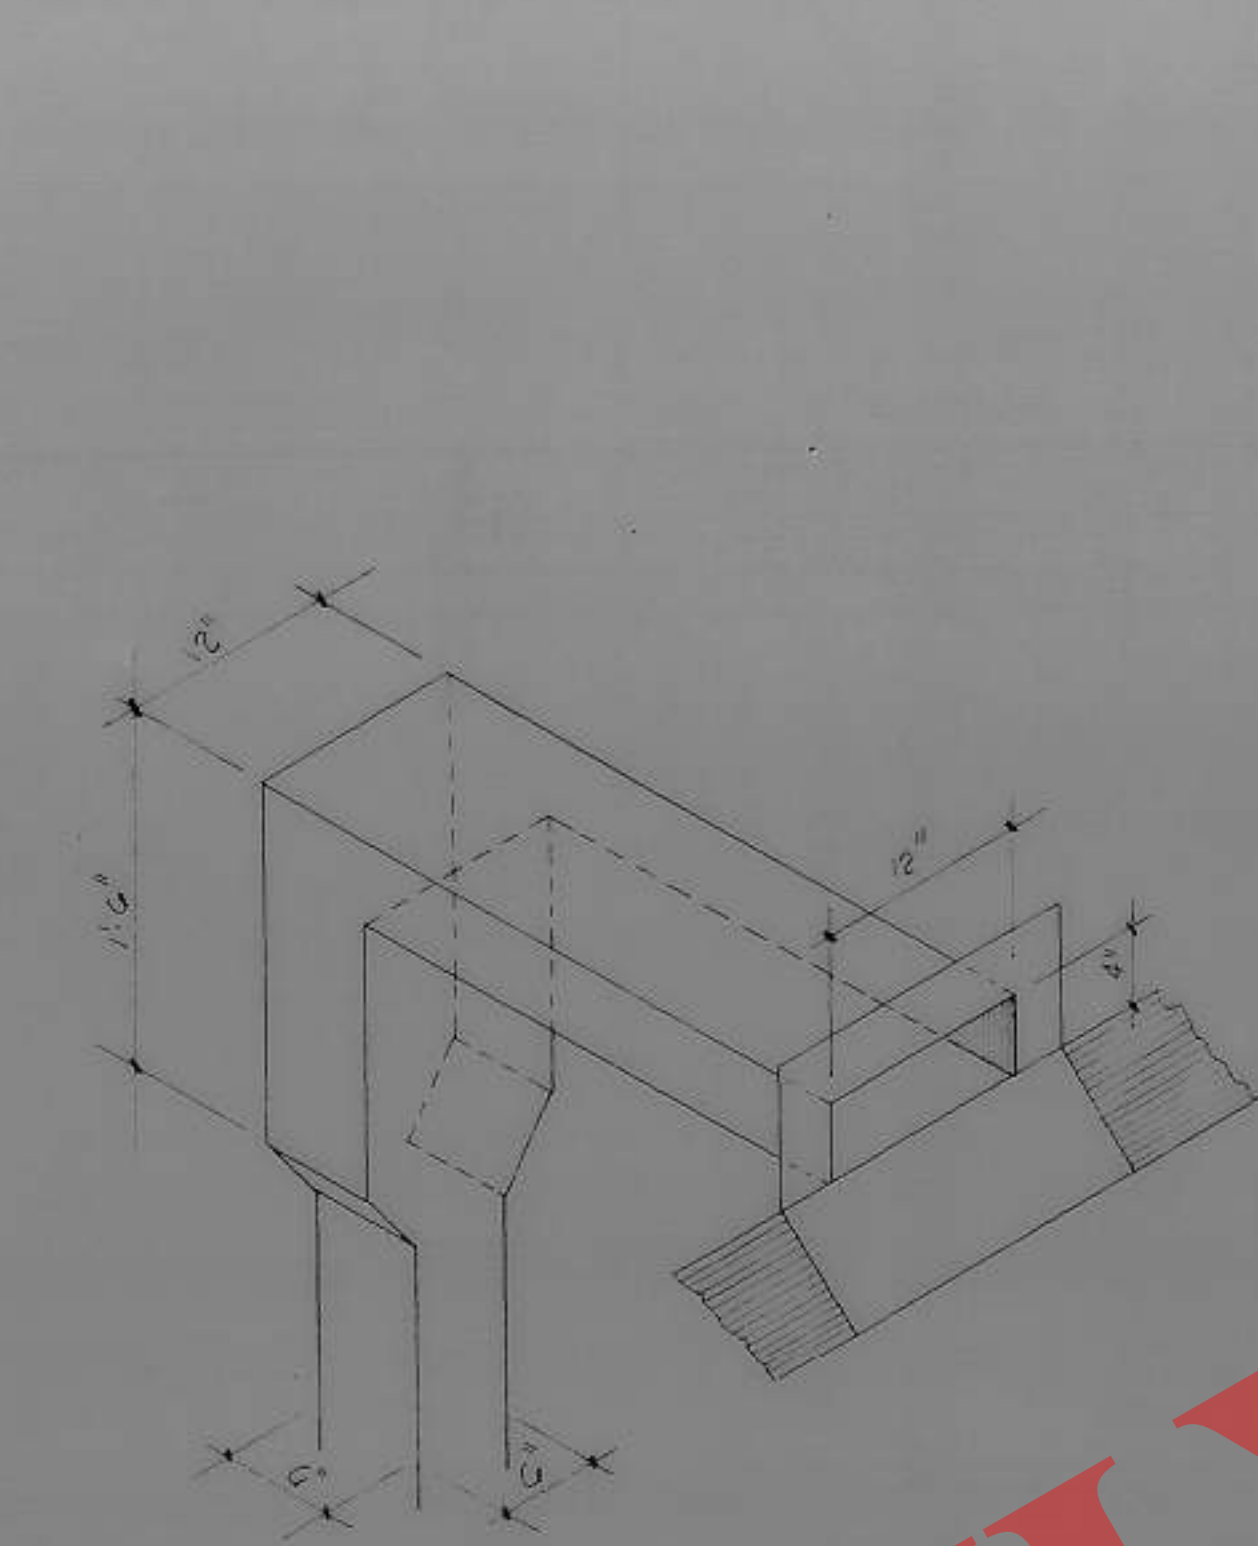

WHERE BACKUP DIA 208 BY DRAIN WALL SHALL BE 12 GAUGE
3/4\"/>

D/A 208


ISOMETRIC AT SCUPPER
NO SCALE

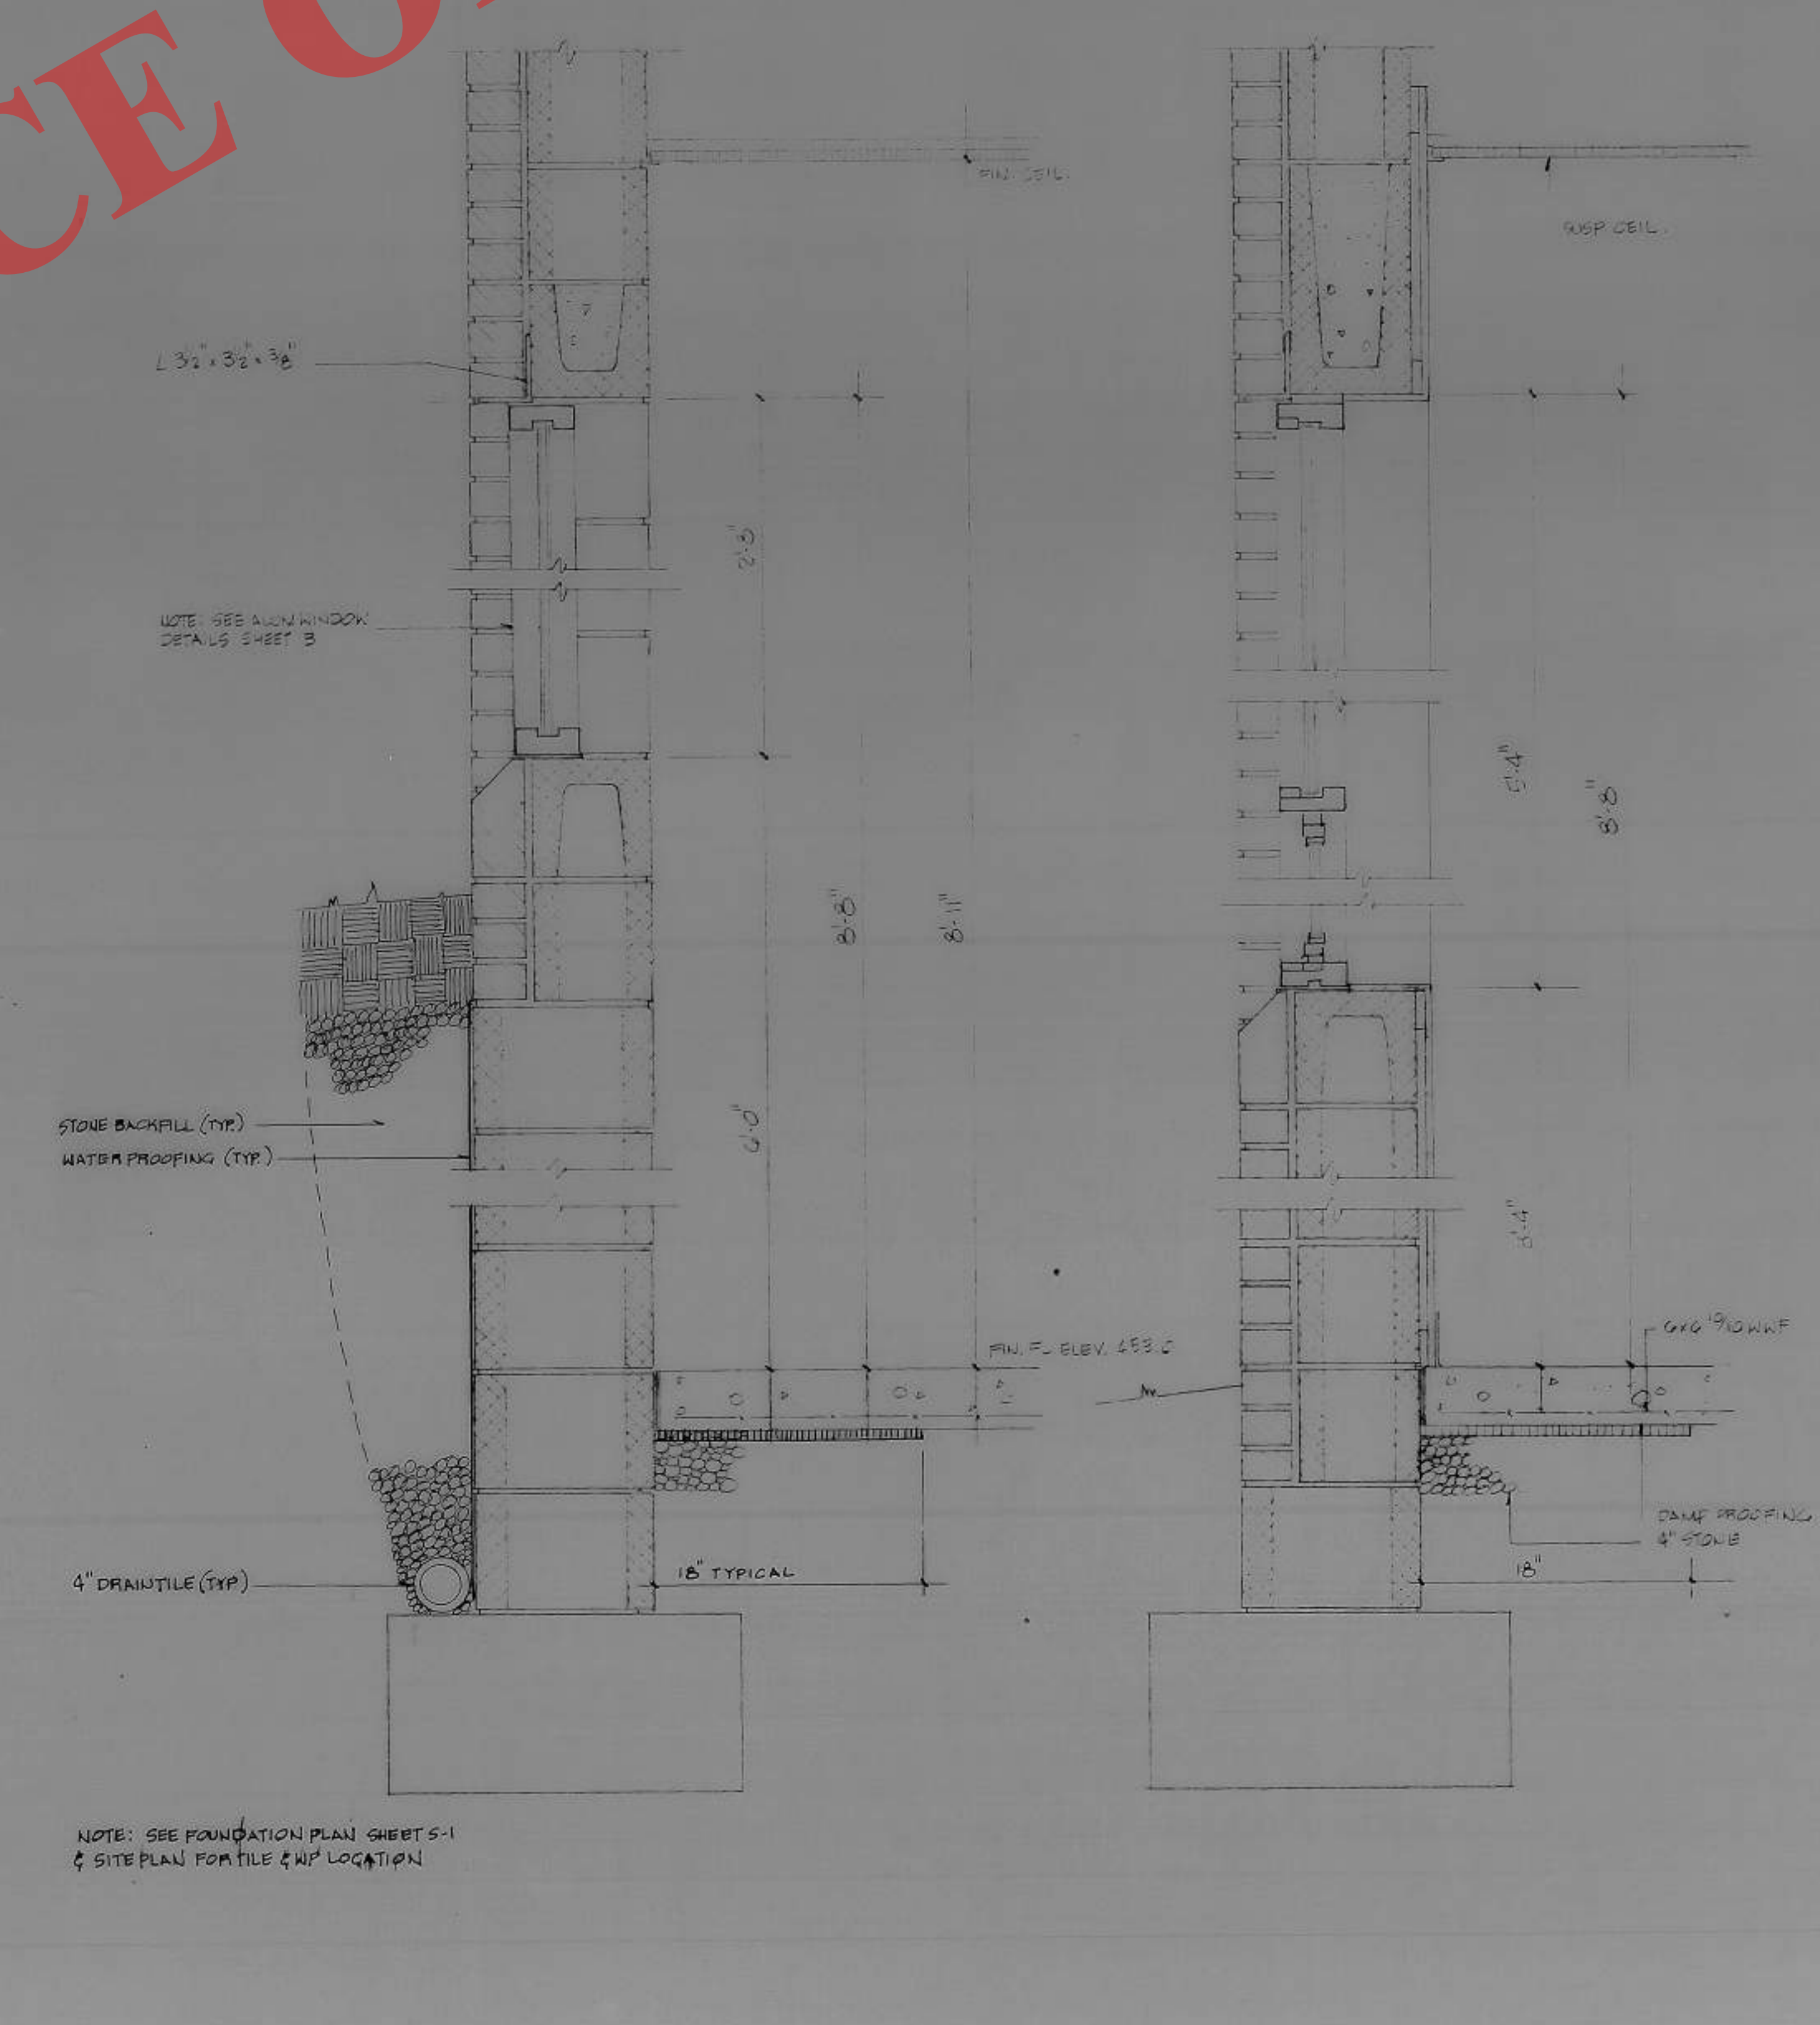

DETAIL SECTION 10.03
SCALE 1 1/2" = 12"


DETAIL SECTION 10.04
SCALE 1 1/2" = 12"

FOR REFERENCE ONLY


 city planning and
 architectural associates
 architects : planners
 chapel hill, n.c.
 919/777-7154


O.W.S.A. OPERATIONS CENTER
 CARRBORO, NORTH CAROLINA
 DETAIL SECTIONS

sheet no. 10
 job no. 549
 AS BUILT 8/17/90

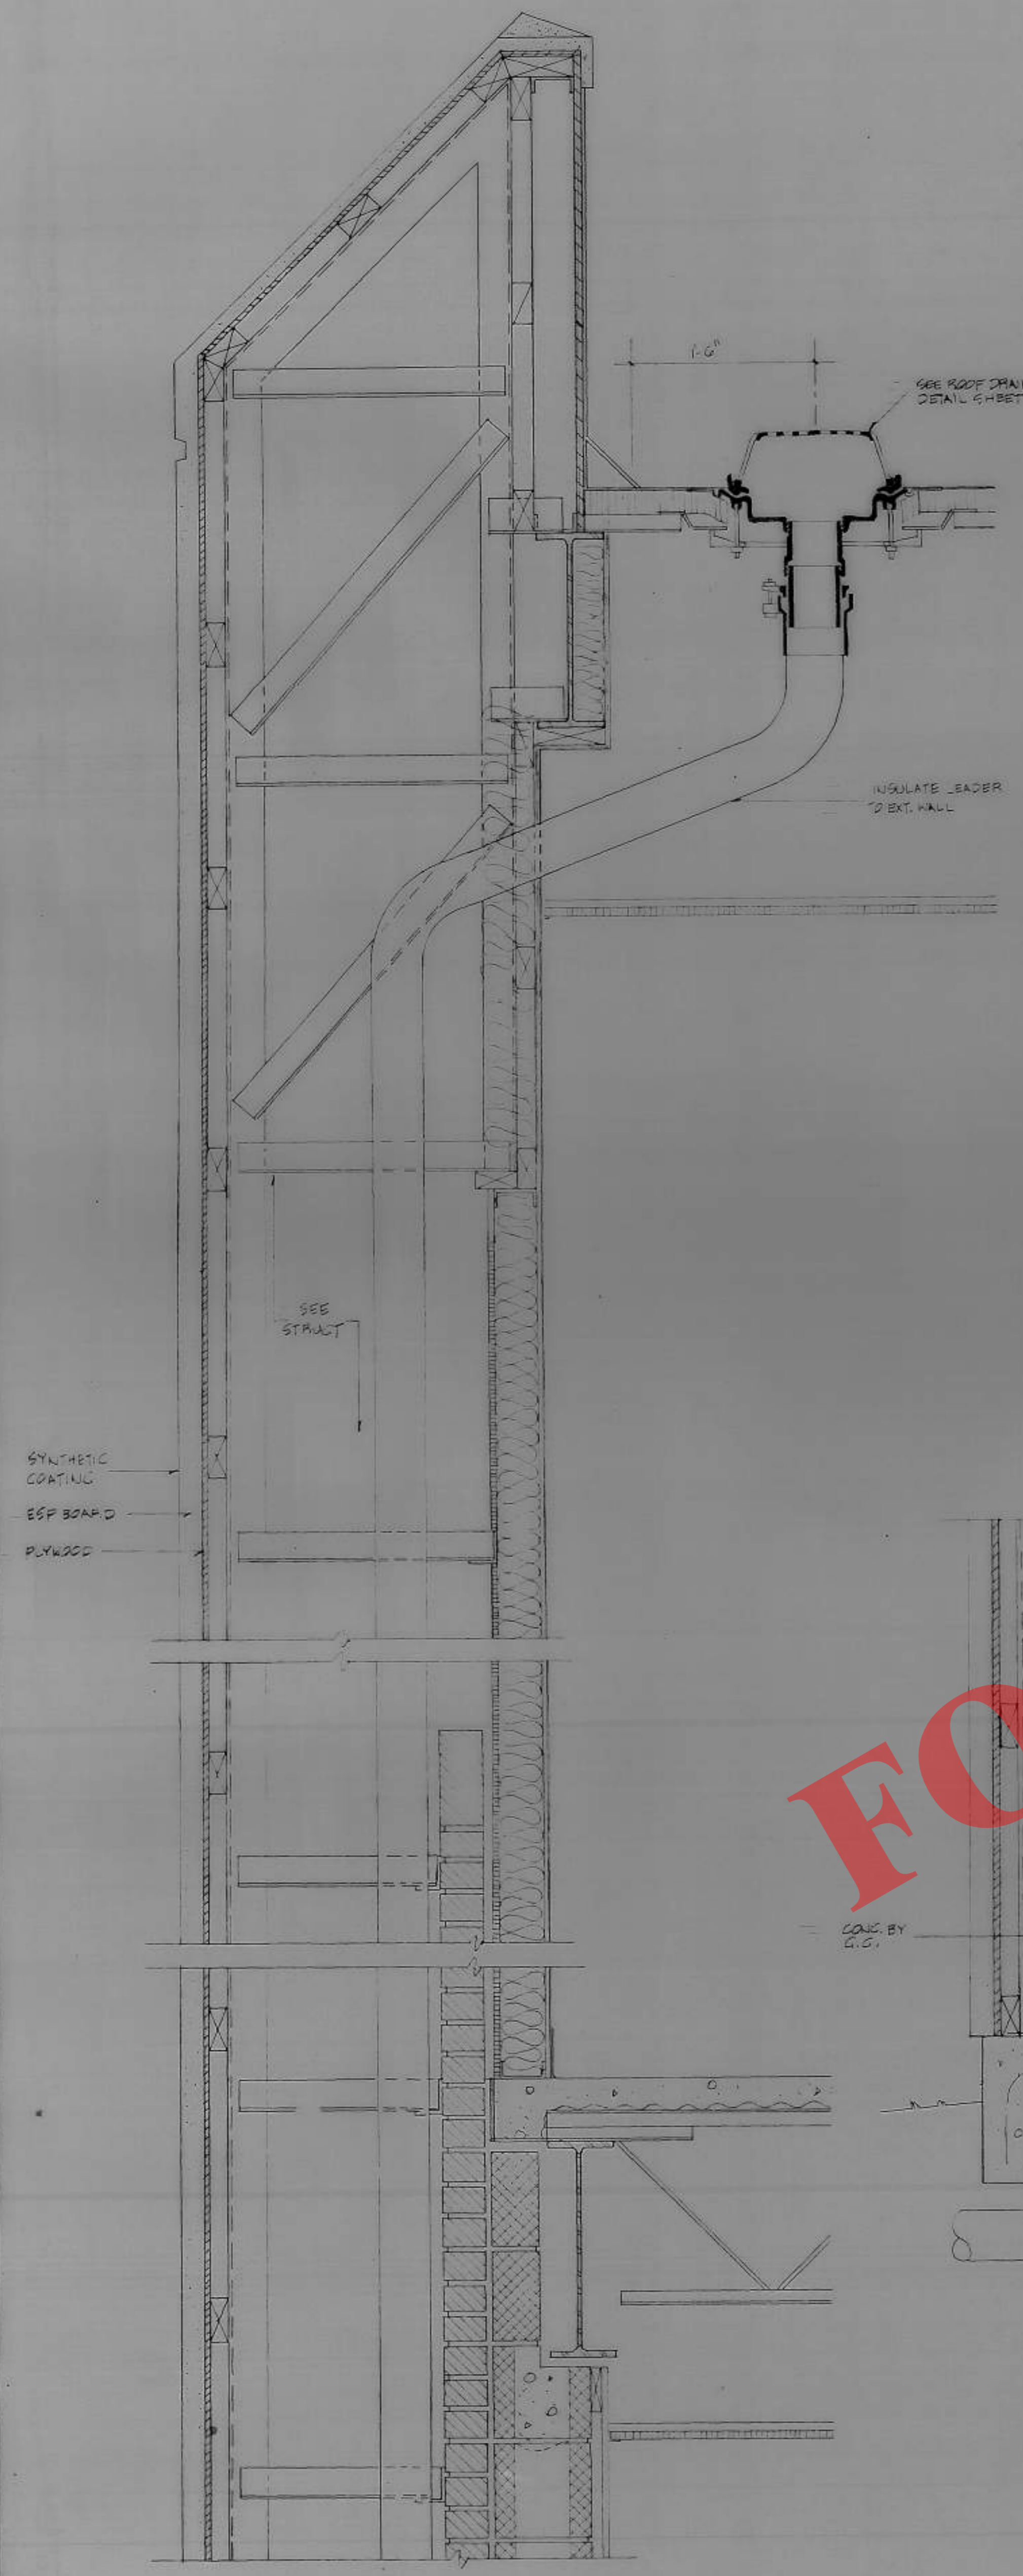


DETAIL SECTION 11.01
SCALE 1 1/2" = 12"

FOR REFERENCE ONLY

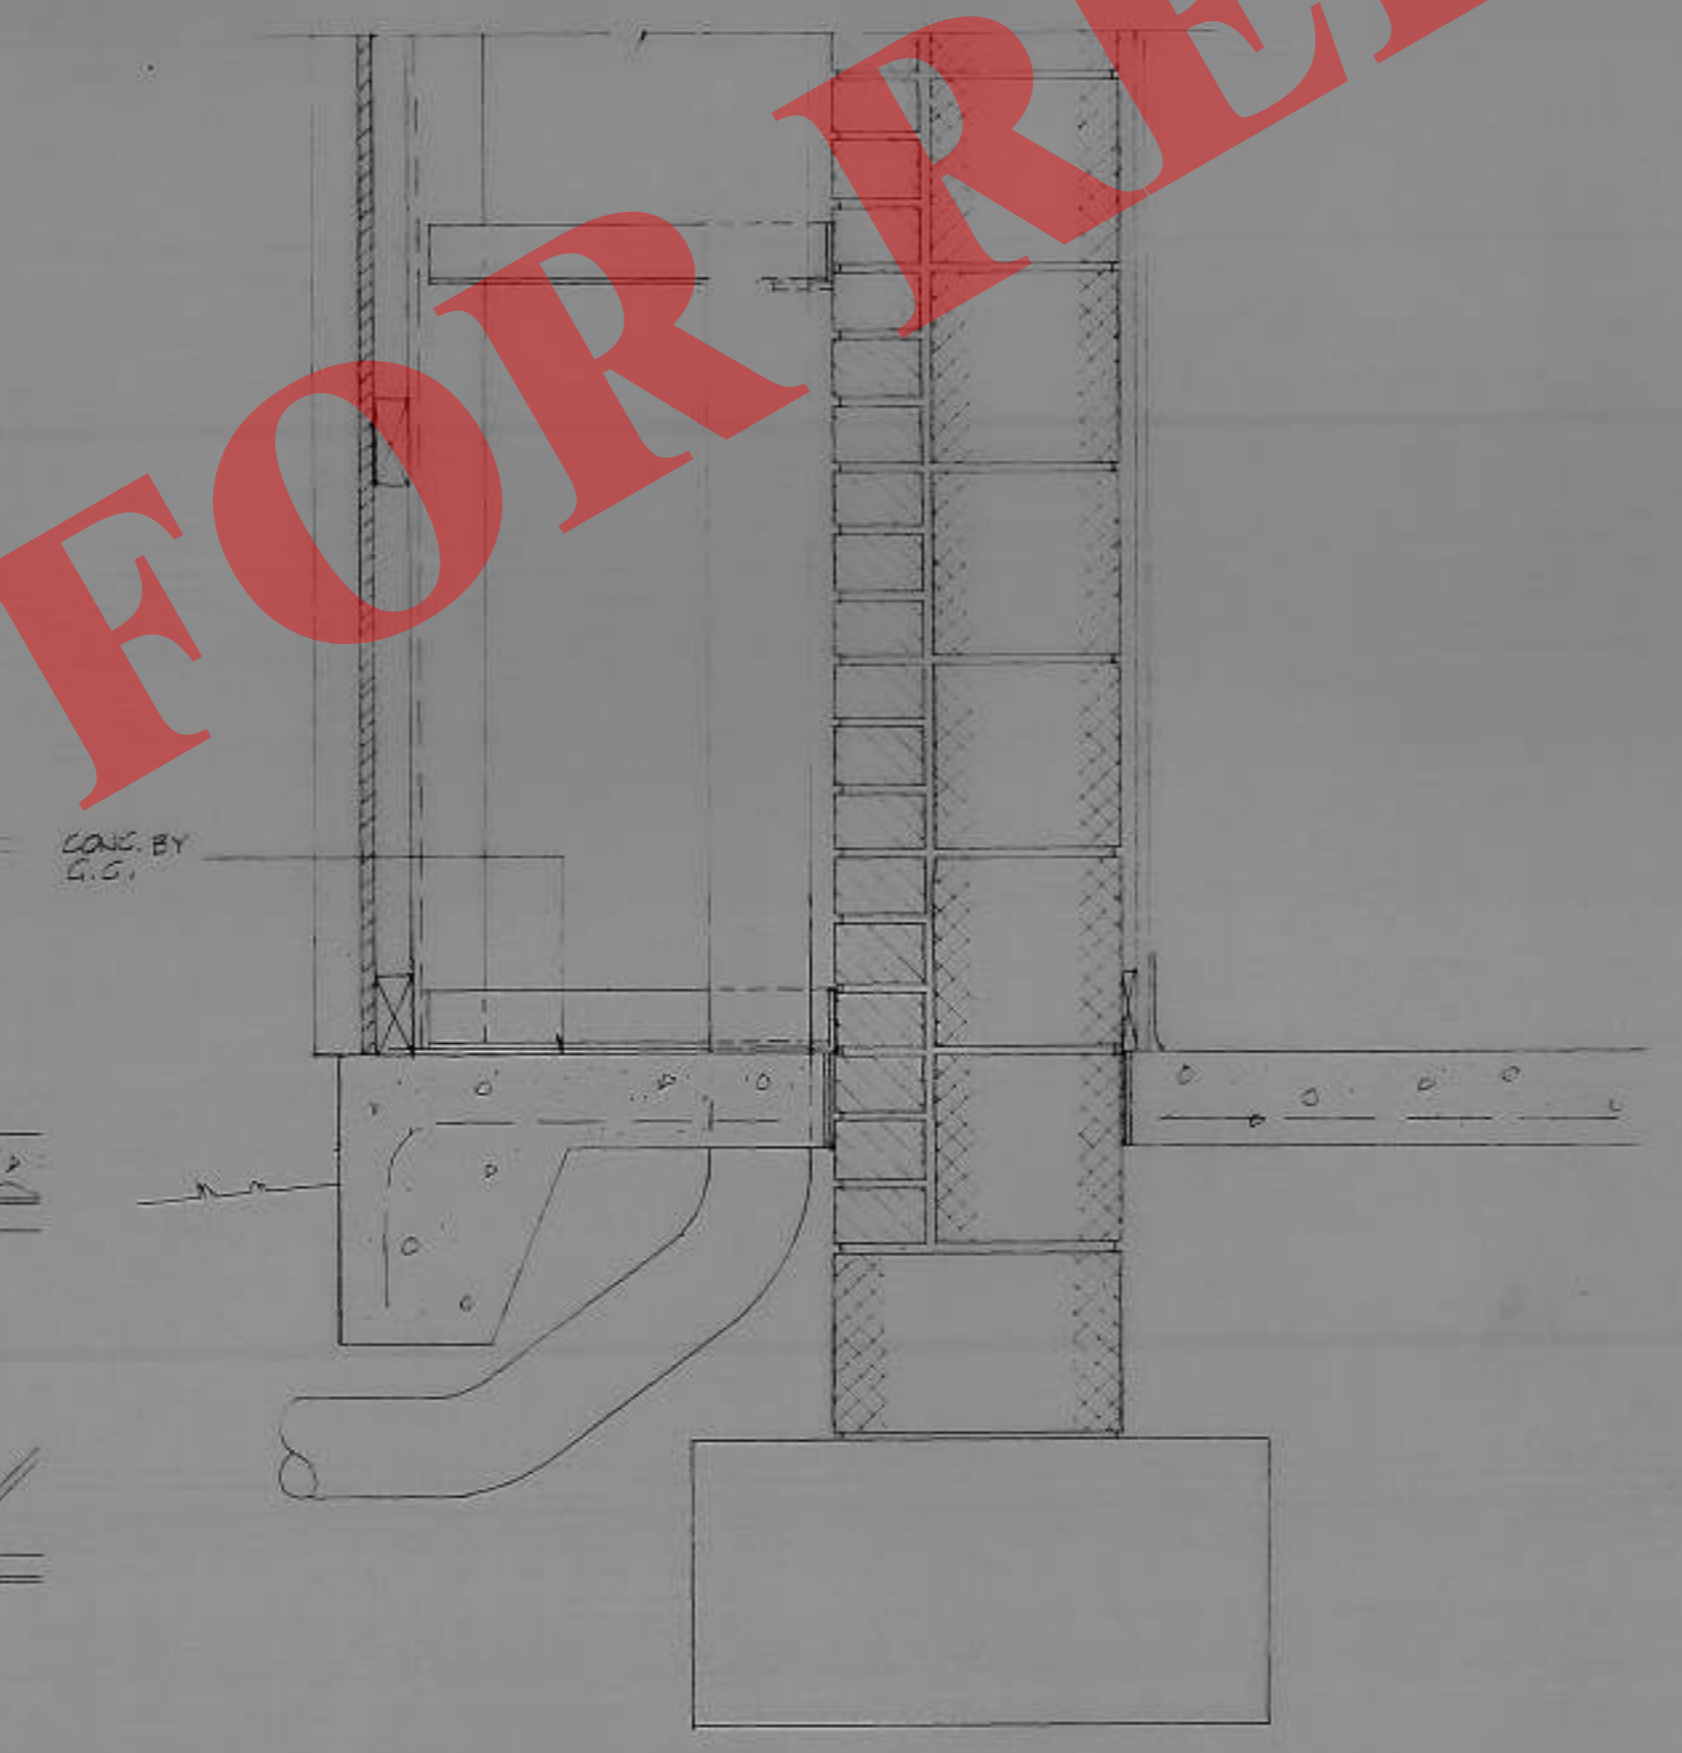

DETAIL SECTION 11.02
SCALE 1 1/2" = 12"

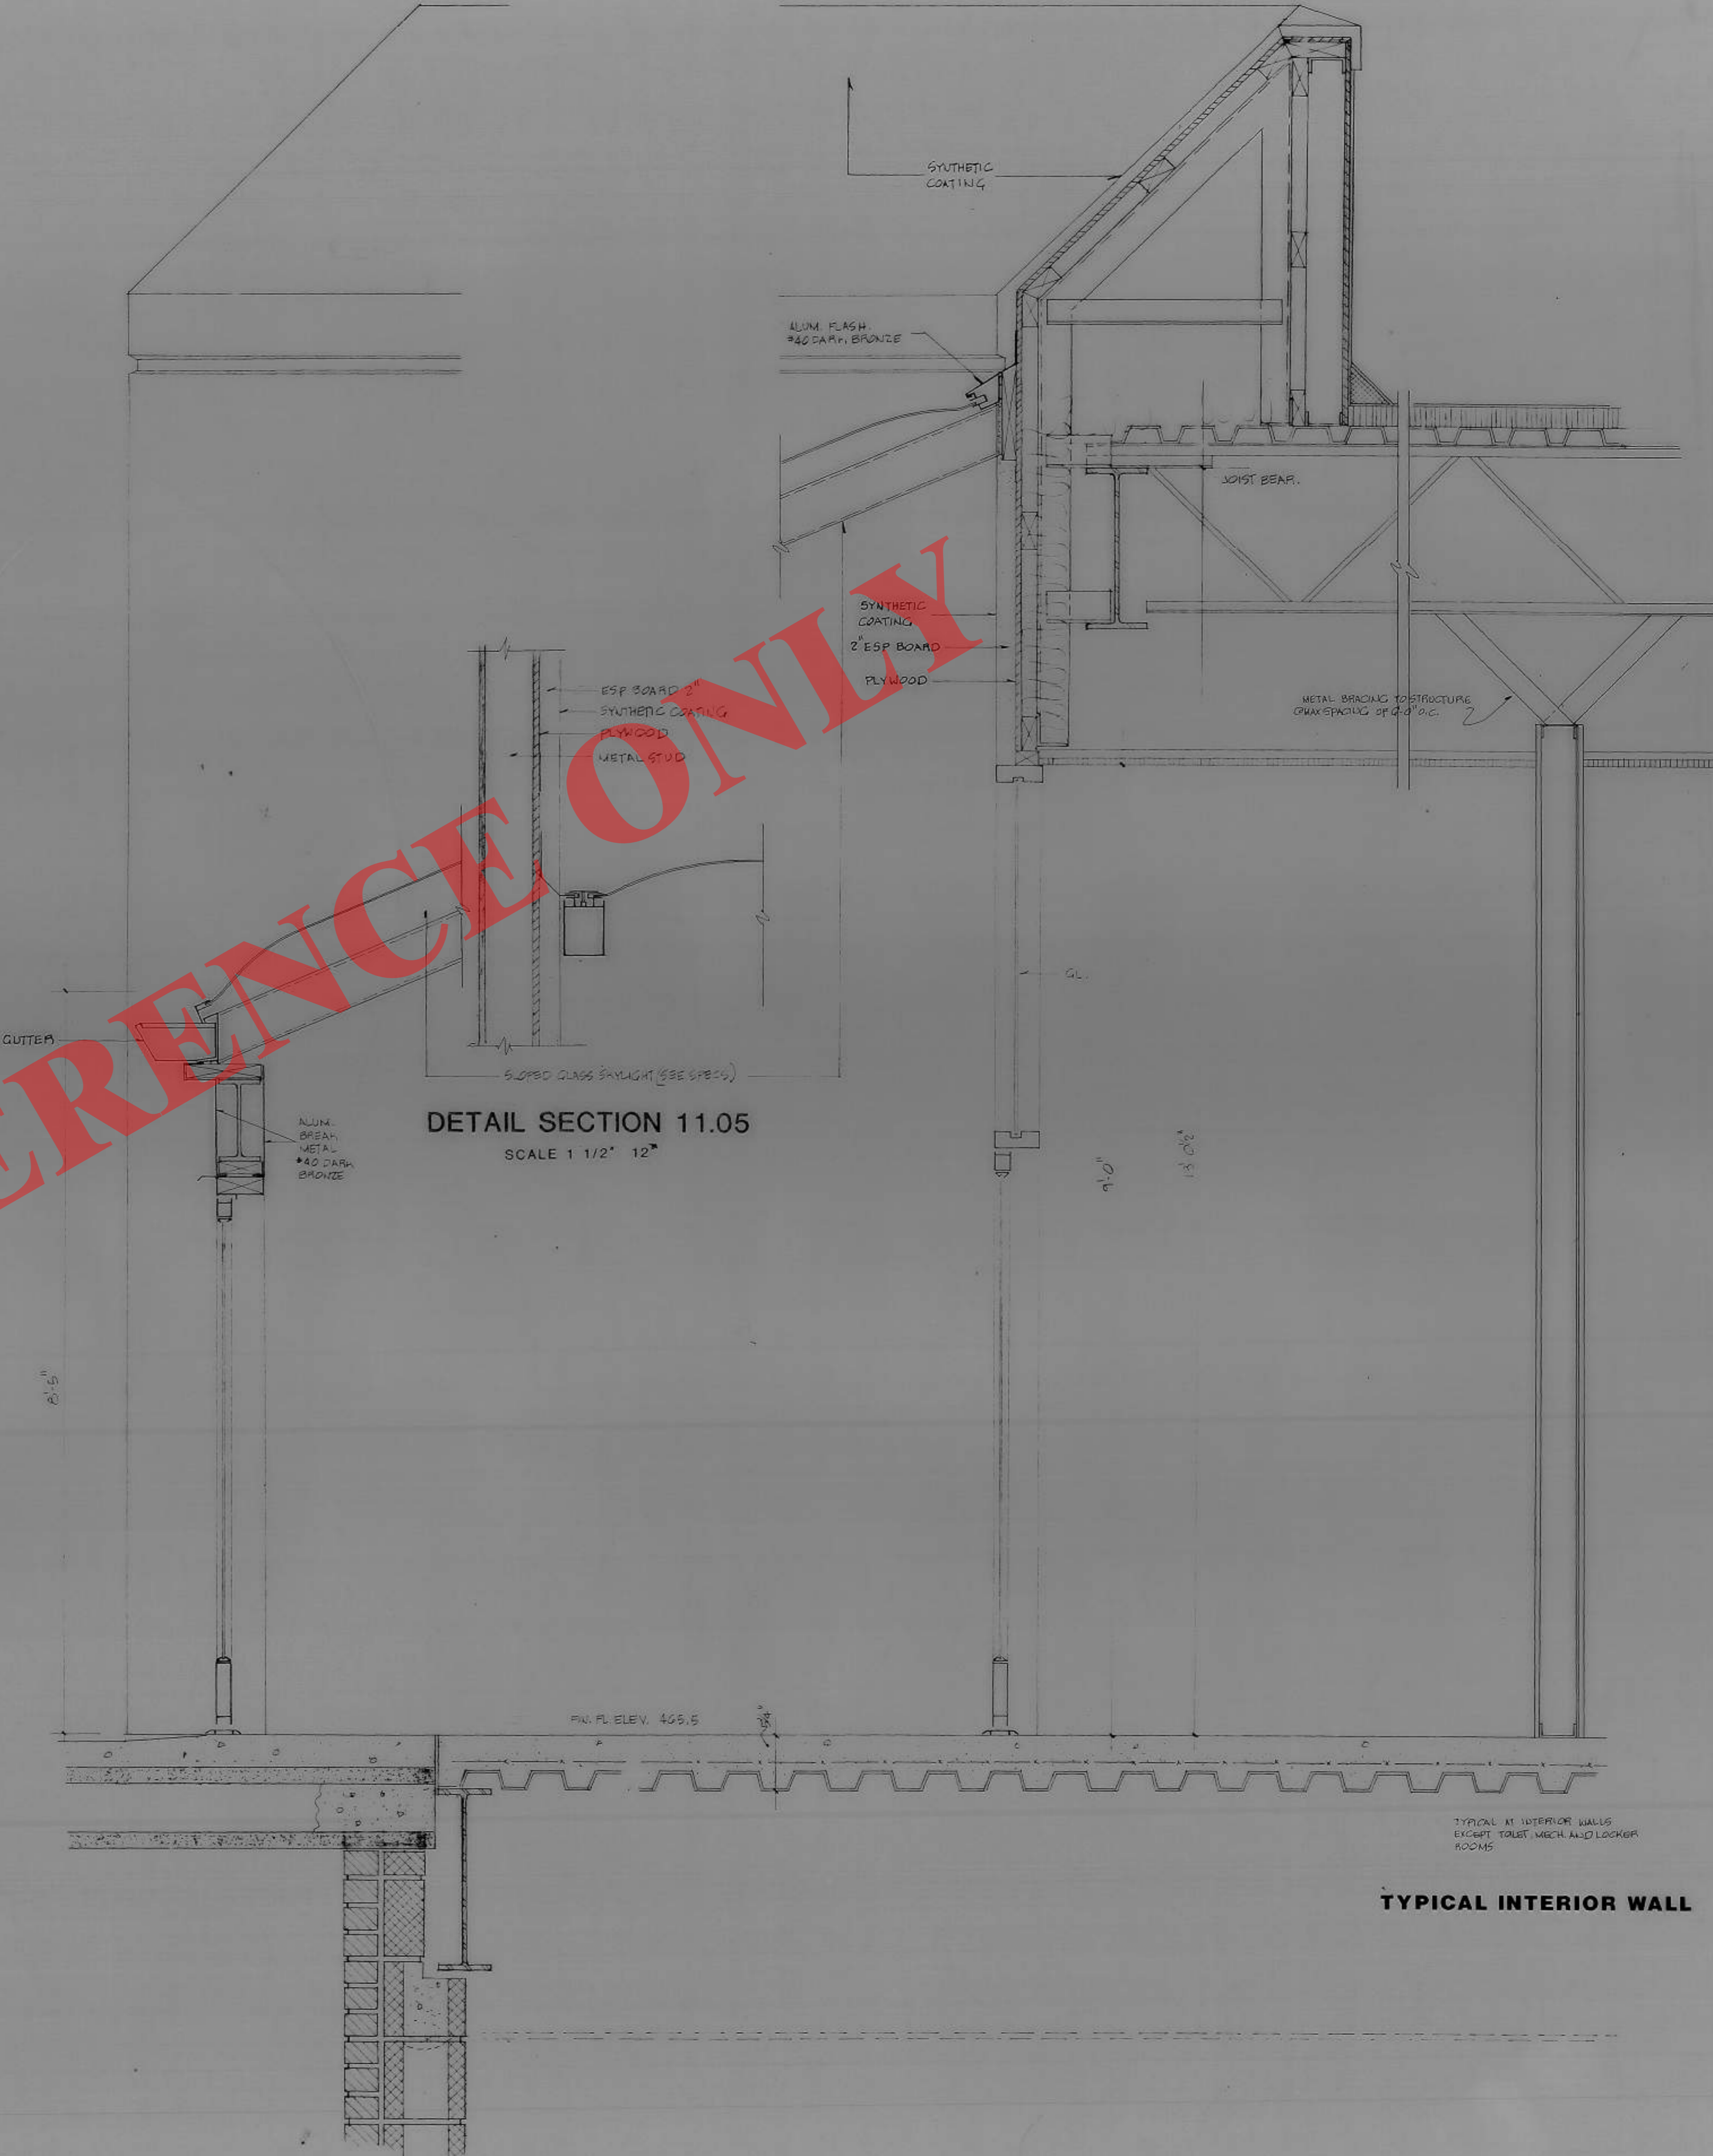

DETAIL SECTION 11.03
SCALE 1 1/2" = 12"

DETAIL SECTION 11.04
SCALE 1 1/2" = 12"

TYPICAL AT INTERIOR WALLS EXCEPT TOILET MACH. AND LOCKER ROOMS

O.W.A.S.A. OPERATIONS CENTER
 CARRBORO, NORTH CAROLINA
 DETAIL SECTIONS


cpaa
 city planning and architectural associates
 architects : planners
 chapel hill, n.c. 27514

DATE: DECEMBER, 1988
 DRAWN BY:
 CHECKED BY:

REVISIONS:

sheet no.
11

job no. 549
 AS BUILT 8/17/90

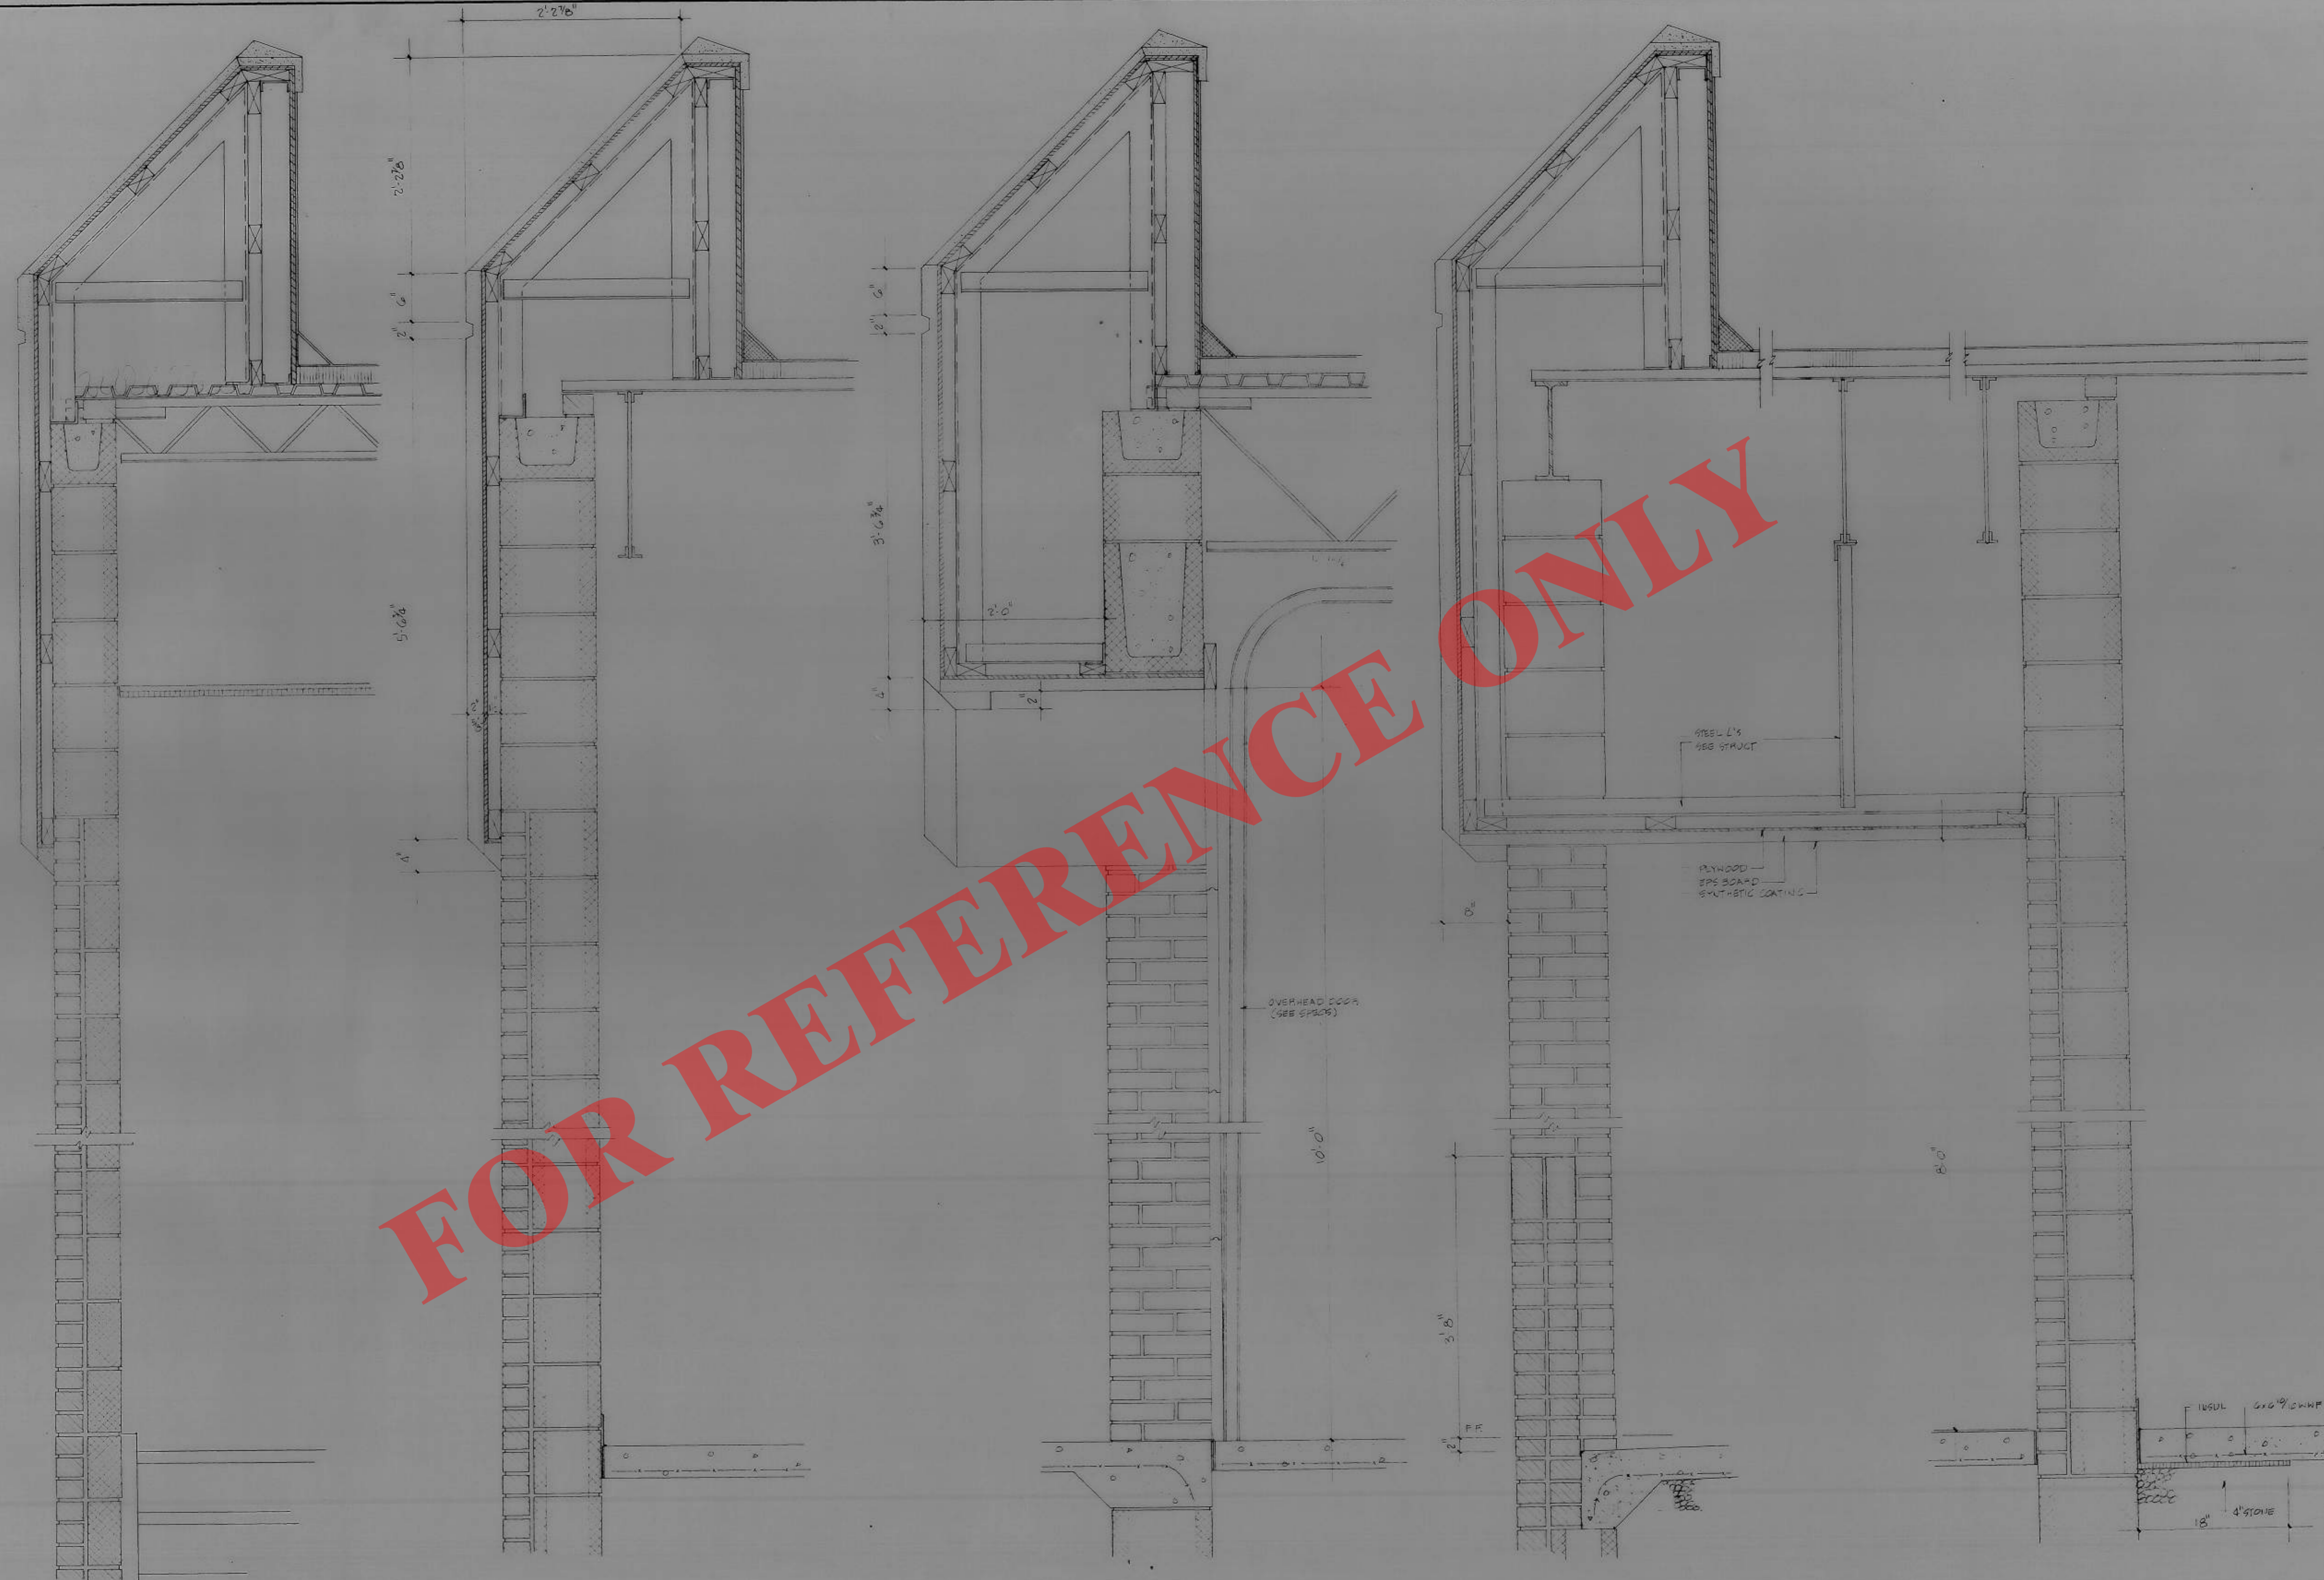

DETAIL SECTION 12.01
SCALE 1 1/2" 12"

DETAIL SECTION 12.02
SCALE 1 1/2" 12"

DETAIL SECTION 12.03
SCALE 1 1/2" 12"

DETAIL SECTION 12.04
SCALE 1 1/2" 12"

DETAIL SECTION 12.05
SCALE 1 1/2" 12"



cp aa
 architects
 chapel hill, n.c.


city, planning and
 architectural associates
 planners
 #12/22/1988

date: DECEMBER, 1988
 drawn by:
 checked by:


O.W.A.S.A. OPERATIONS CENTER
 CARRBORO, NORTH CAROLINA
 DETAIL SECTIONS

The use of these plans and specifications shall be restricted to the original project for which they were prepared. Any reproduction, or publication, in whole or in part, is prohibited. This is to be understood as a condition of the contract. The use of these plans and specifications shall be restricted to the original project for which they were prepared. Any reproduction, or publication, in whole or in part, is prohibited. This is to be understood as a condition of the contract.


Sheet no.
12

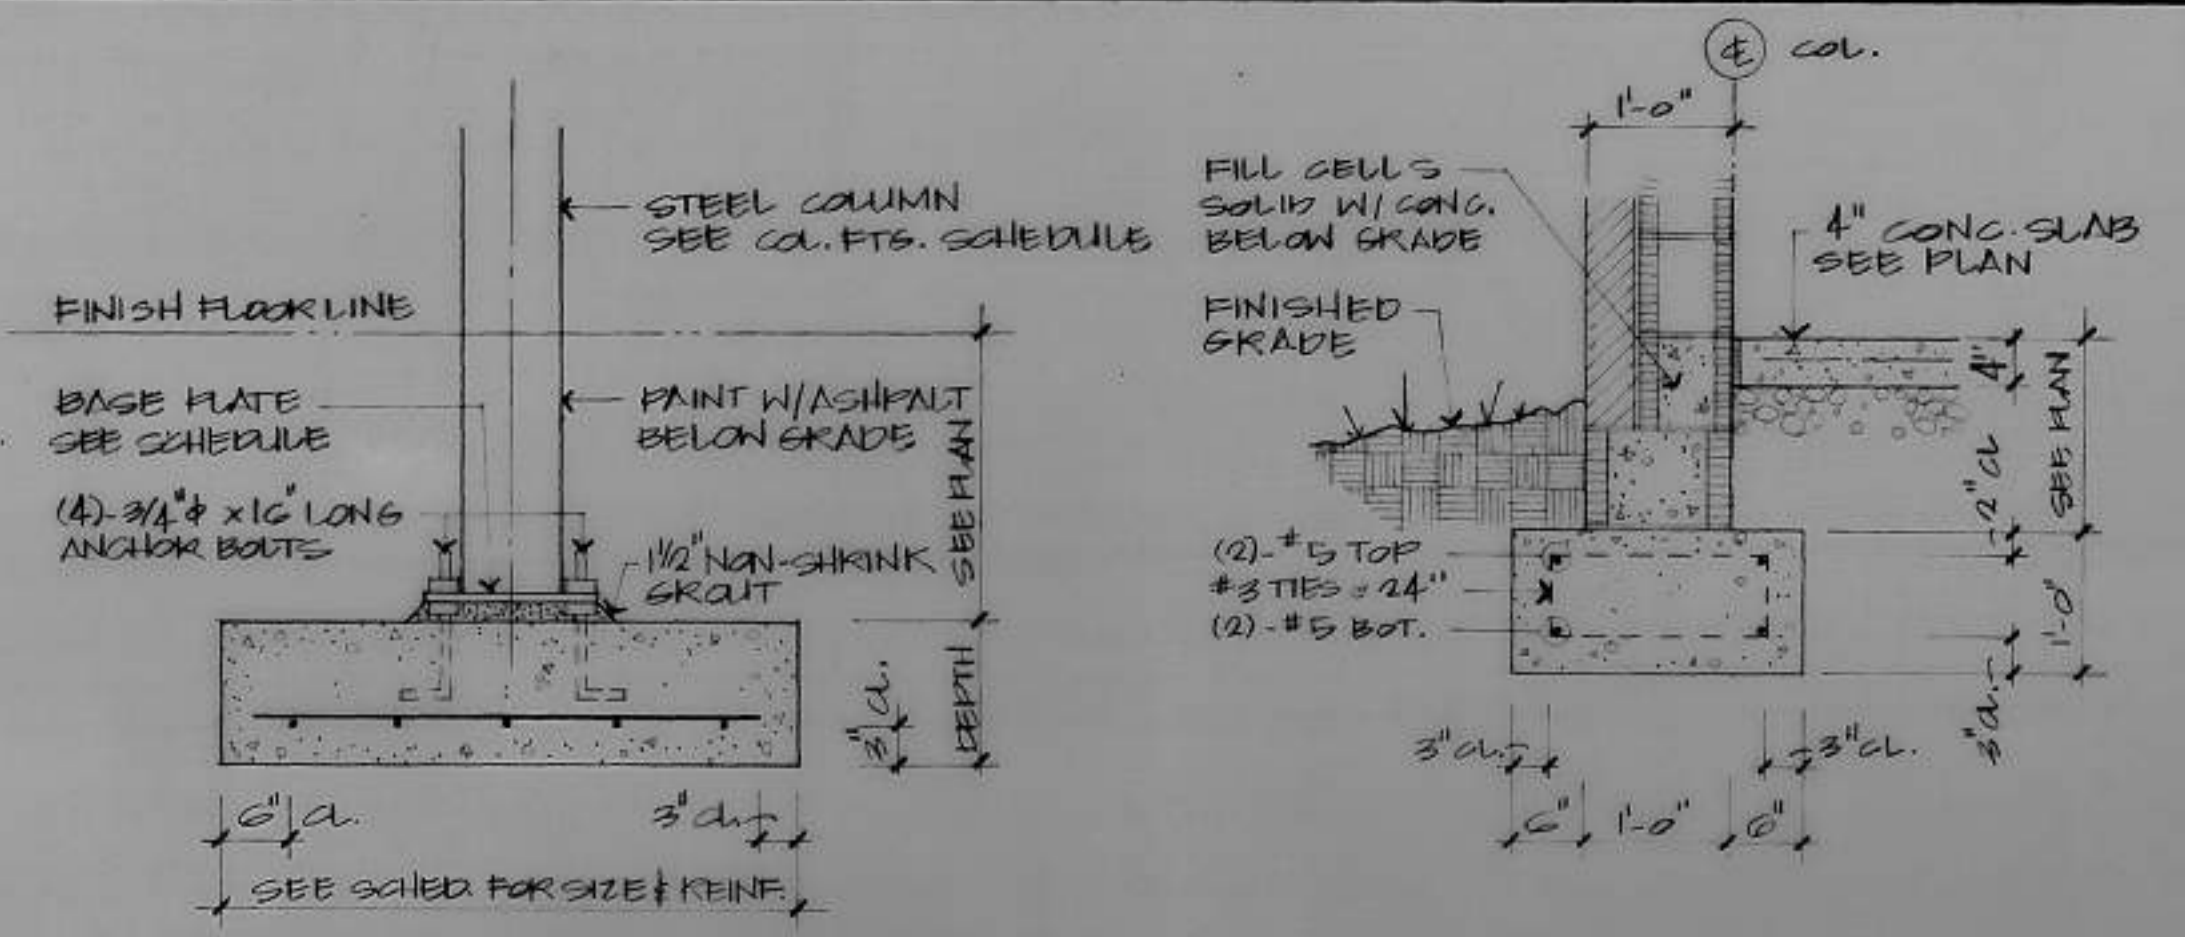


TYPICAL COLUMN FOOTING SI.02
SCALE 3/4" = 1'-0"
TYP. EXTERIOR WALL FTG. SI.03
SCALE 3/4" = 1'-0"

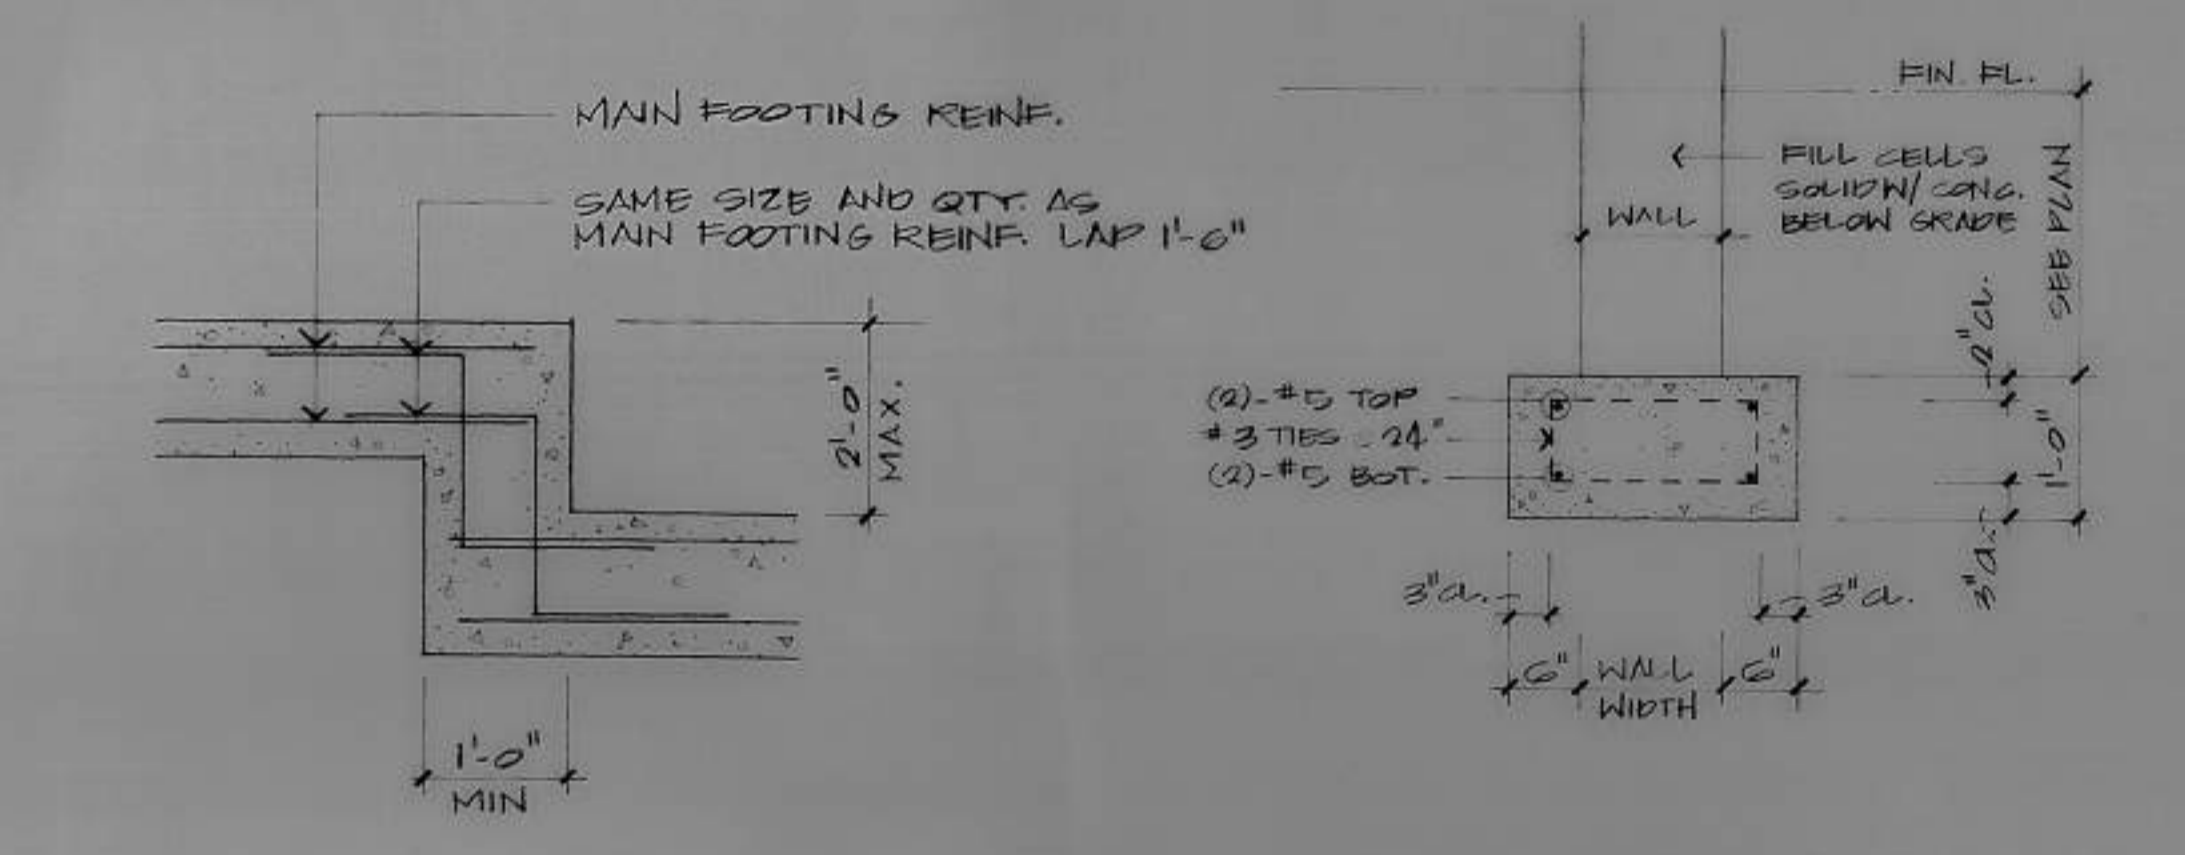


STEPPED FOOTING DETAIL SI.04
SCALE 3/4" = 1'-0"
TYPICAL WALL FOOTING SI.05
SCALE 3/4" = 1'-0"

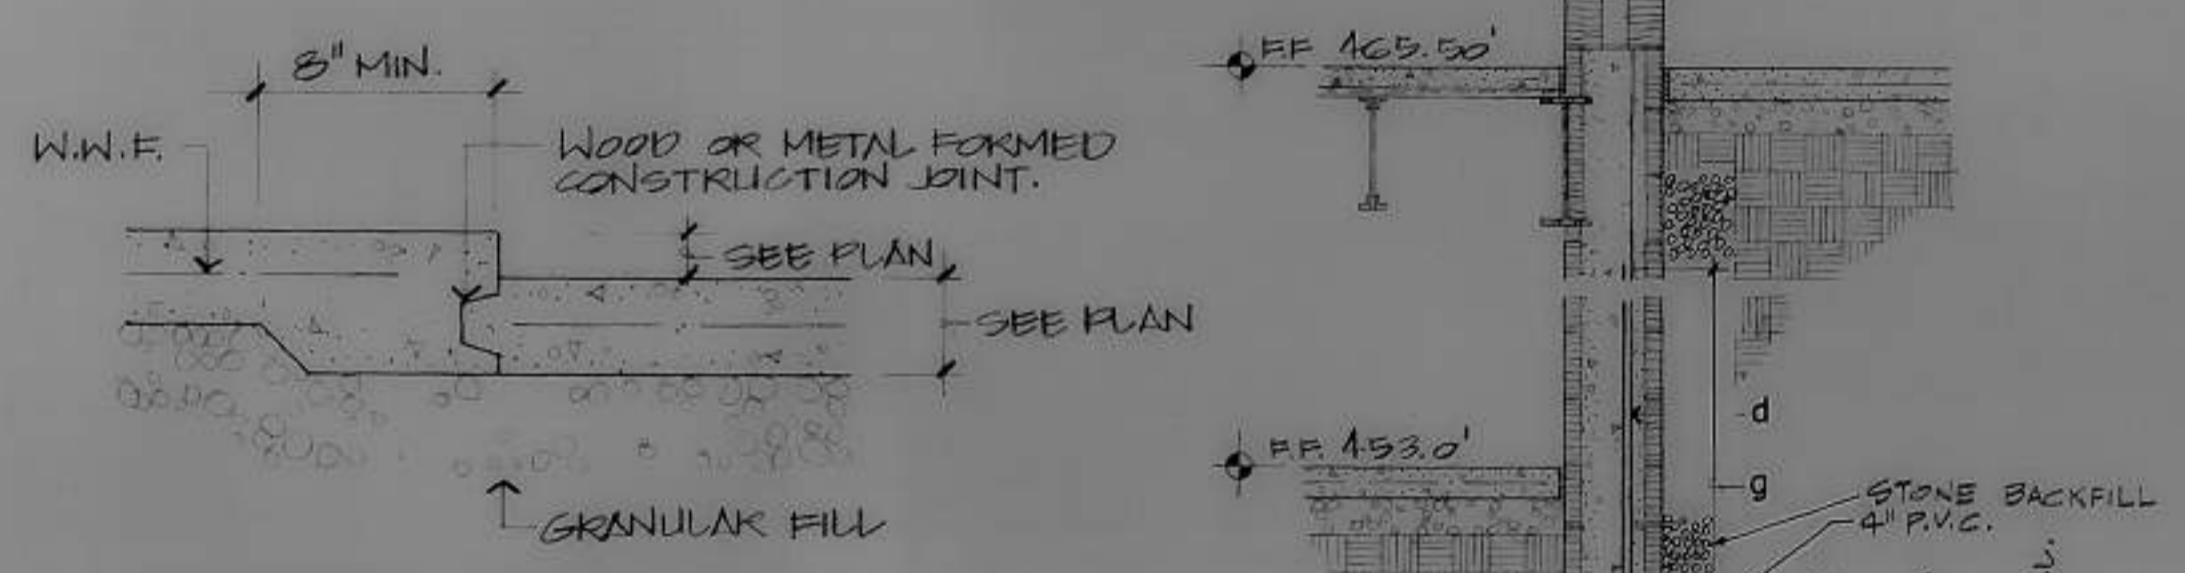


DEPRESSED SLAB DETAIL SI.06
SCALE 1/2" = 1'-0"
RETAINING WALL DETAIL SI.07
SCALE 1/2" = 1'-0"

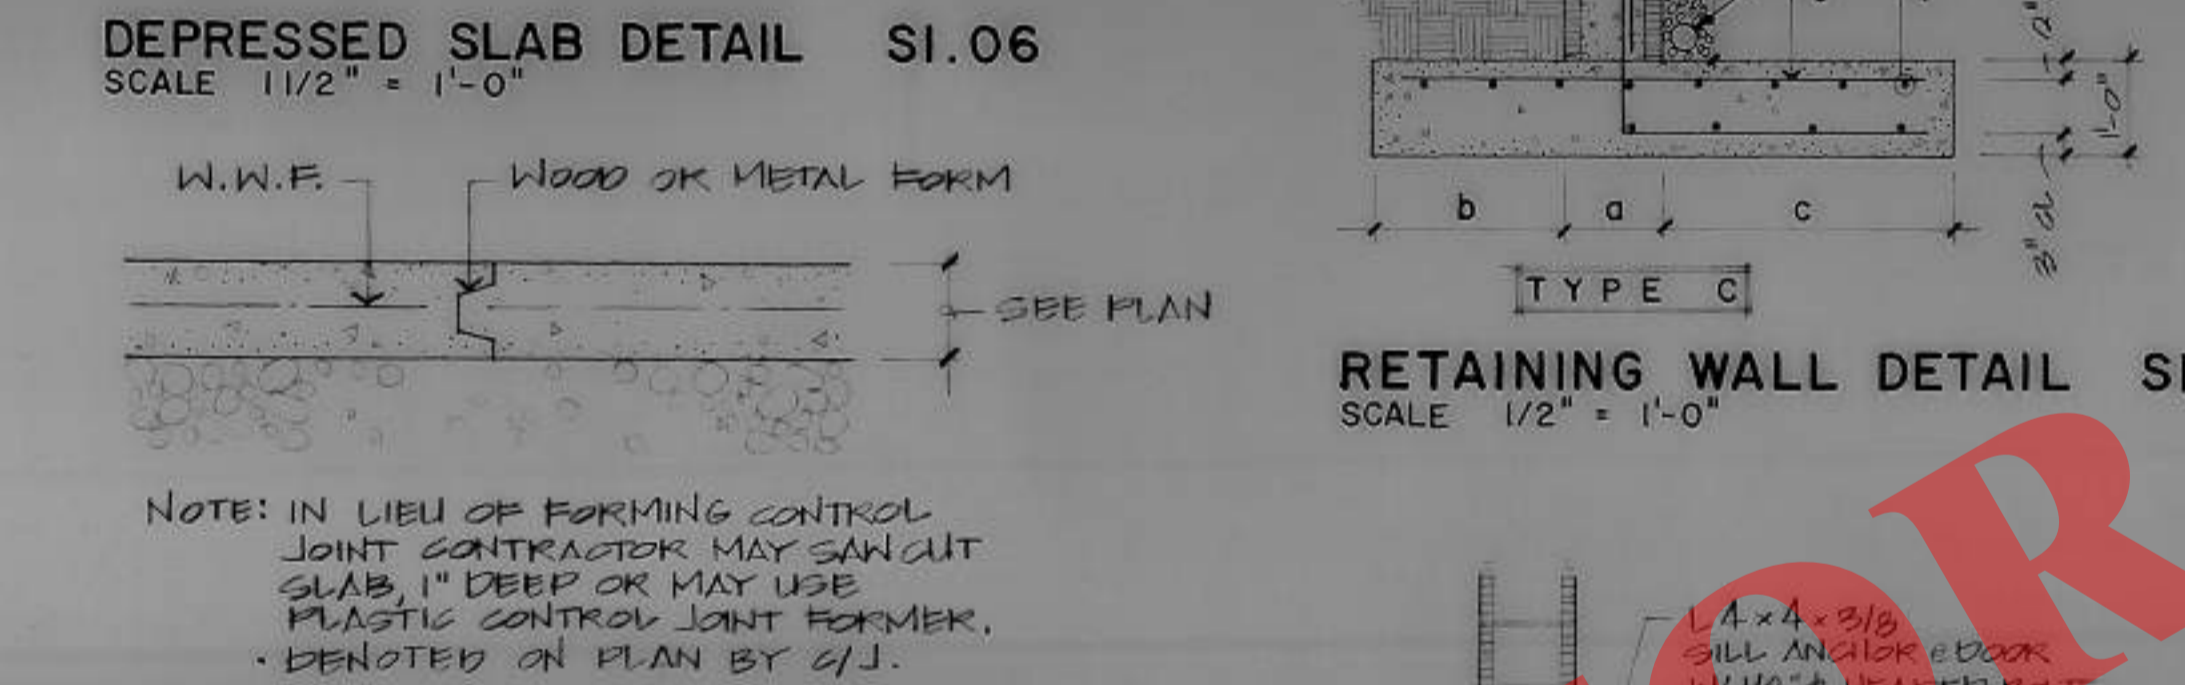


CONTROL JOINT DETAIL SI.08
SCALE 1/2" = 1'-0"

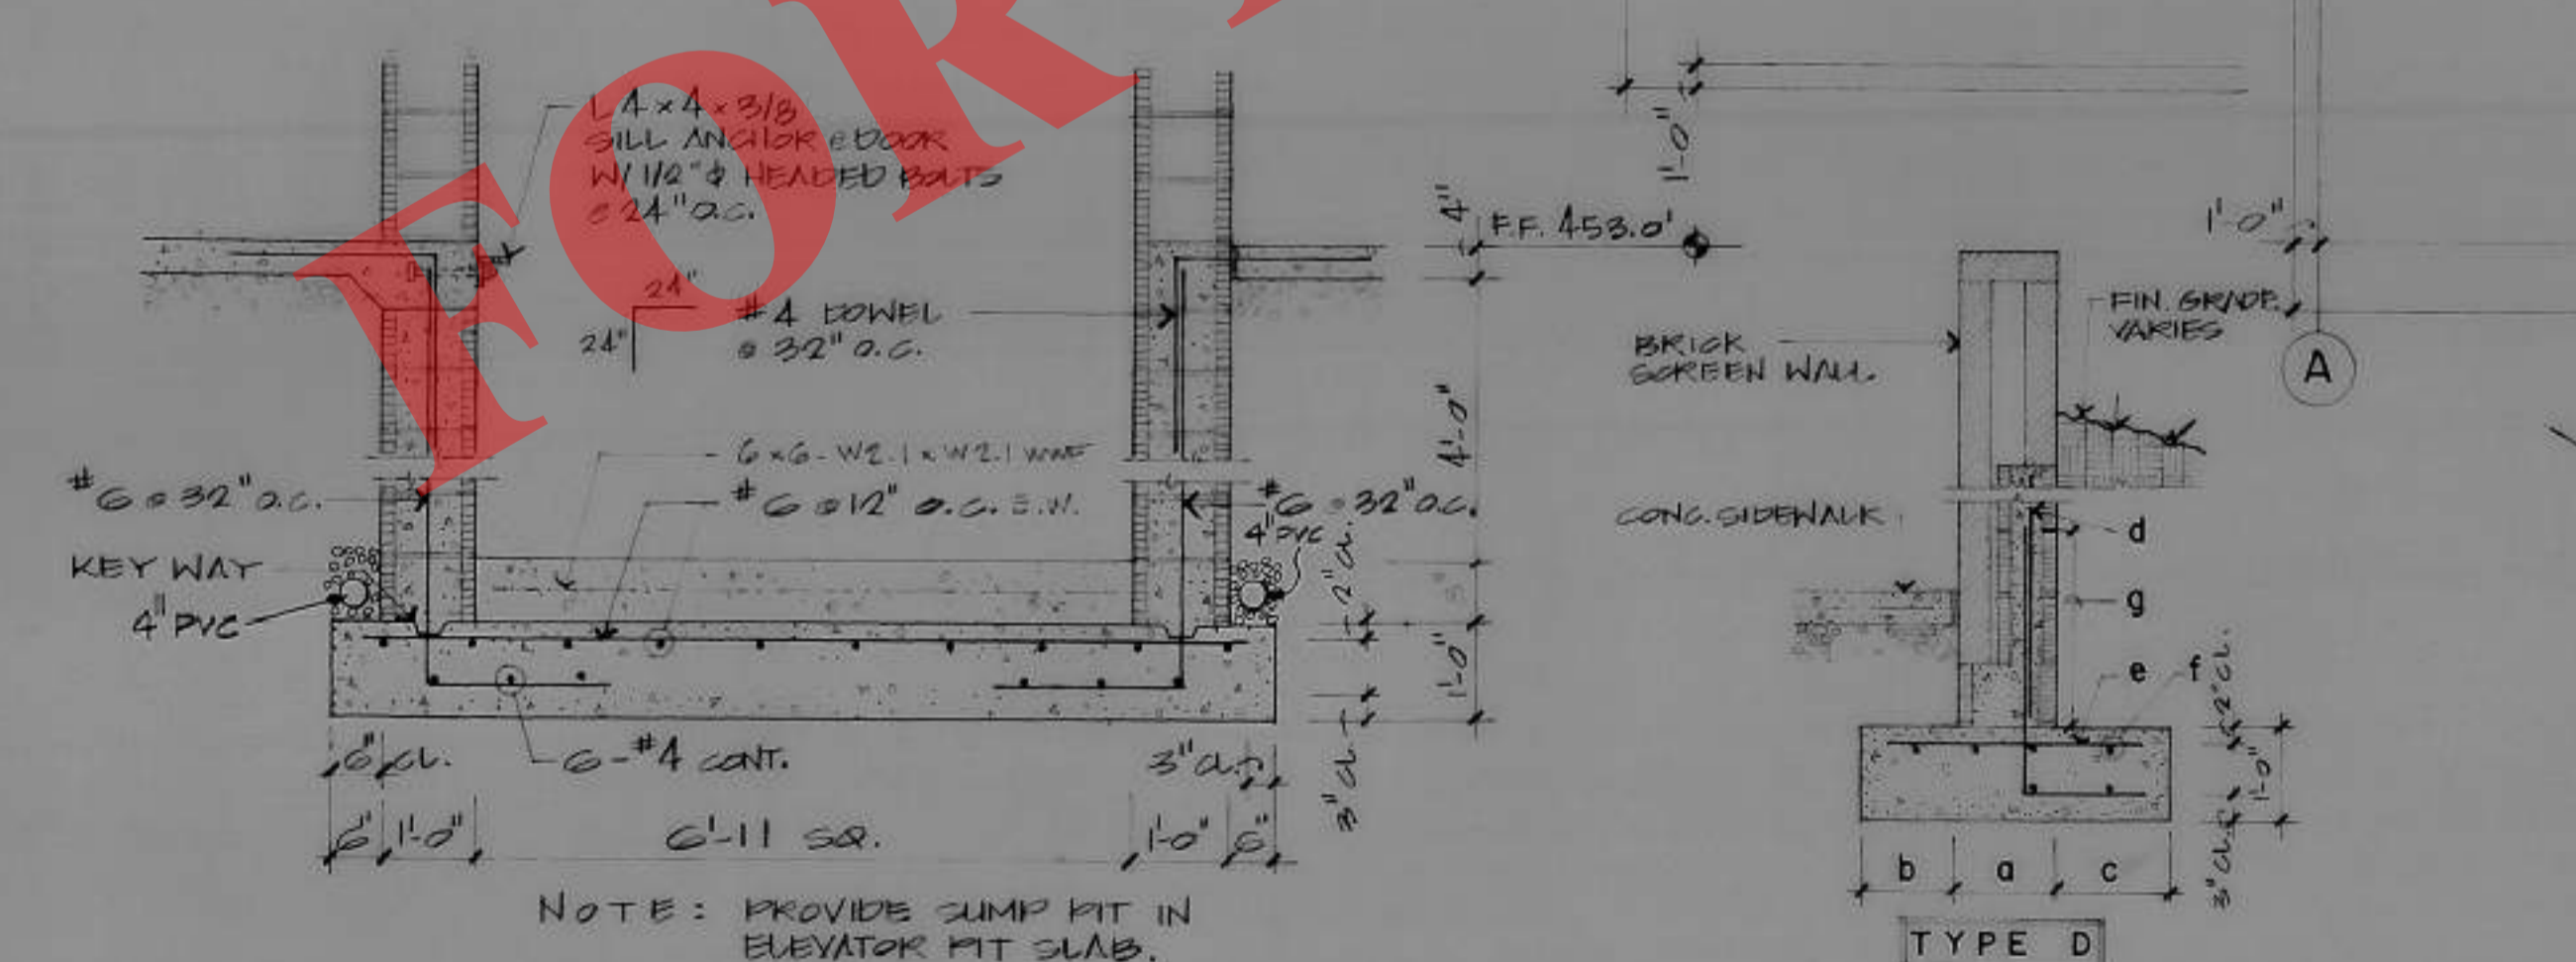

SECTION THRU ELEVATOR PIT SI.11
SCALE 3/4" = 1'-0"
RETAINING WALL DETAIL SI.12
SCALE 1/2" = 1'-0"

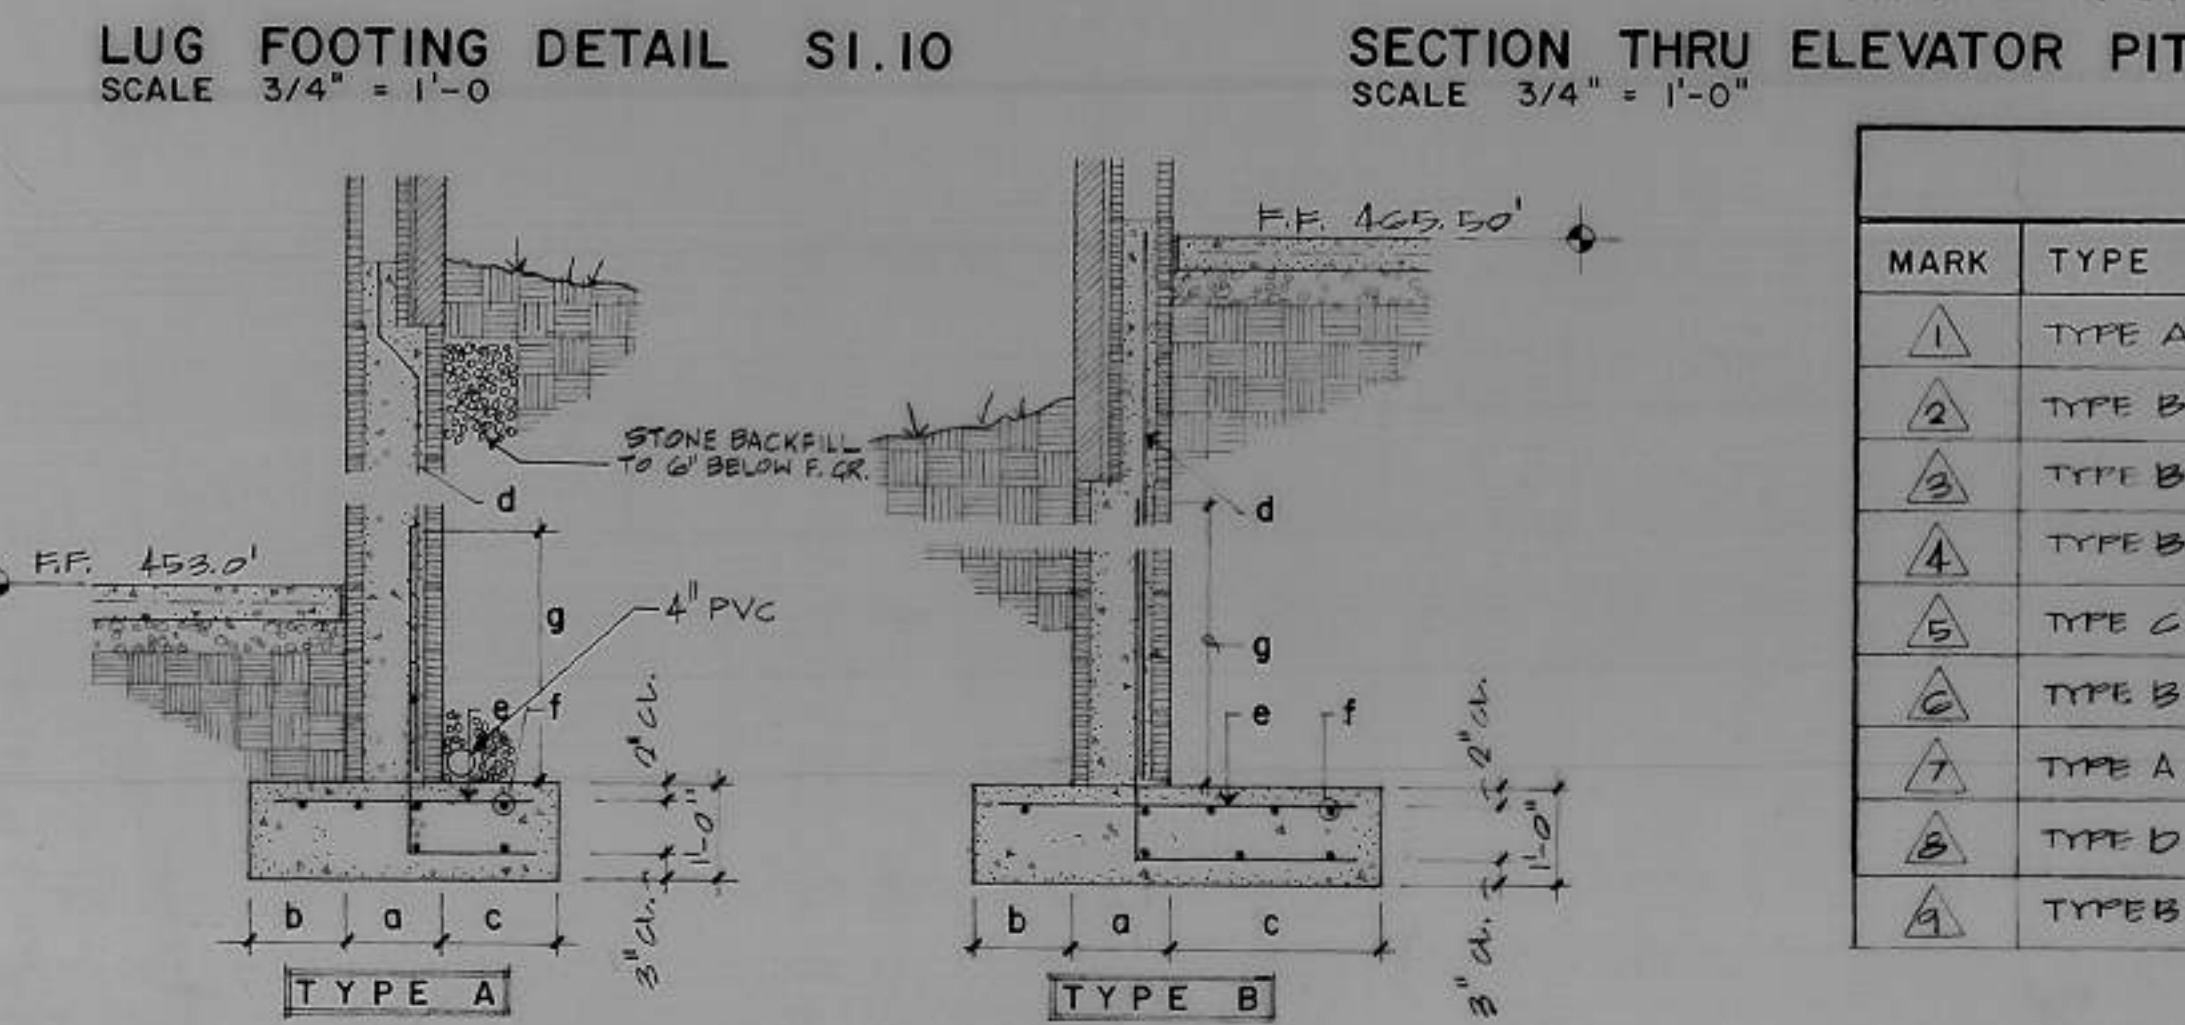

LUG FOOTING DETAIL SI.10
SCALE 3/4" = 1'-0"
RETAINING WALL DETAILS SI.13
SCALE 1/2" = 1'-0"

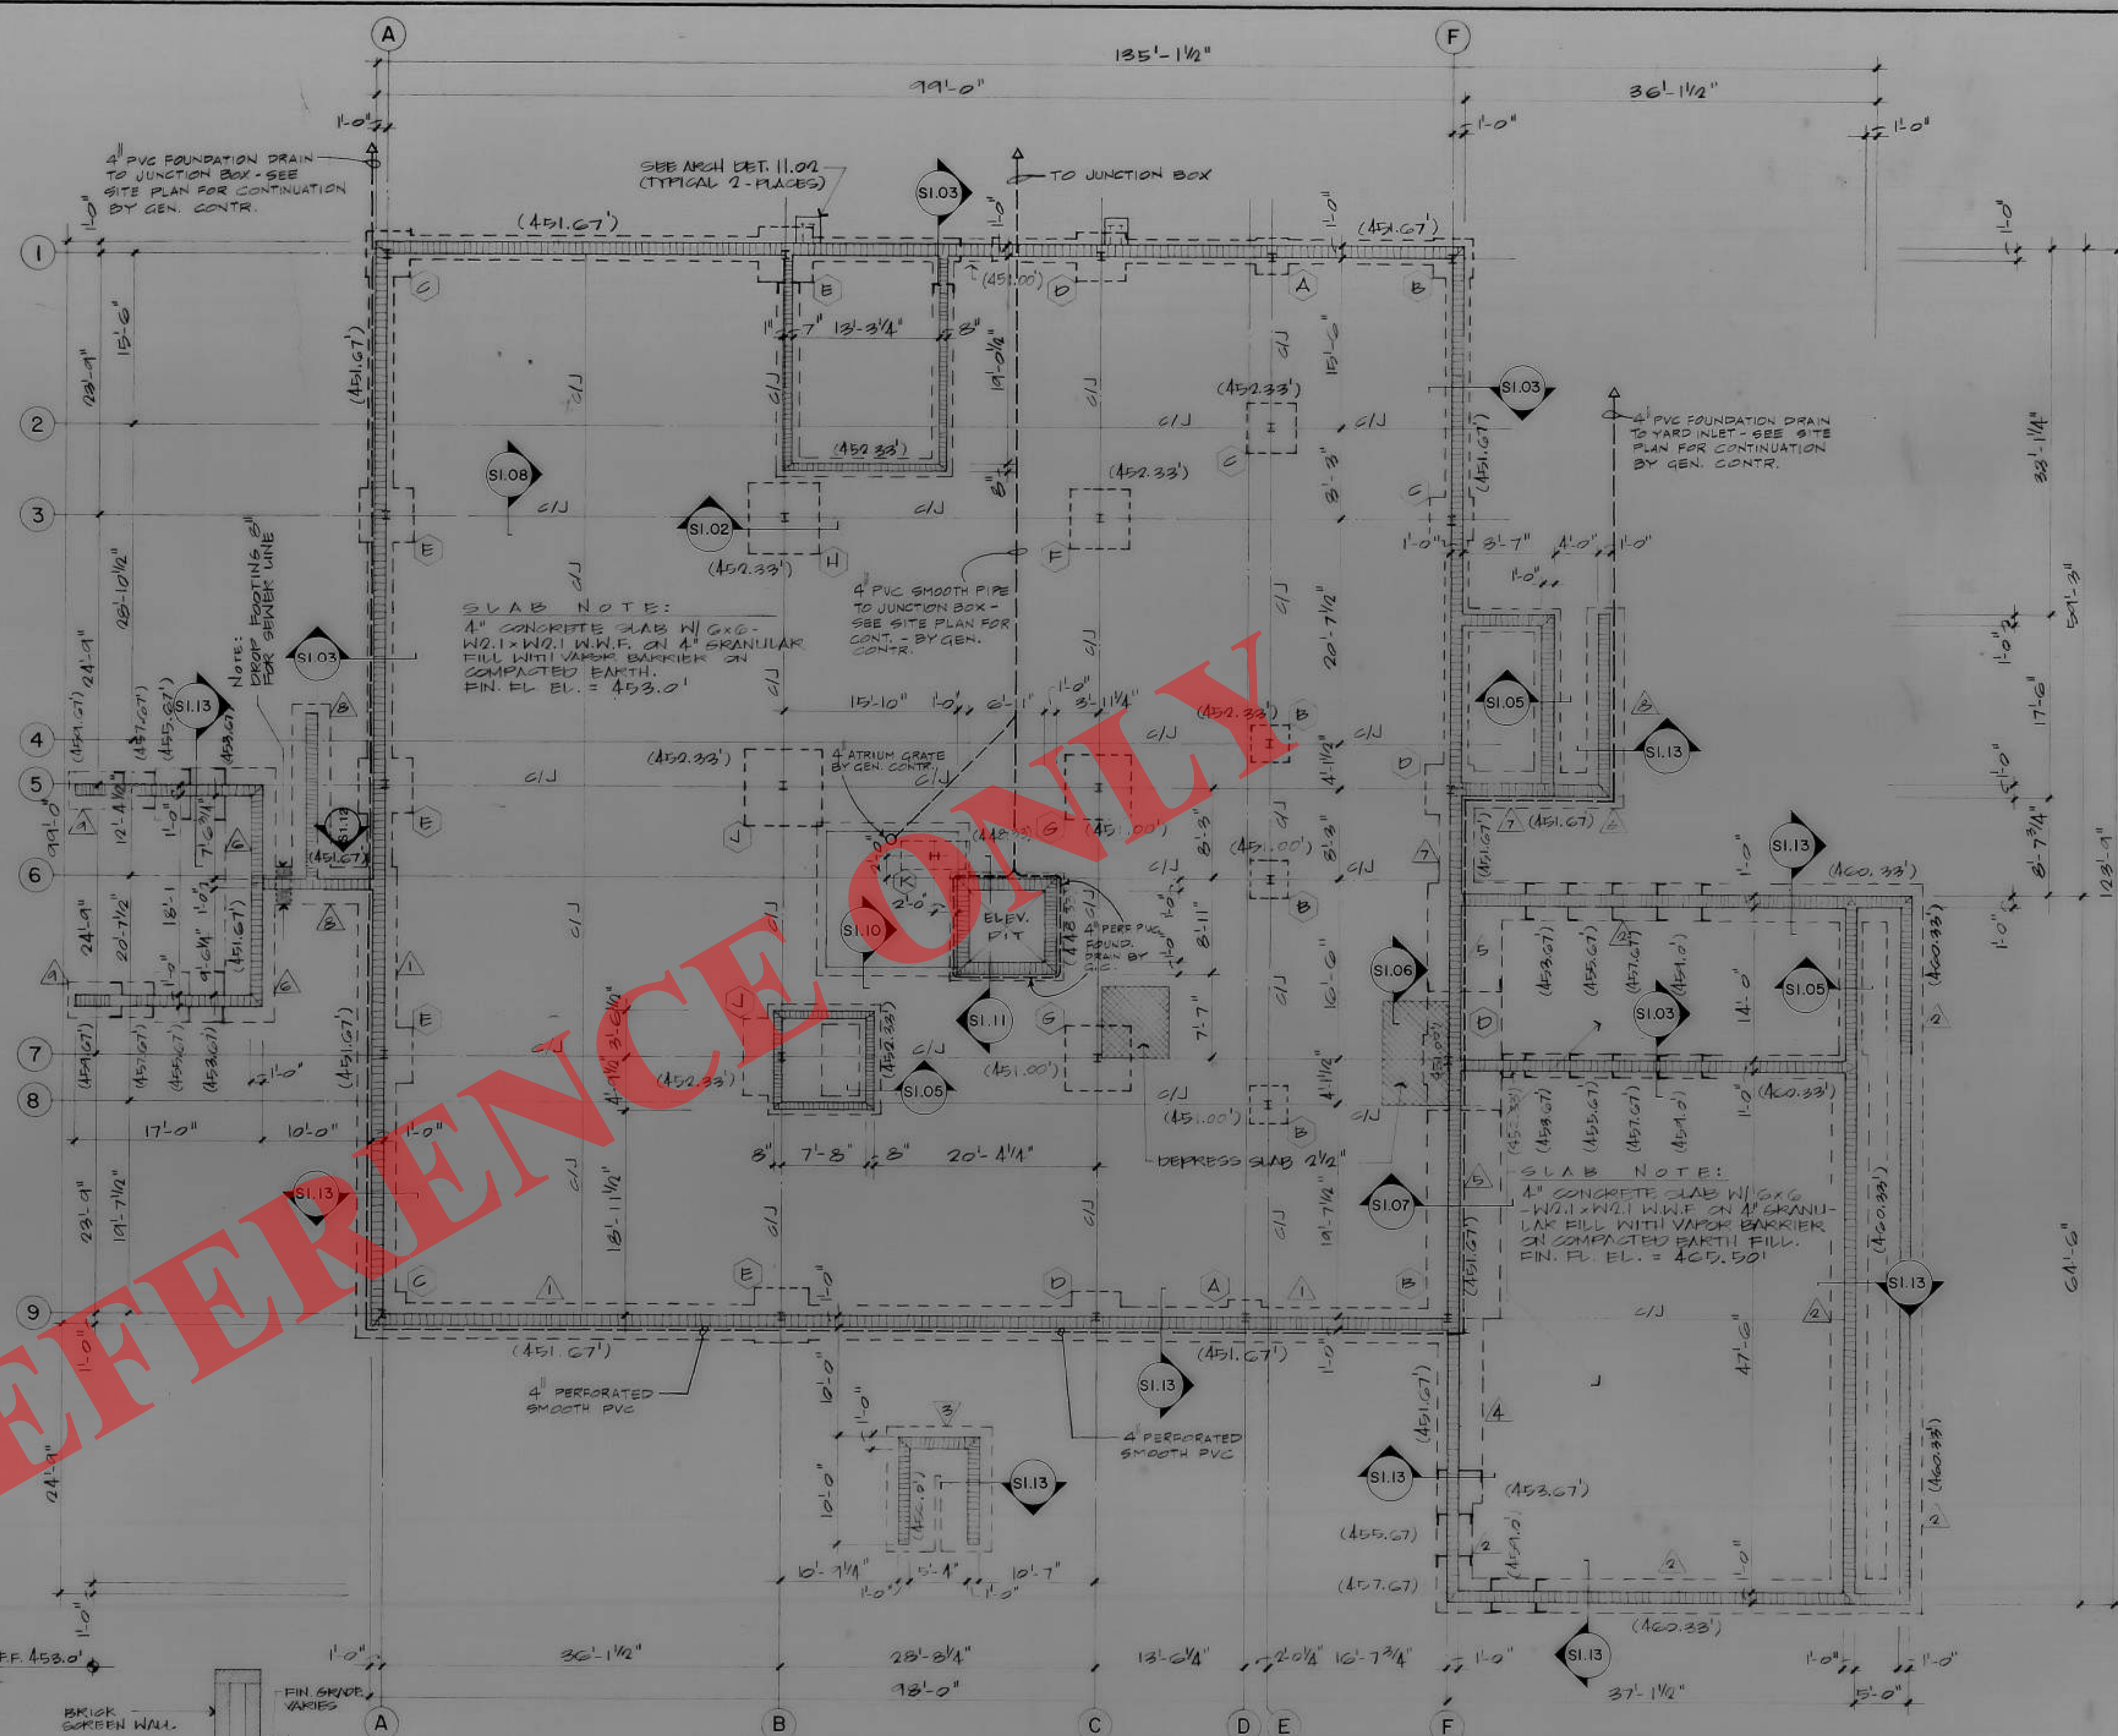


FOUNDATION PLAN SI.01
SCALE 1/8" = 1'-0"

NOTE
1. TOP OF FOOTING ELEVATION IS DENOTED BY () PARENTHESES.


COLUMN FOOTING SCHEDULE						
MARK	COLUMN	FOOTING				
		BASE R.	DEPTH	SIZE	REINF.	REMARKS
A	WB X 31	14 x 14 x 1/2"	12"	30" x 30"	(4) #5 E/W	
B	WB X 31	14 x 14 x 3/4"	12"	30" x 30"	(4) #5 E/W	
C	WB X 31	14 x 14 x 3/4"	12"	4" x 4"	(4) #5 E/W	
D	WB X 31	14 x 14 x 3/4"	12"	15" x 4"	(5) #5 E/W	
E	WB X 31	14 x 14 x 1"	14"	5" x 5"	(5) #5 E/W	
F	WB X 35	14 x 14 x 1"	15"	5" x 5"	(6) #5 E/W	
G	WB X 35	14 x 14 x 1"	16"	6" x 6"	(6) #5 E/W	
H	WB X 40	14 x 14 x 1 1/4"	18"	6" x 6"	(6) #5 E/W	
I	WB X 40	14 x 14 x 1 1/4"	19"	7" x 7"	(8) #5 E/W	
J	WB X 31	14 x 14 x 1/2"	12"	2 1/2" x 6"	(4) #5 E/W (6) #5 S/W	

RETAINING WALL SCHEDULE									
MARK	TYPE	a	b	c	d	e	f	g	REMARKS
1	TYPE A	12" BLOCK	12"	14"	6" @ 32"	4" @ 16"	(6) #4	33"	
2	TYPE B	4" BRICK 8" BLOCK	12"	14"	6" @ 32"	4" @ 16"	(6) #4	33"	
3	TYPE B	4" BRICK 8" BLOCK	16"	20"	6" @ 32"	4" @ 12"	(8) #4	33"	
4	TYPE B	4" BRICK 8" BLOCK	12"	20"	7" @ 16"	4" @ 12"	(8) #4	45"	
5	TYPE C	12" BLOCK	24"	16"	7" @ 16"	4" @ 8"	(12) #4	45"	
6	TYPE B	12" BLOCK	16"	20"	6" @ 32"	4" @ 12"	(8) #4	33"	
7	TYPE A	4" BRICK 8" BLOCK	16"	20"	6" @ 32"	4" @ 12"	(8) #4	33"	
8	TYPE D	4" BRICK 8" BLOCK	12"	14"	6" @ 32"	4" @ 16"	(6) #4	33"	
9	TYPE B	12" BLOCK	12"	14"	6" @ 32"	4" @ 16"	(6) #4	33"	

- GENERAL NOTES:**
- DESIGN LIVE LOADS
 - A. ROOF: 20 PSF
 - B. FLOOR: 50 PSF
 - C. WIND: 80 MPH
 - D. SOIL BEARING PRESSURE: 4000 PSF
 - MATERIALS
 - A. CONCRETE (FOOTINGS, WALLS, FLOOR SLAB): 3000 PSI RES. WT.
 - B. CONCRETE (COMPOSITE FLOOR SLAB): 3000 PSI LT. WT.
 - C. REINFORCING STEEL: ASTM A-615 GR. 60
 - D. WELDED WIRE FABRIC: ASTM A-185
 - E. STRUCTURAL STEEL: ASTM A-36
 - F. STEEL JOISTS: H-SERIES
 - G. BOLTS: ASTM A-325
 - WORKMANSHIP
 - A. ALL FOOTINGS SHALL BEAR ON APPROVED GRADE OR FILL.
 - B. CONCRETE SHALL CONFORM TO ACI-318 AND ACI-301.
 - C. ALL DETAILING, FABRICATING AND ERECTION SHALL CONFORM TO THE FOLLOWING SPECIFICATIONS:
 - "AISC" SPECIFICATION FOR THE DESIGN, FABRICATING AND ERECTION OF STRUCTURAL STEEL FOR BUILDINGS.
 - "AWS" CODE FOR WELDING IN BUILDING CONSTRUCTION.
 - "SDI" CODE OF RECOMMENDED PRACTICE.
 - D. SHORE ALL COMPOSITE BEAMS AND GIRDERS AT 12' CENTERS.
 - E. THE CONTRACTOR SHALL PROVIDE ADEQUATE AND TEMPORARY BRACING, SHORING AND SUTING OF THE FRAMING AGAINST WIND, CONSTRUCTION LOADS AND OTHER TEMPORARY FORCES.

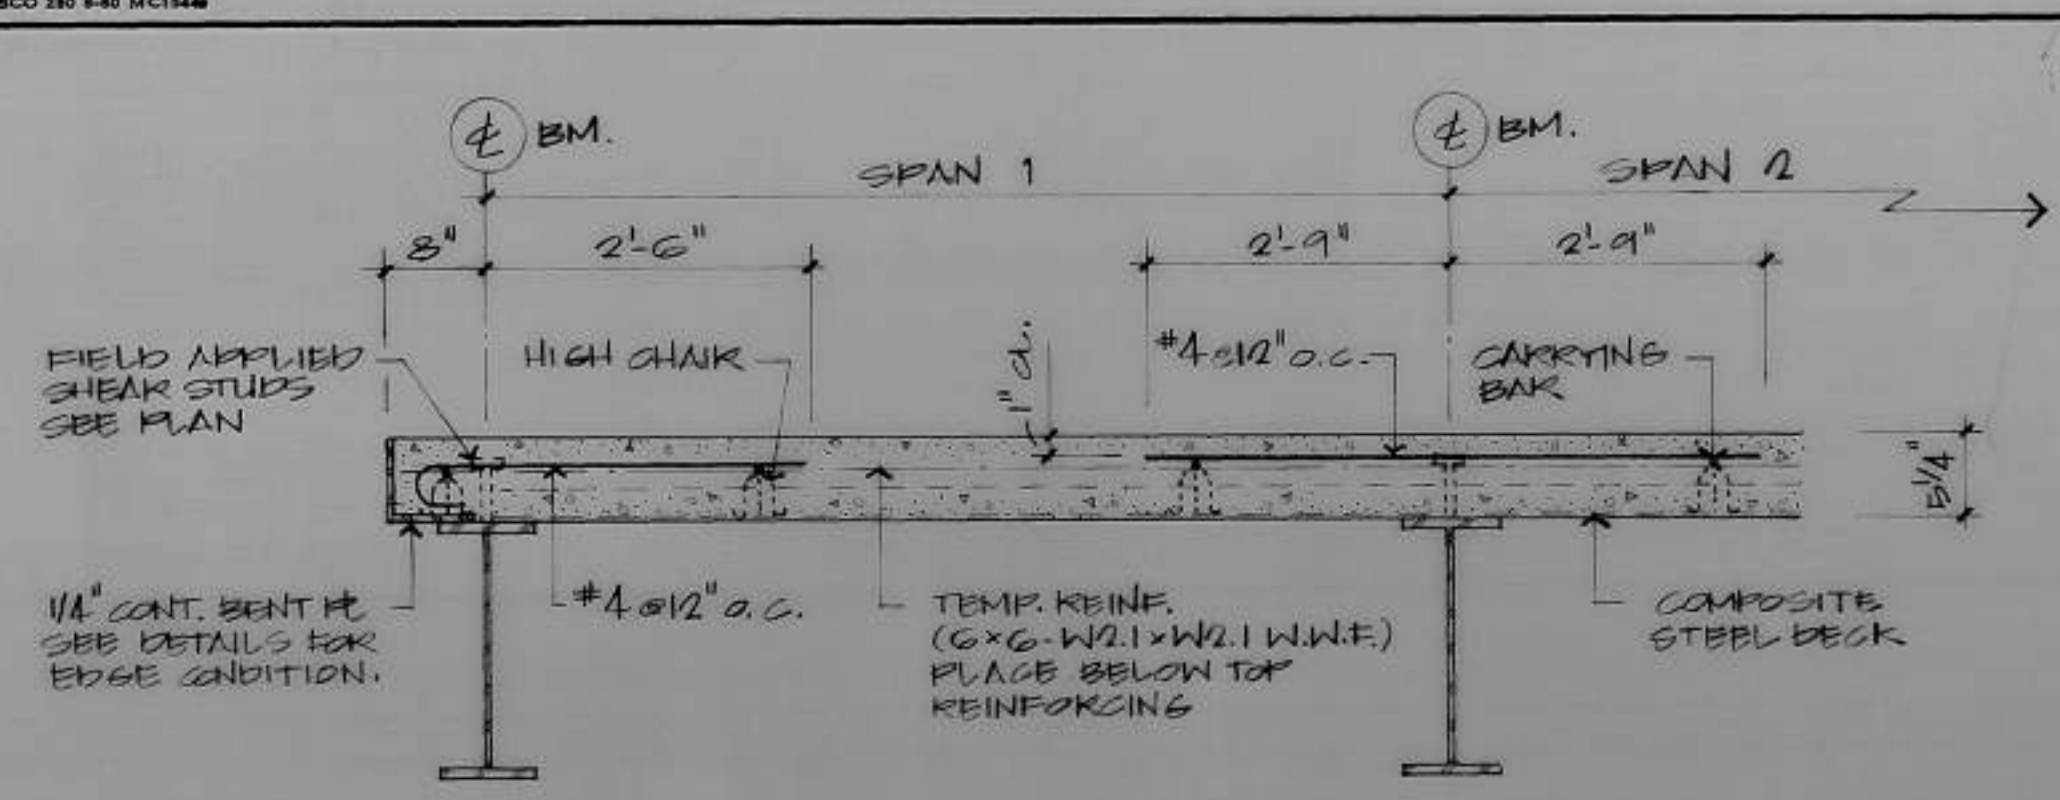


COMPOSITE SLAB BENDING DIAGRAM S2.02
NO SCALE

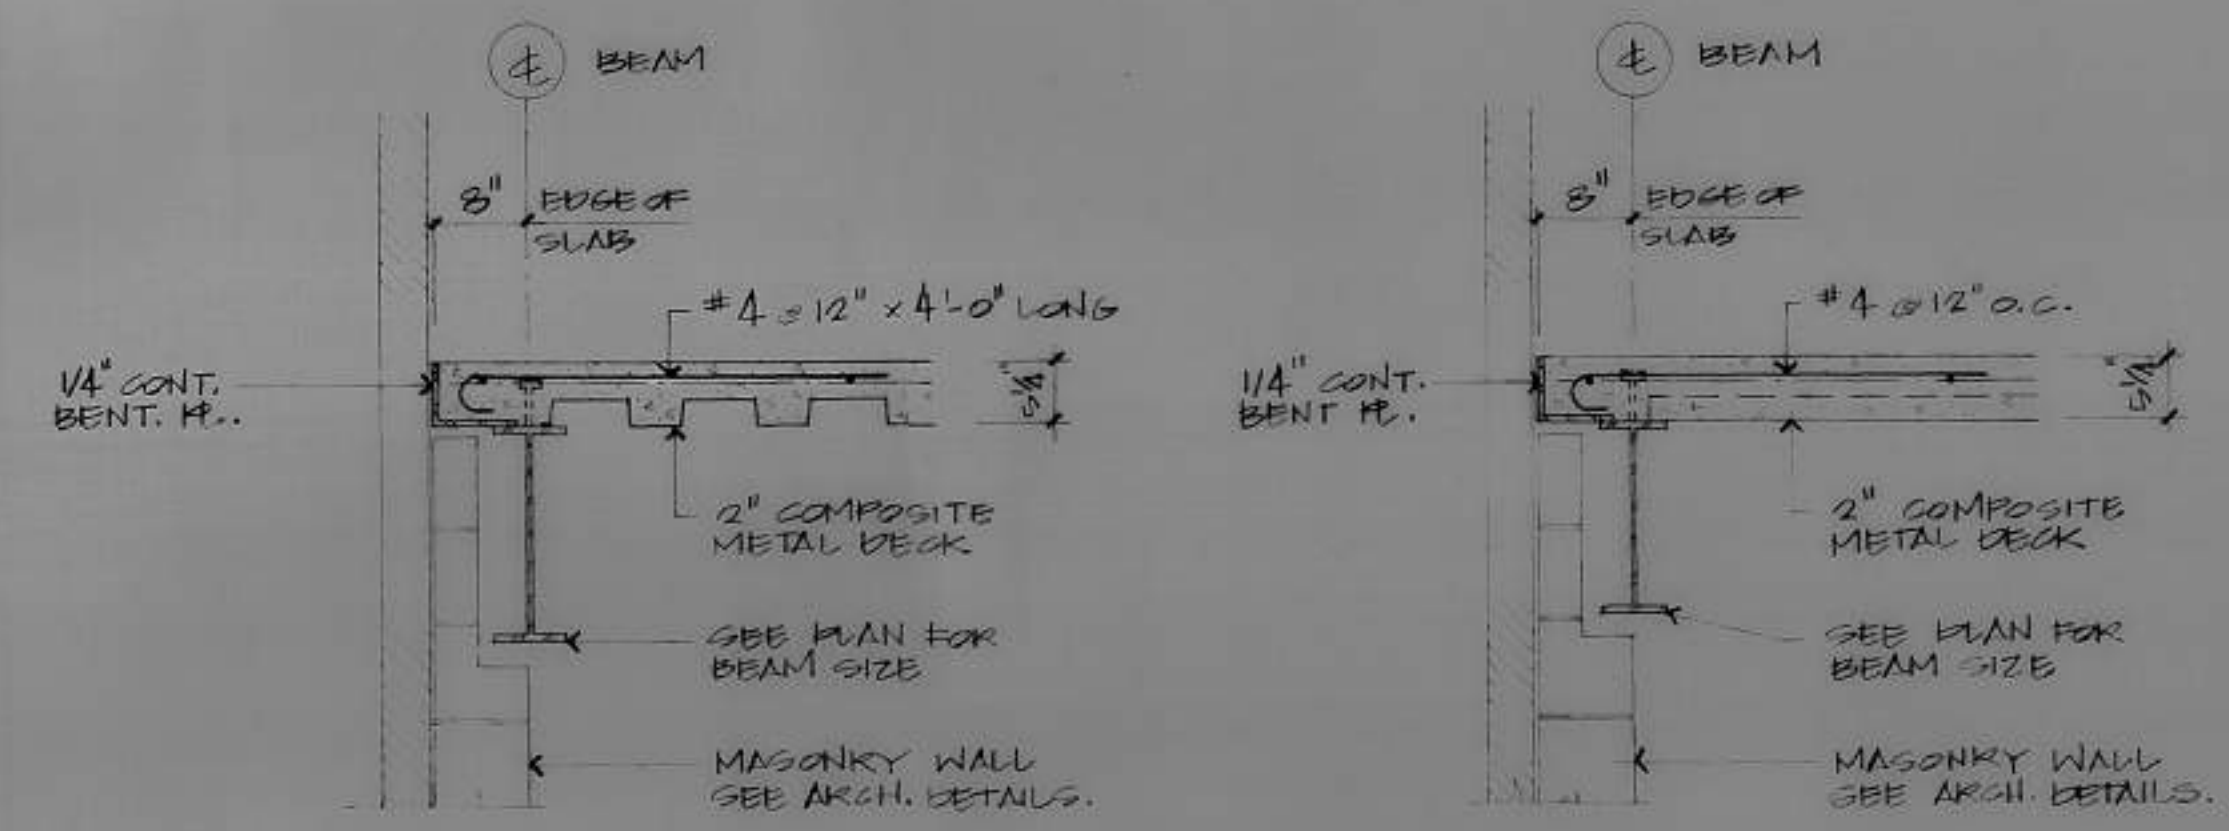


SECTION S2.03
SCALE 3/4" = 1'-0"


SECTION S2.04
SCALE 3/4" = 1'-0"

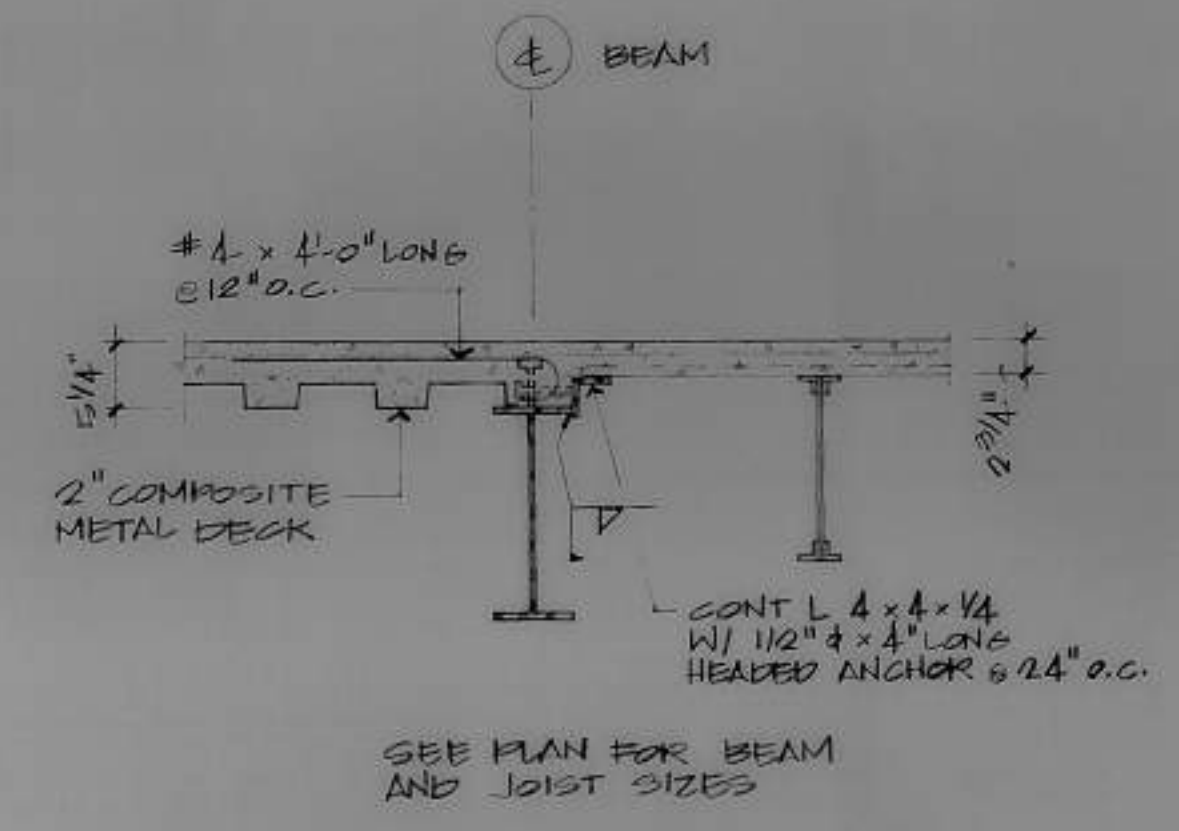


SECTION S2.05
SCALE 3/4" = 1'-0"

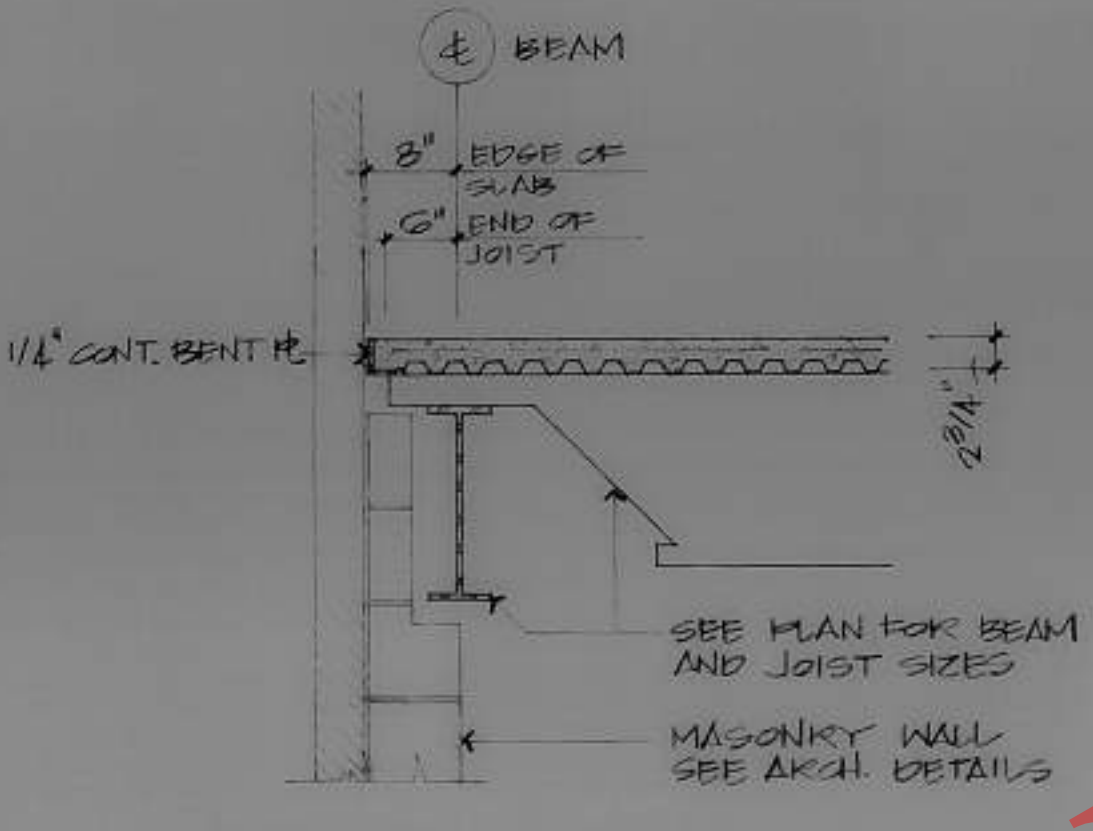


SECTION S2.06
SCALE 3/4" = 1'-0"

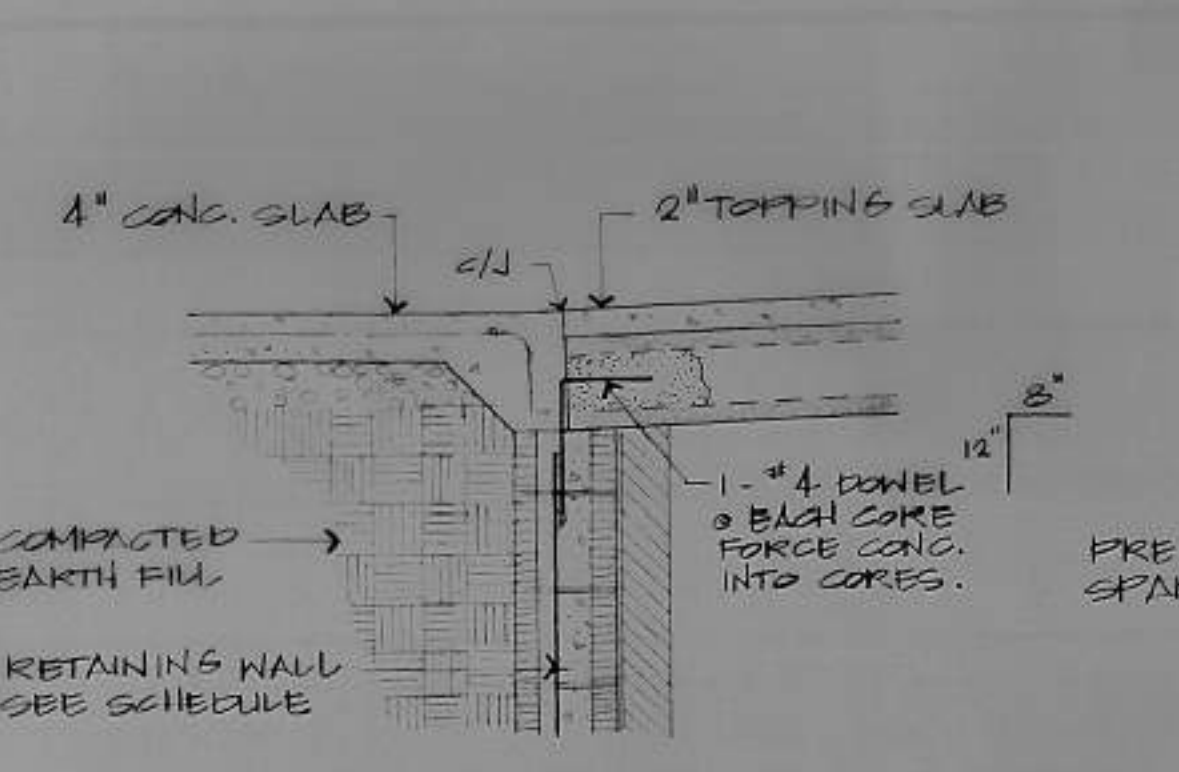


SECTION AT BRIDGE S2.07
SCALE 3/4" = 1'-0"

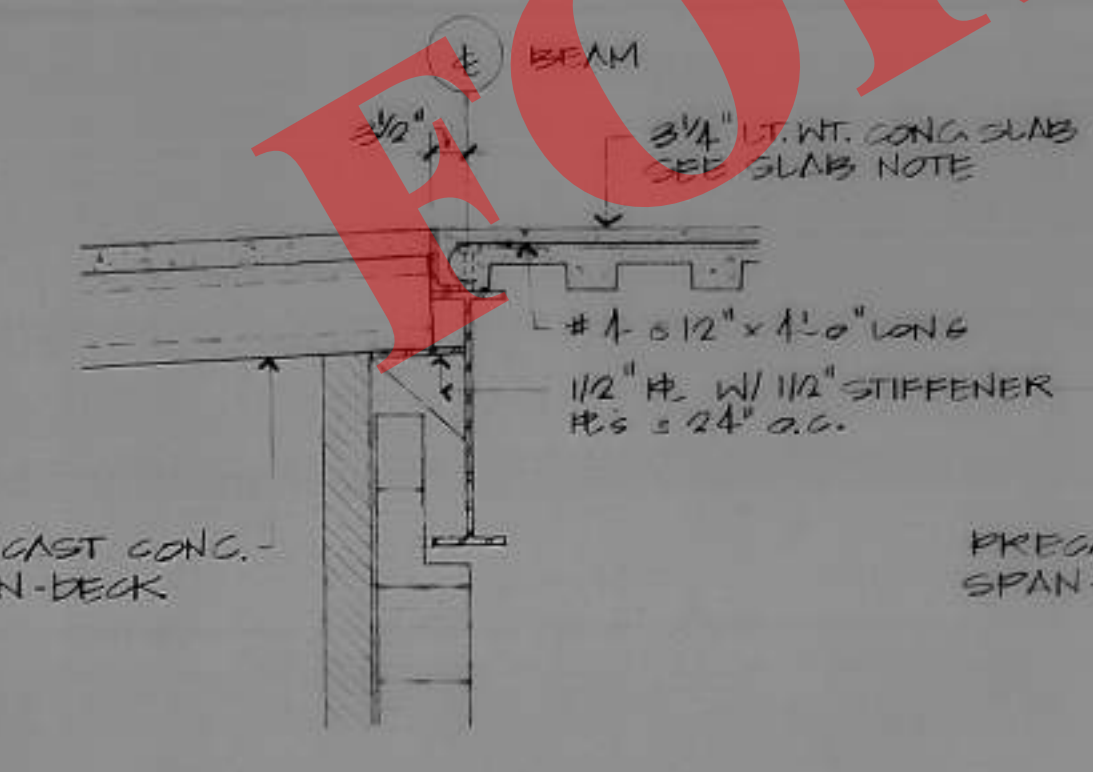


SECTION AT BRIDGE S2.08
SCALE 3/4" = 1'-0"

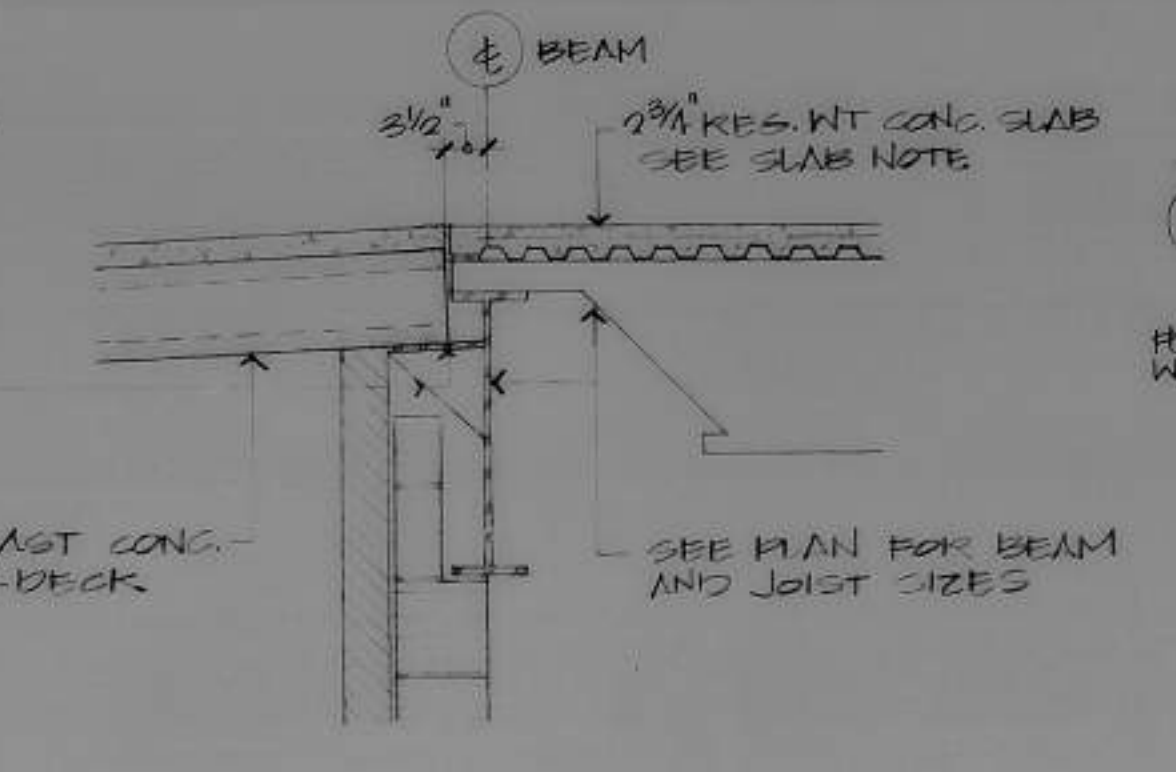


SECTION AT BRIDGE S2.09
SCALE 3/4" = 1'-0"

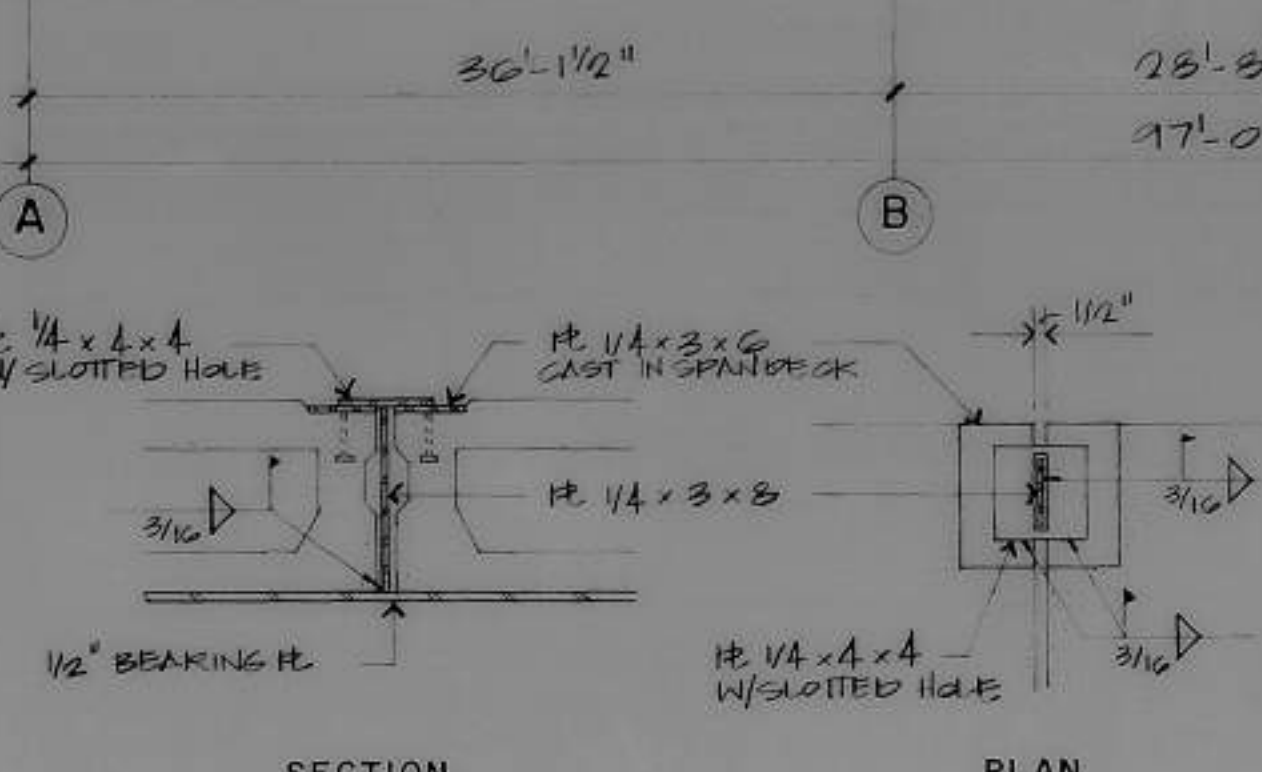


PRECAST SPAN-DECK CONNECTION S2.16
NO SCALE

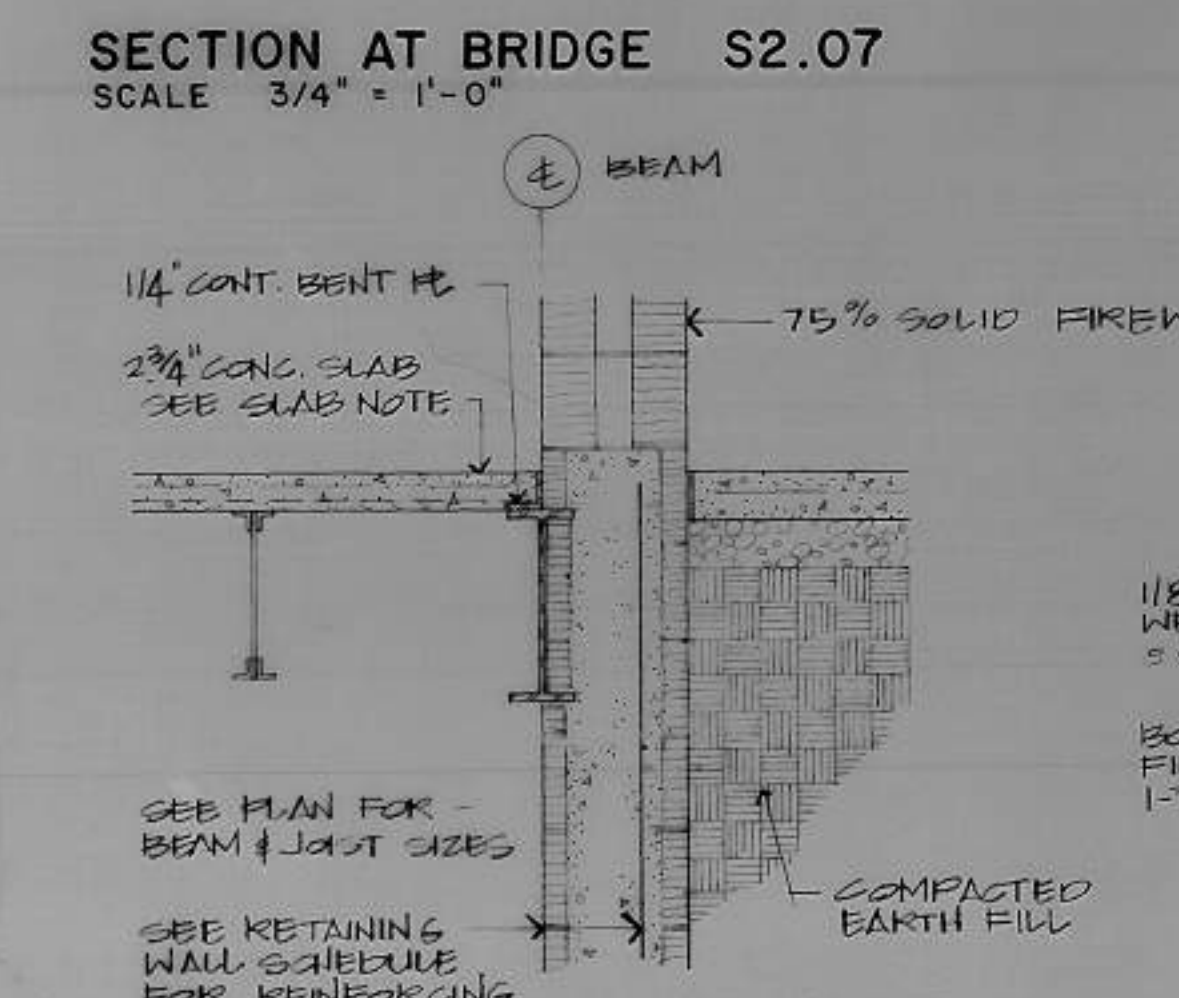


SECTION S2.10
SCALE 3/4" = 1'-0"

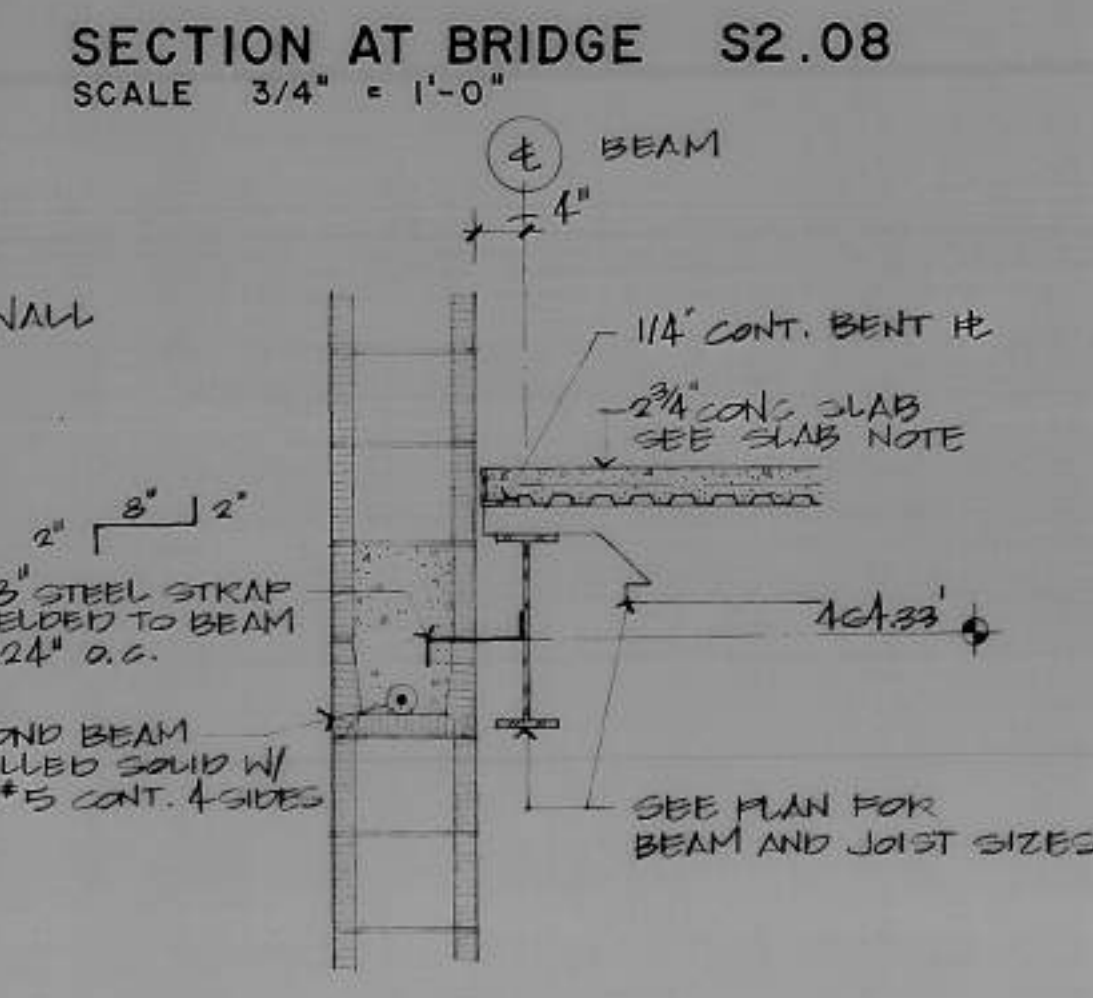


SECTION S2.11
SCALE 3/4" = 1'-0"

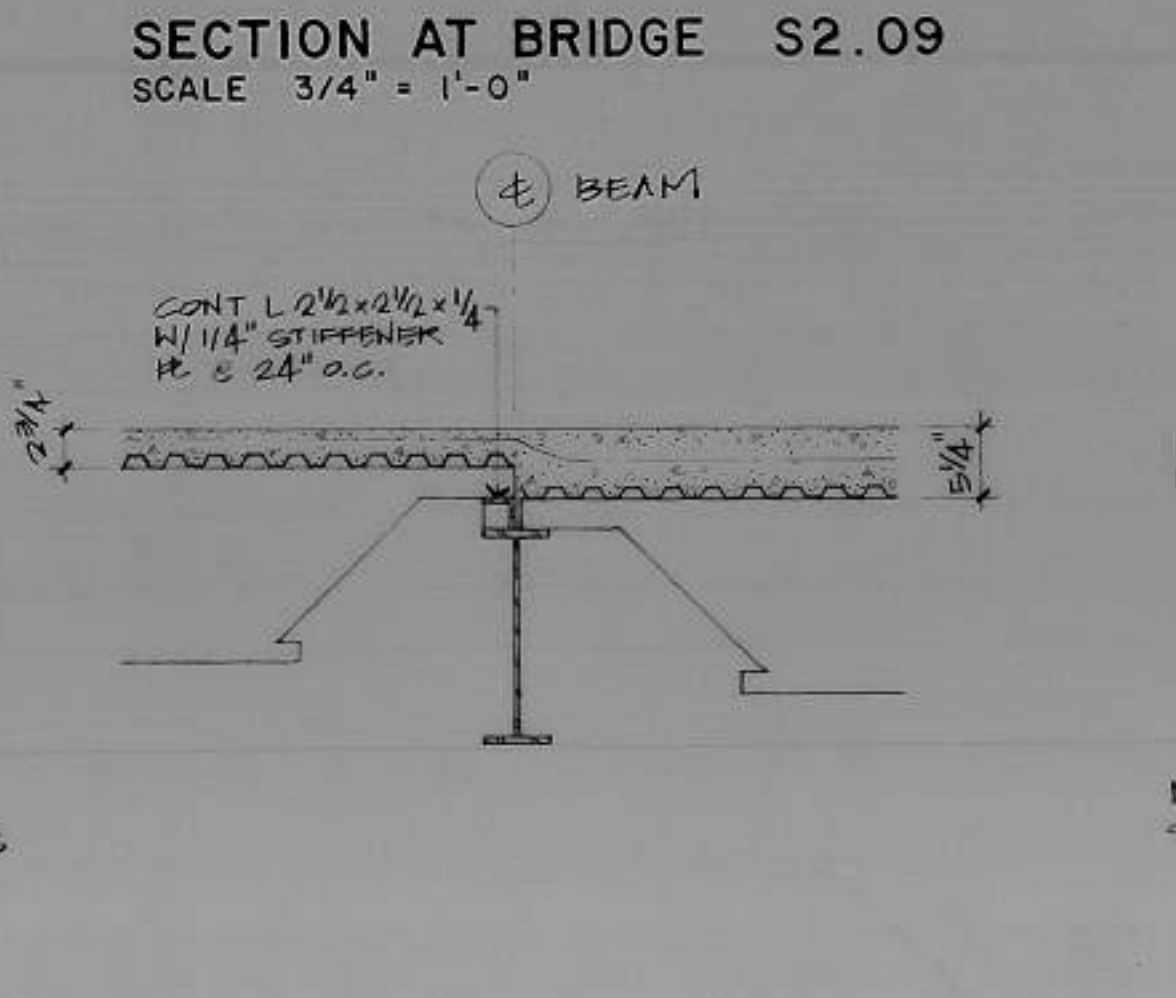


SECTION S2.12
SCALE 3/4" = 1'-0"

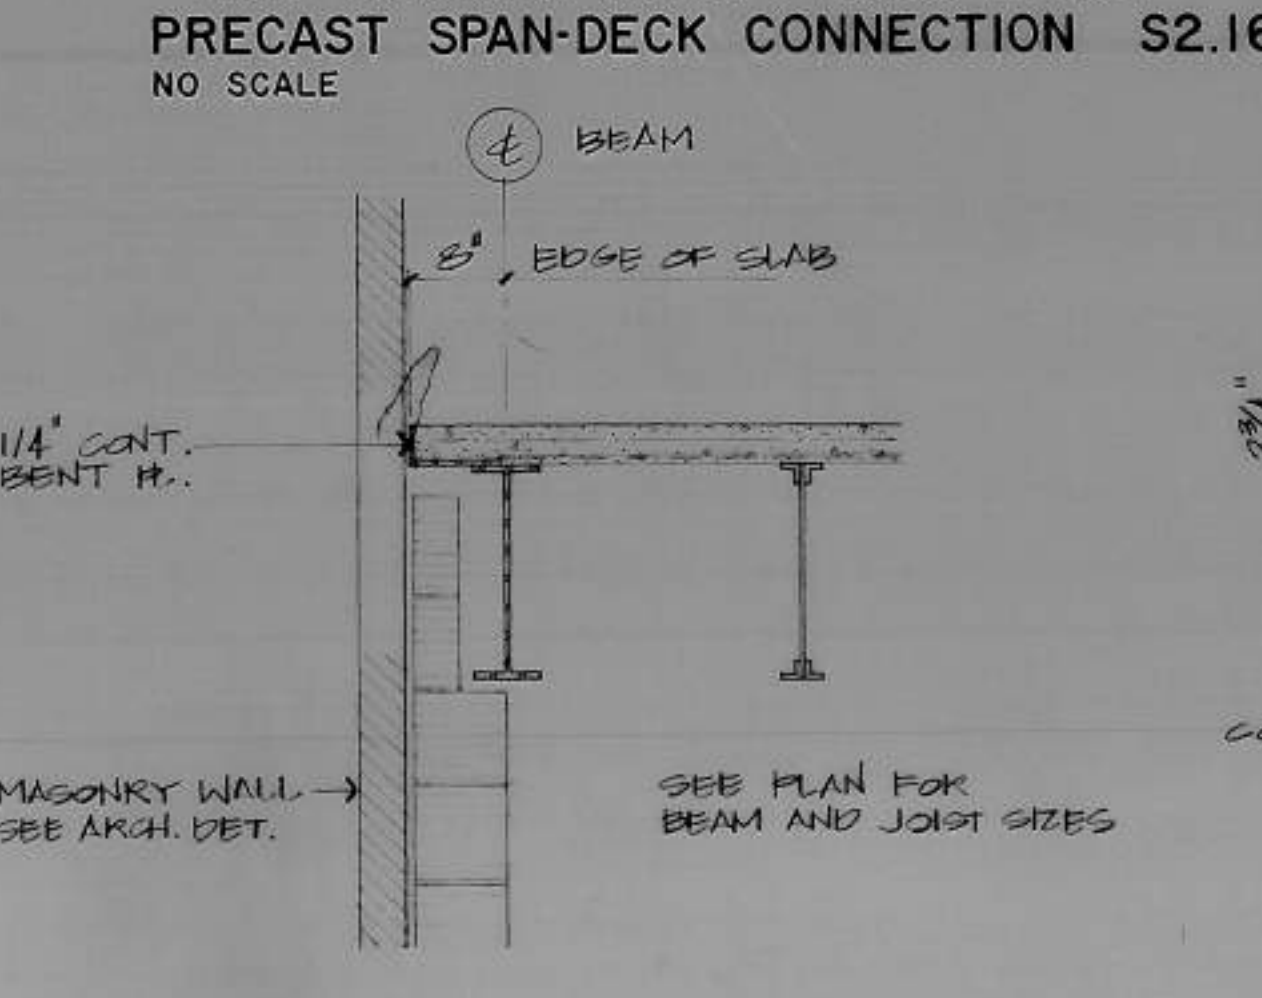


SECTION S2.13
SCALE 3/4" = 1'-0"

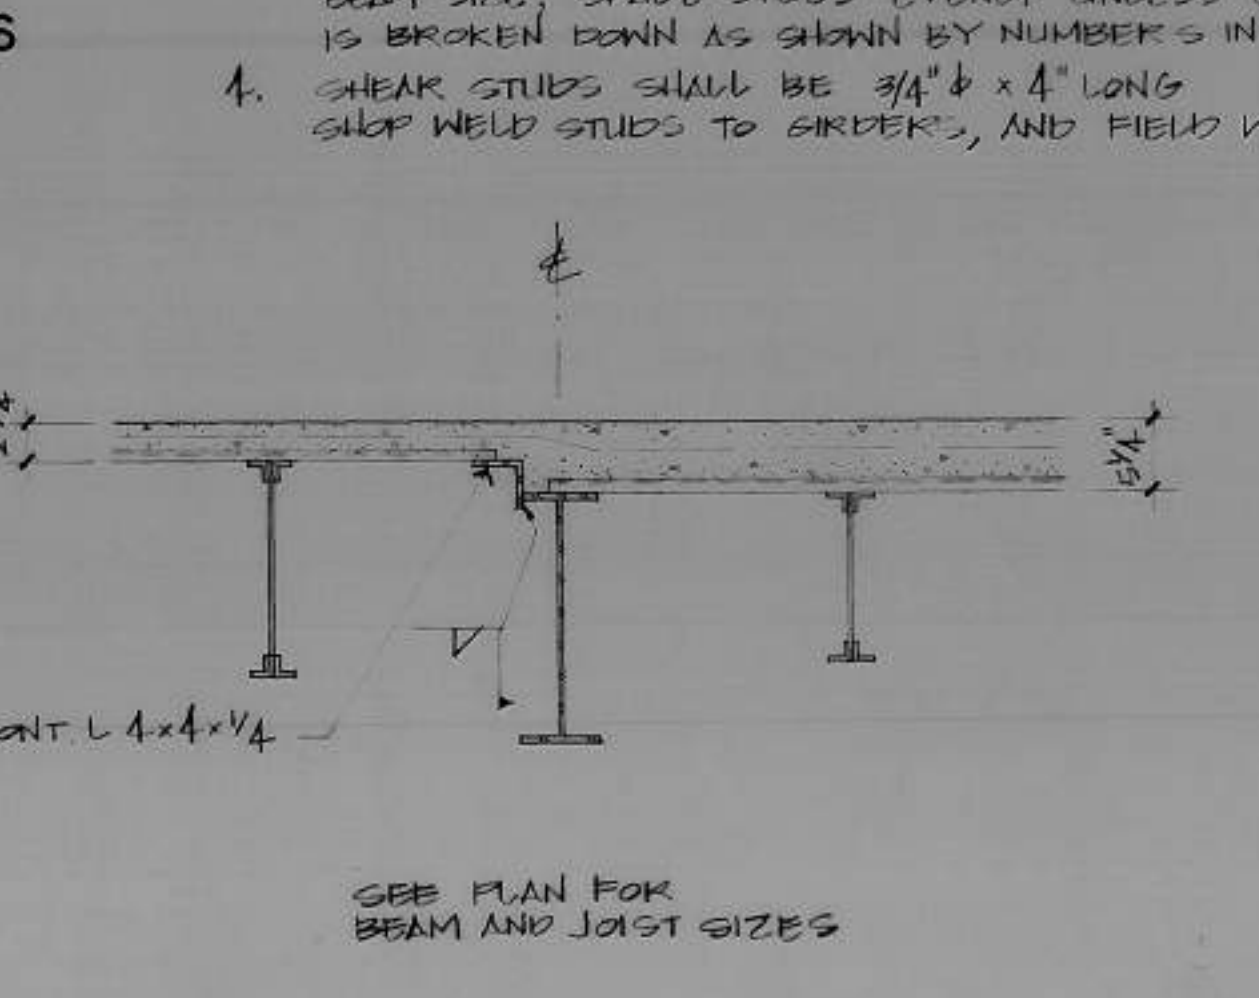

SECTION S2.14
SCALE 3/4" = 1'-0"

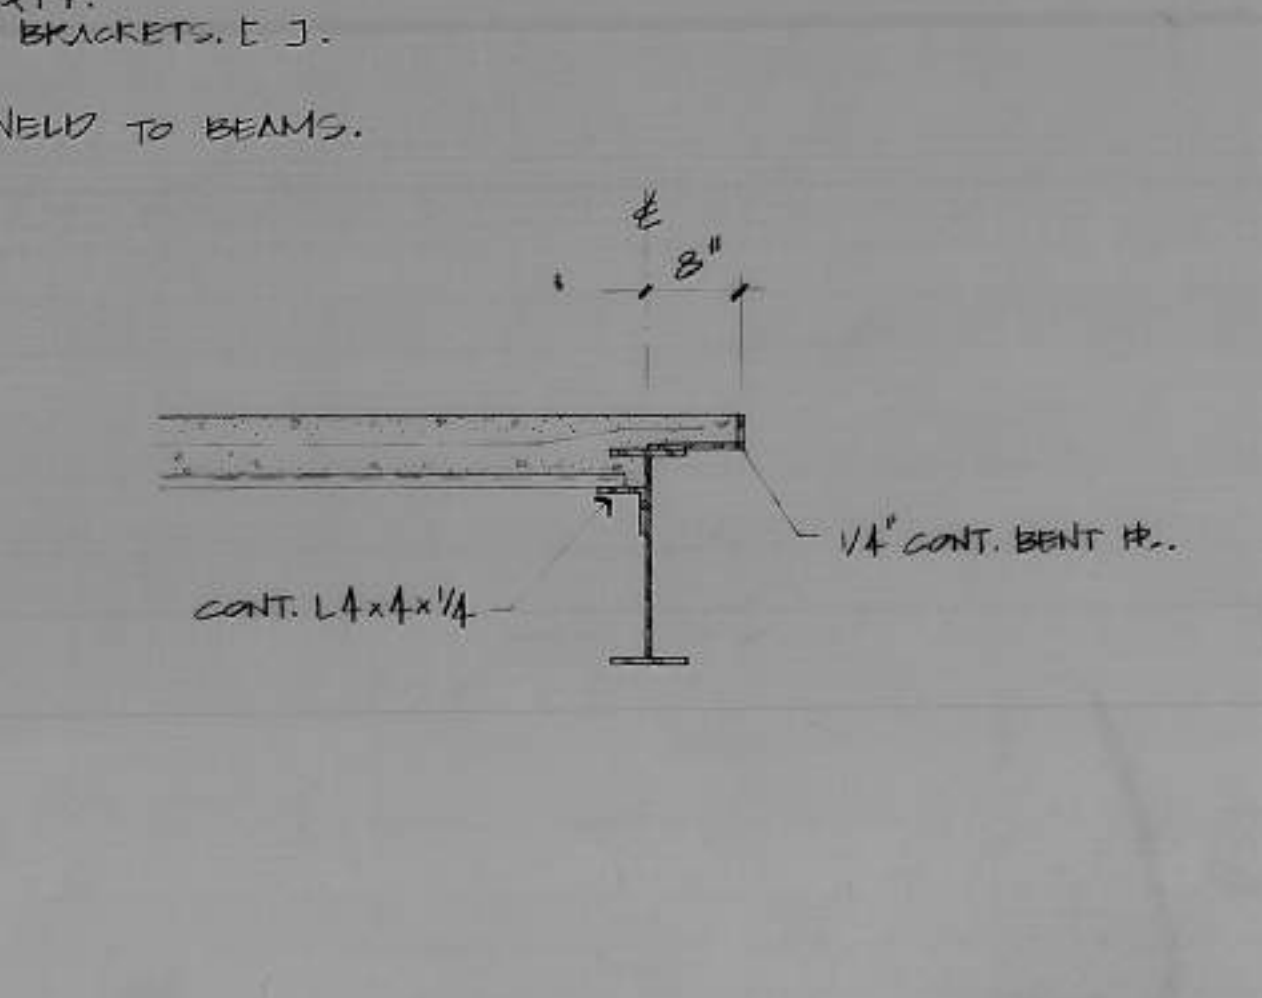

SECTION S2.15
SCALE 3/4" = 1'-0"

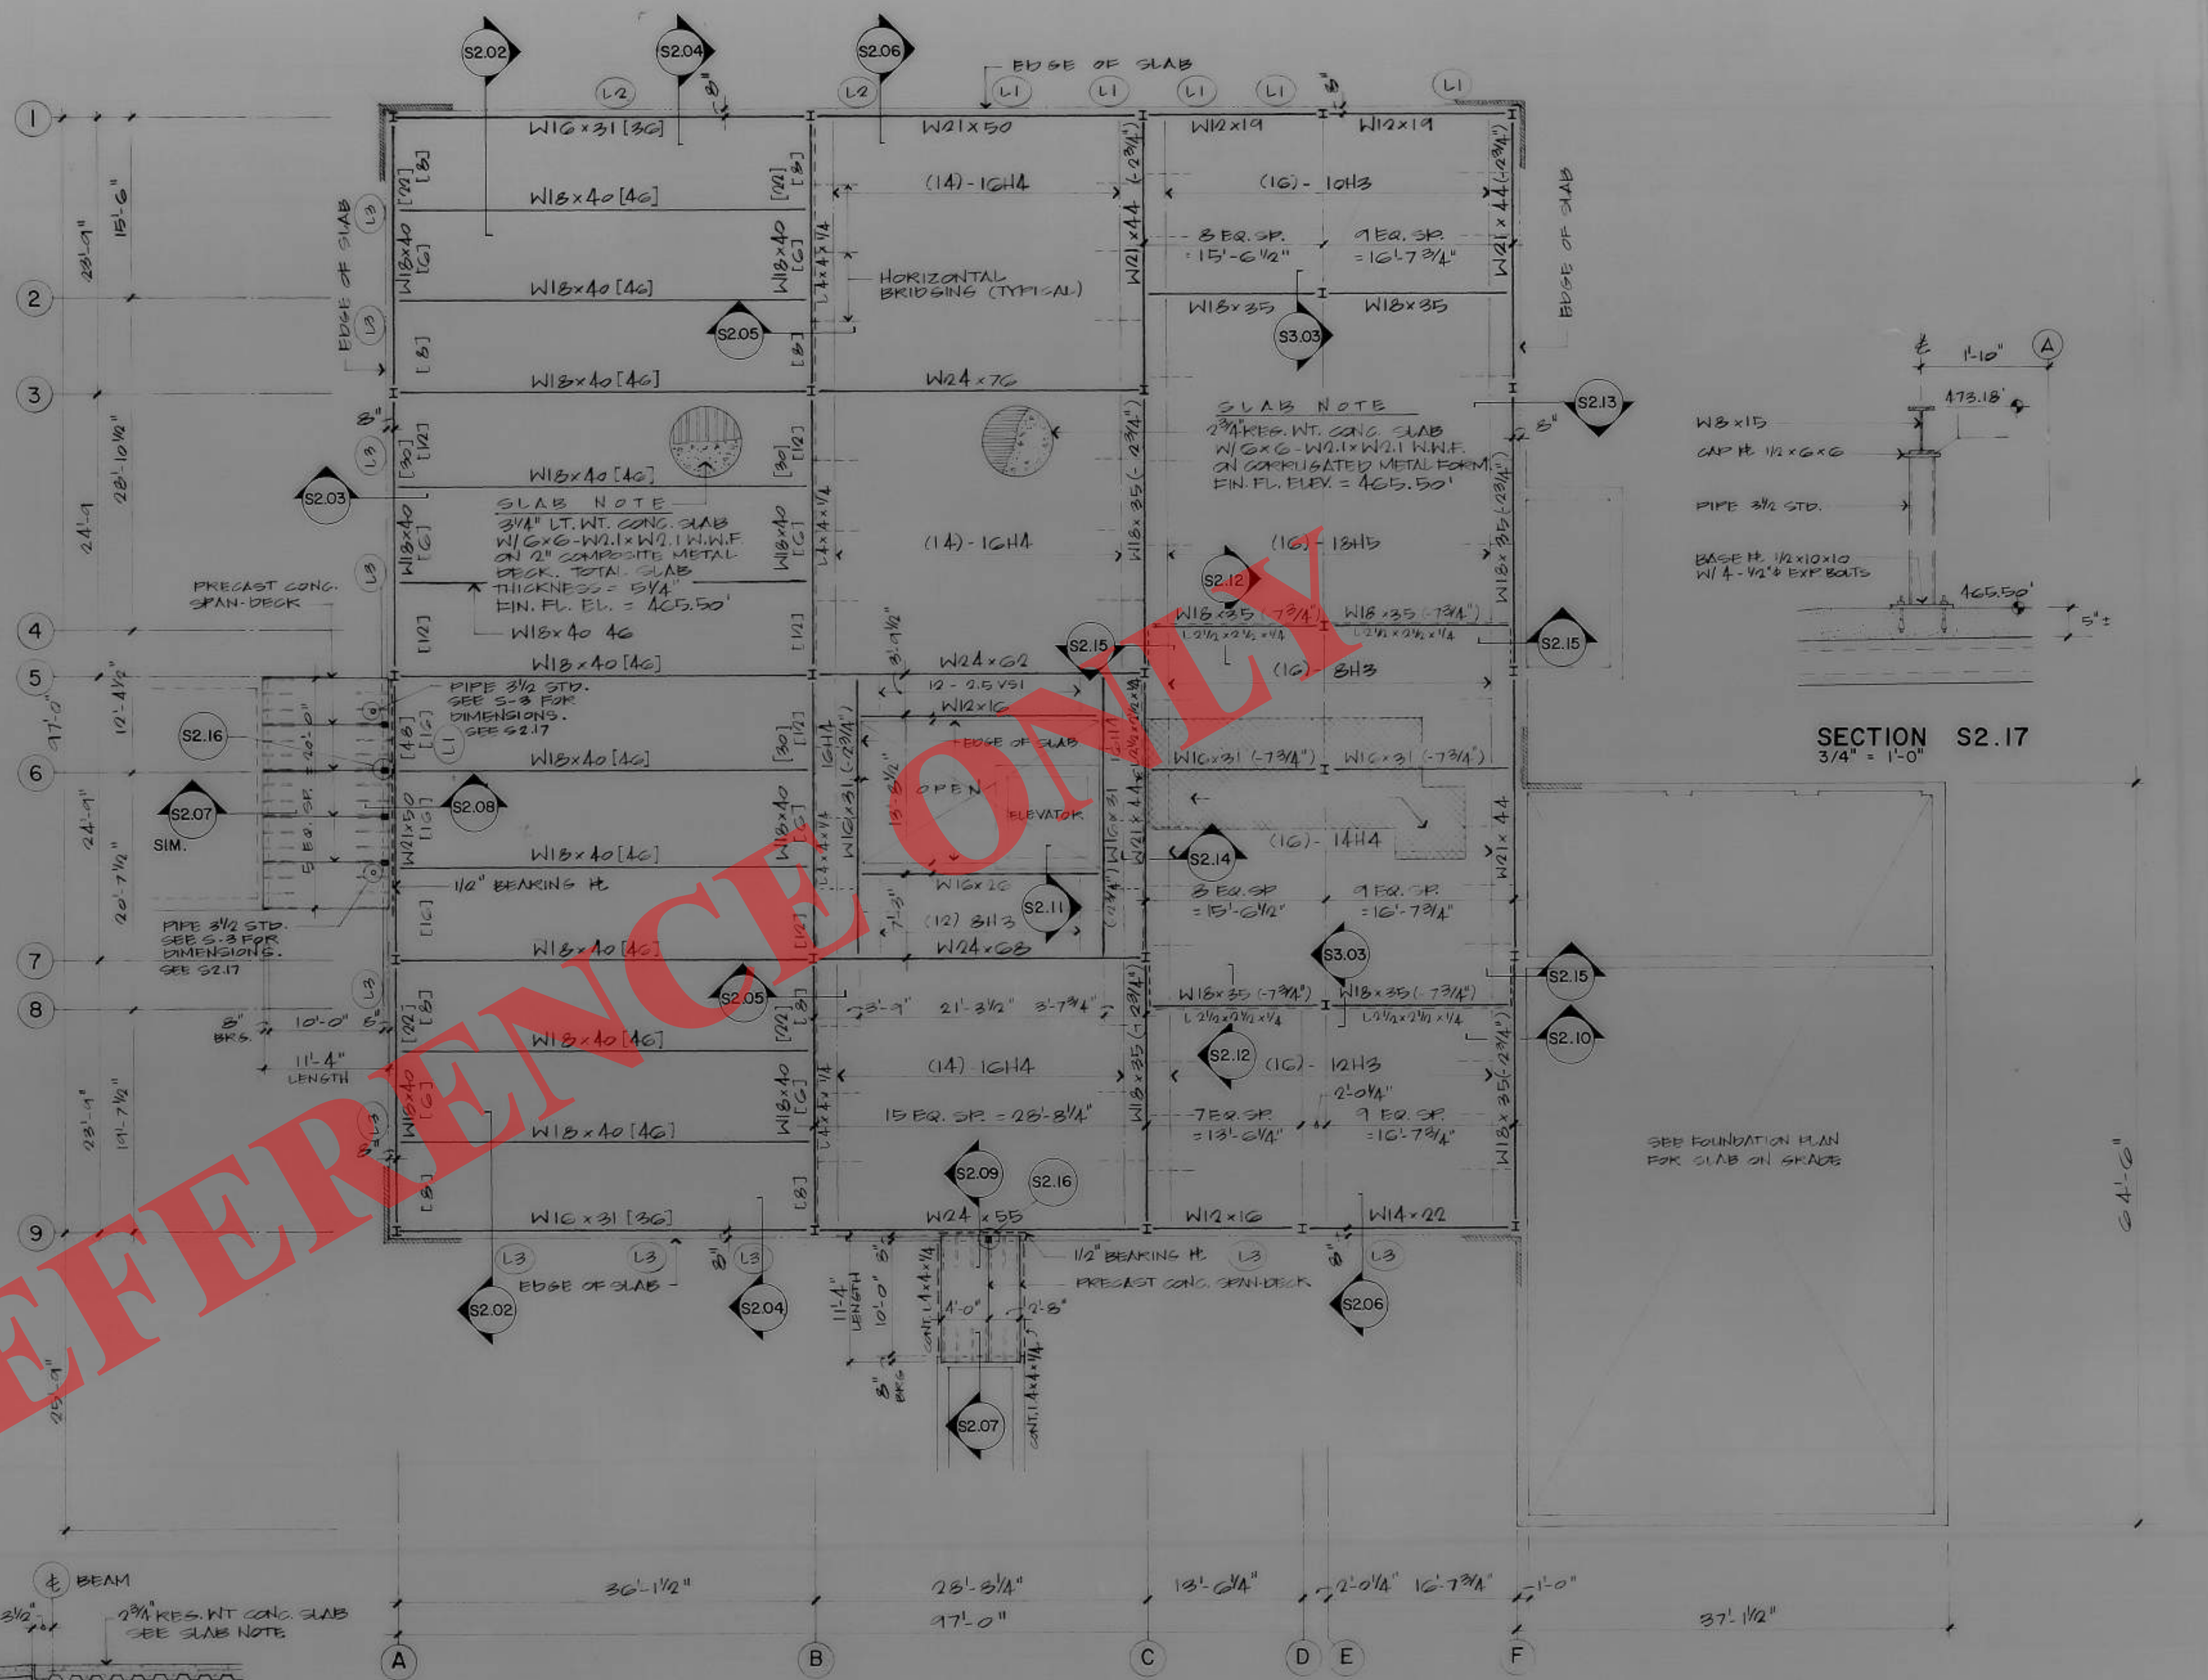

FIRST FLOOR FRAMING PLAN S2.01
SCALE 1/8" = 1'-0"








- NOTES:
- TOP OF STEEL ELEVATION = 465.00', I.E. (5 1/4") BELOW FINISHED FLOOR, UNLESS OTHERWISE NOTED IN PARENTHESES. ()
 - (L) INDICATES EXTERIOR LINTEL OVER WINDOW OR DOOR, SEE SB FOR SCHEDULE.
 - TOTAL NUMBER OF SHEAR STUDS ARE SHOWN AFTER BEAM SIZE, SPACE STUDS EVENLY UNLESS QTY. IS BROKEN DOWN AS SHOWN BY NUMBERS IN BRACKETS, E.J.
 - SHEAR STUDS SHALL BE 3/4" x 4" LONG SLIP WELD STUDS TO GIRDERS, AND FIELD WELD TO BEAMS.

L. SATER, HOPKINS ENGINEERS
 Raleigh, N.C.
 city planning and architectural associates
 planners
 architects
 chapel hill, n.c.
 919/752/1114

O.W.A.S.A. OPERATIONS CENTER
 CARBORO, NORTH CAROLINA
FLOOR FRAMING PLAN & DETAILS

date: DECEMBER, 1988
 drawn by: K.S.K.
 checked by: K.E.L.

sheet no.
S2

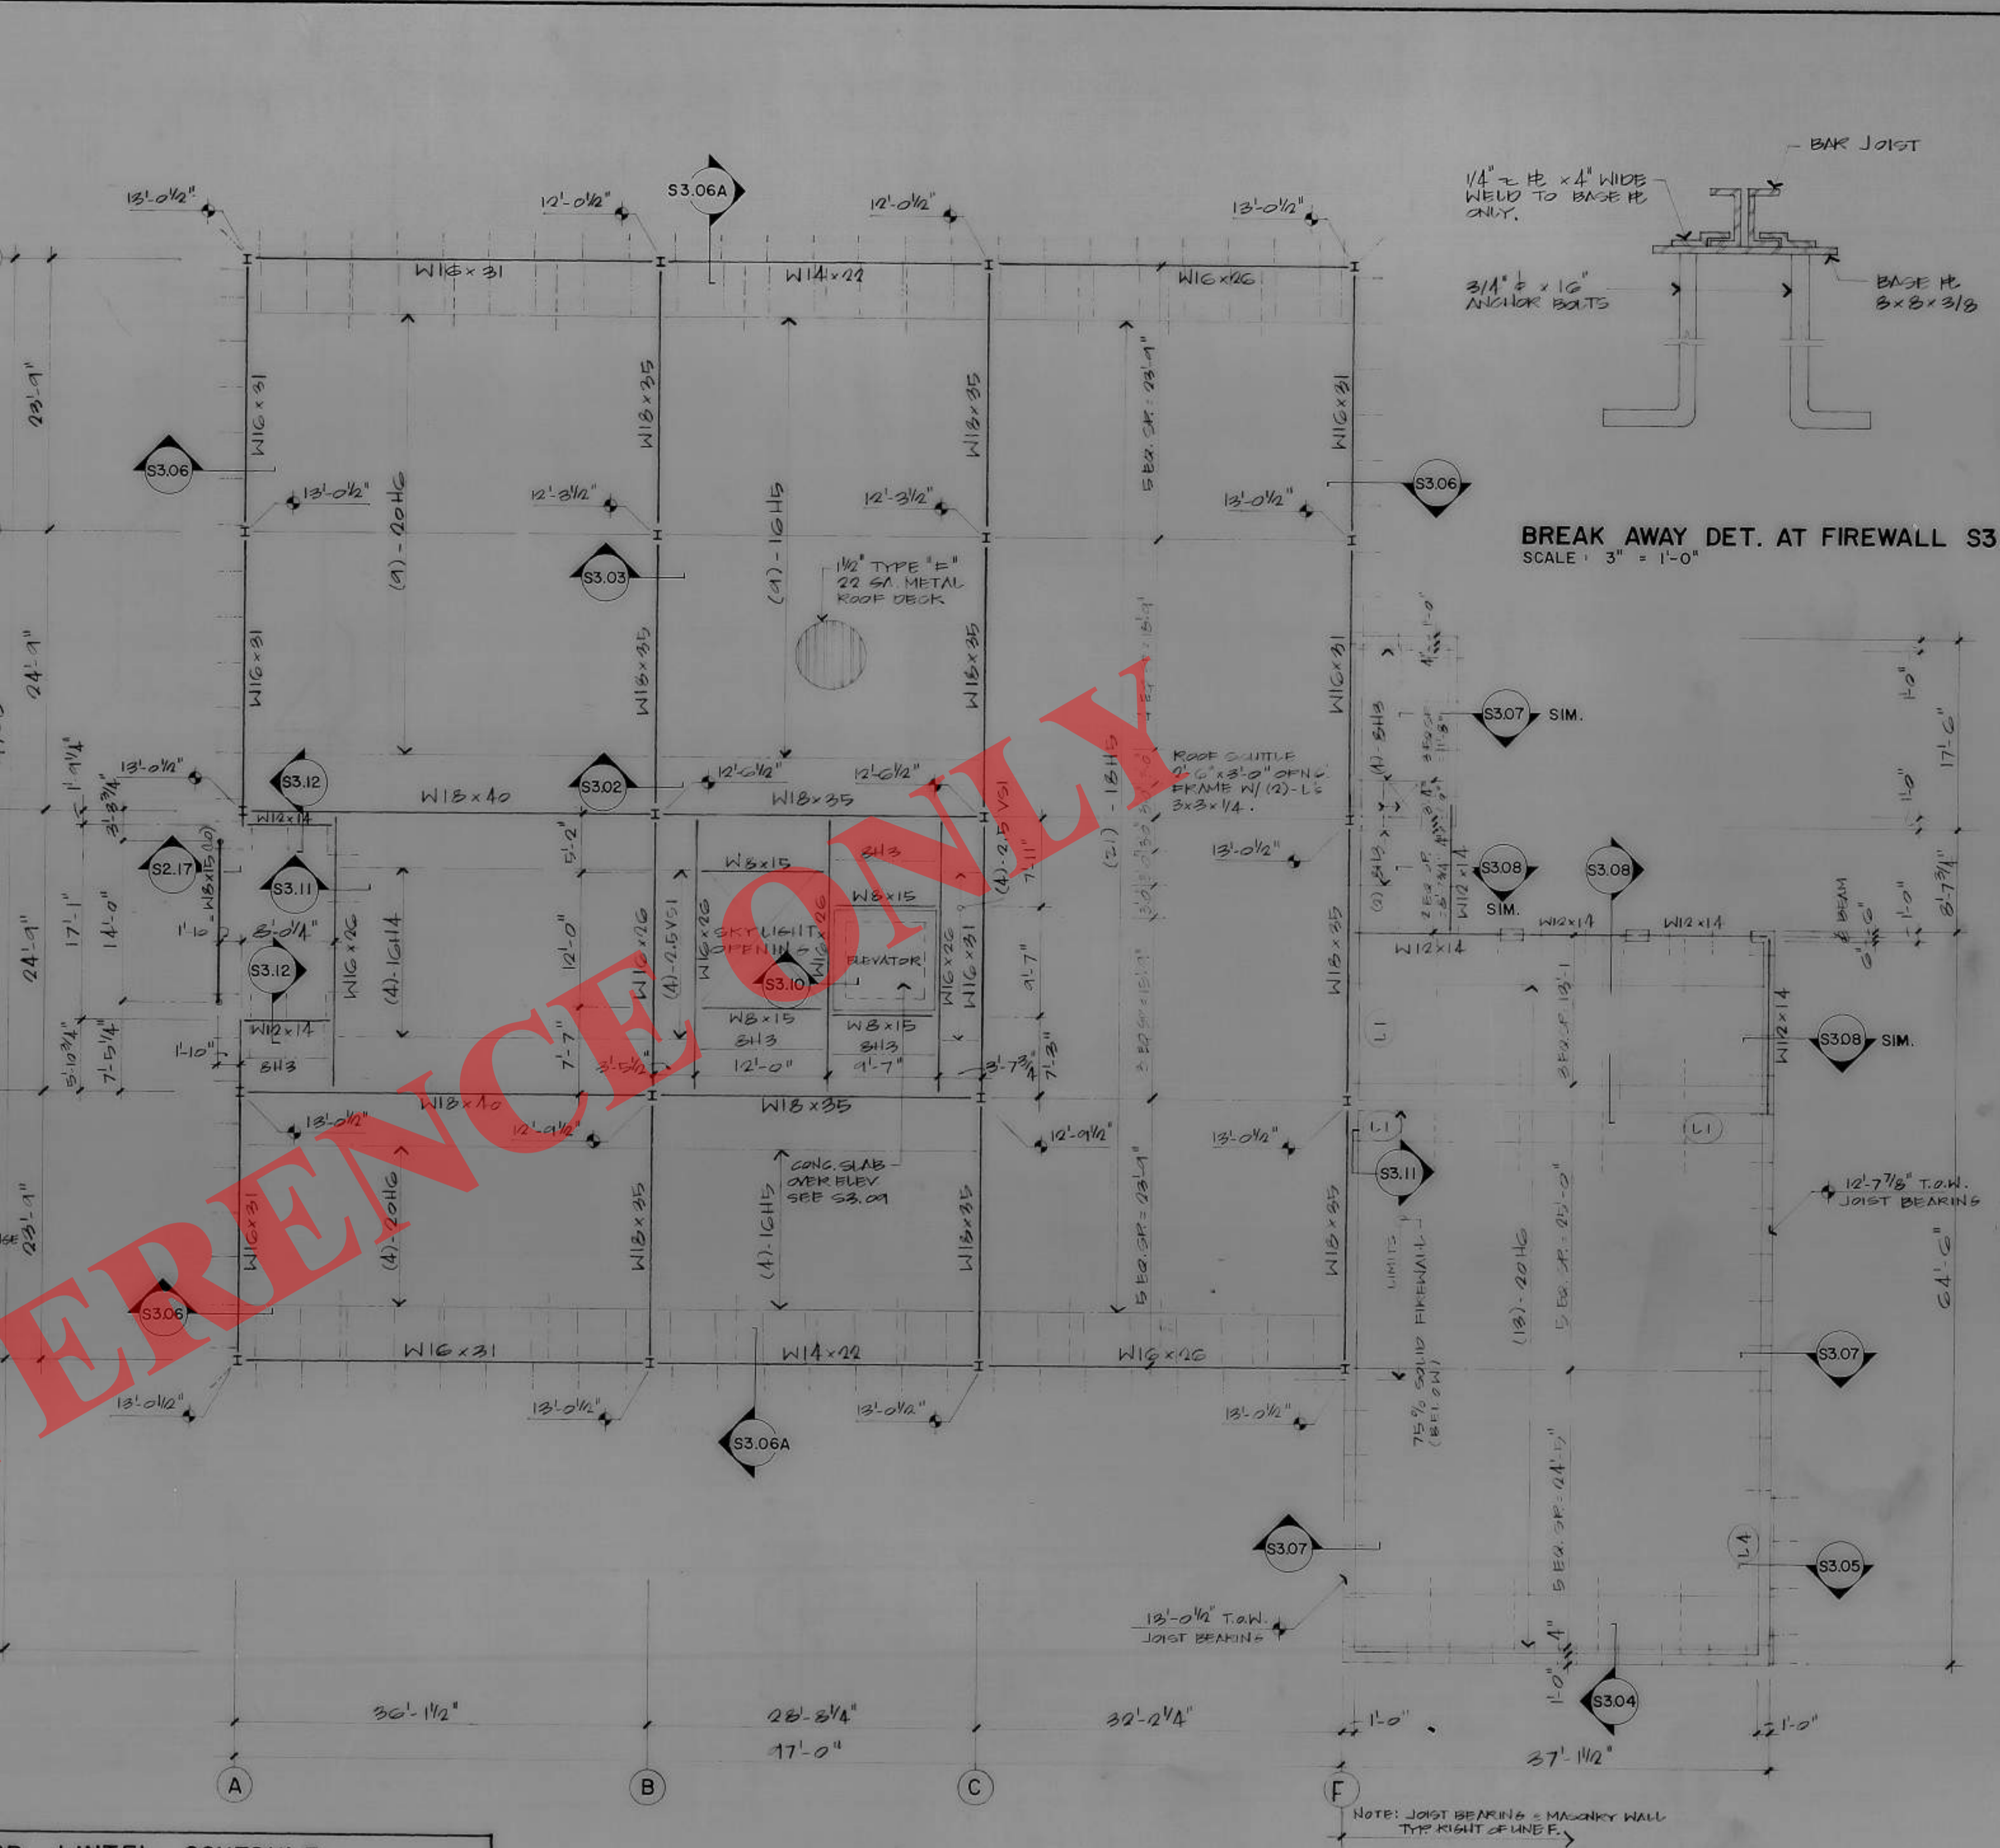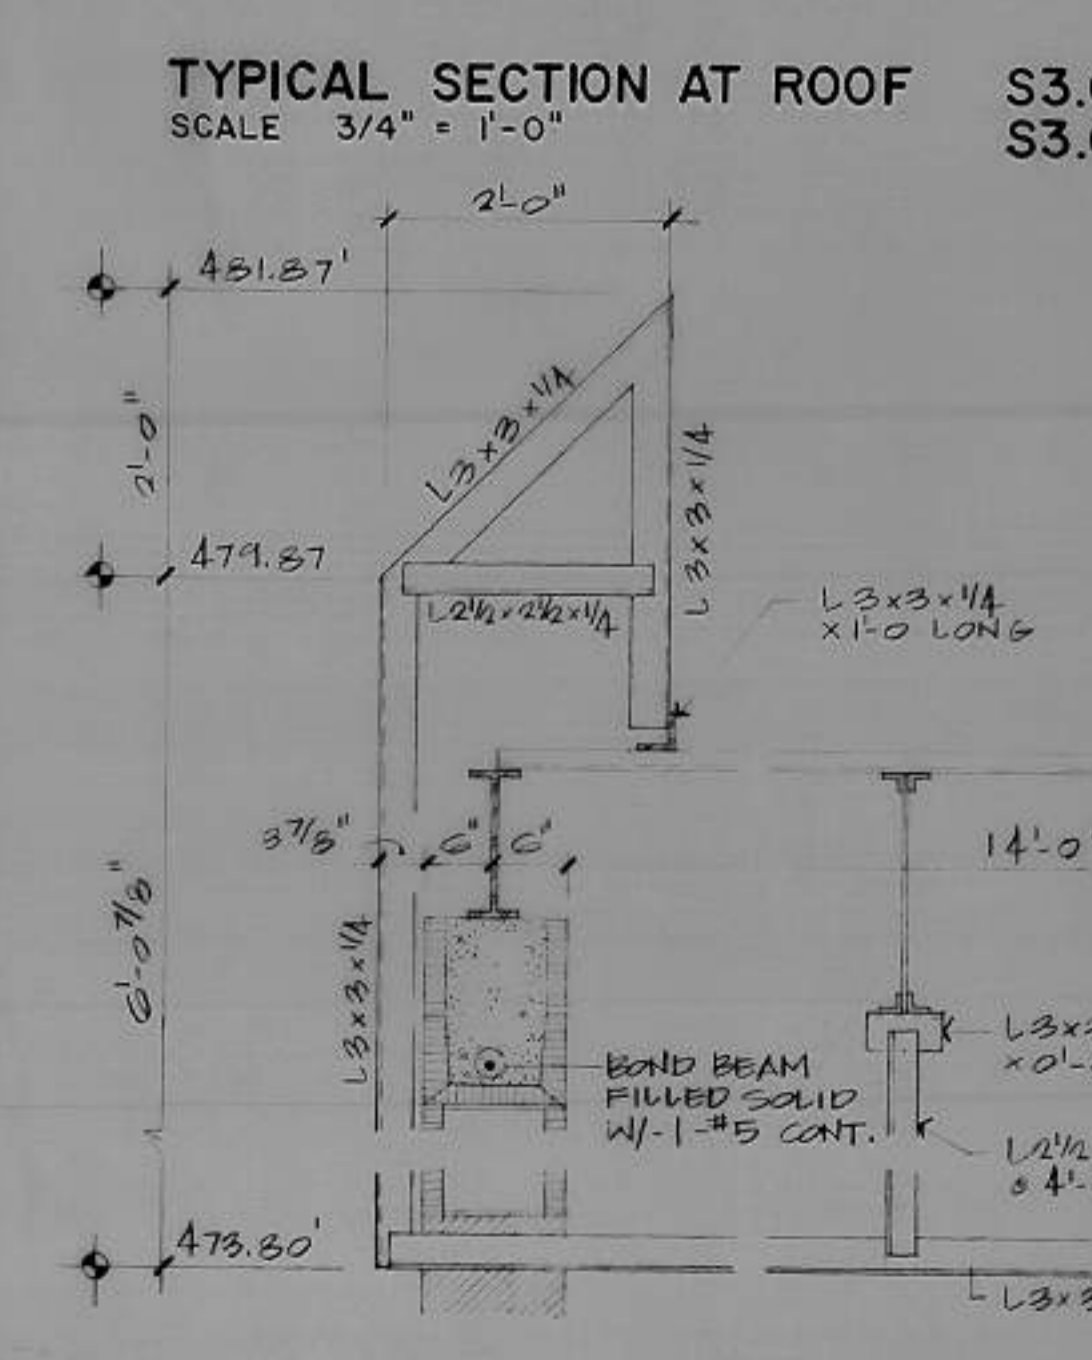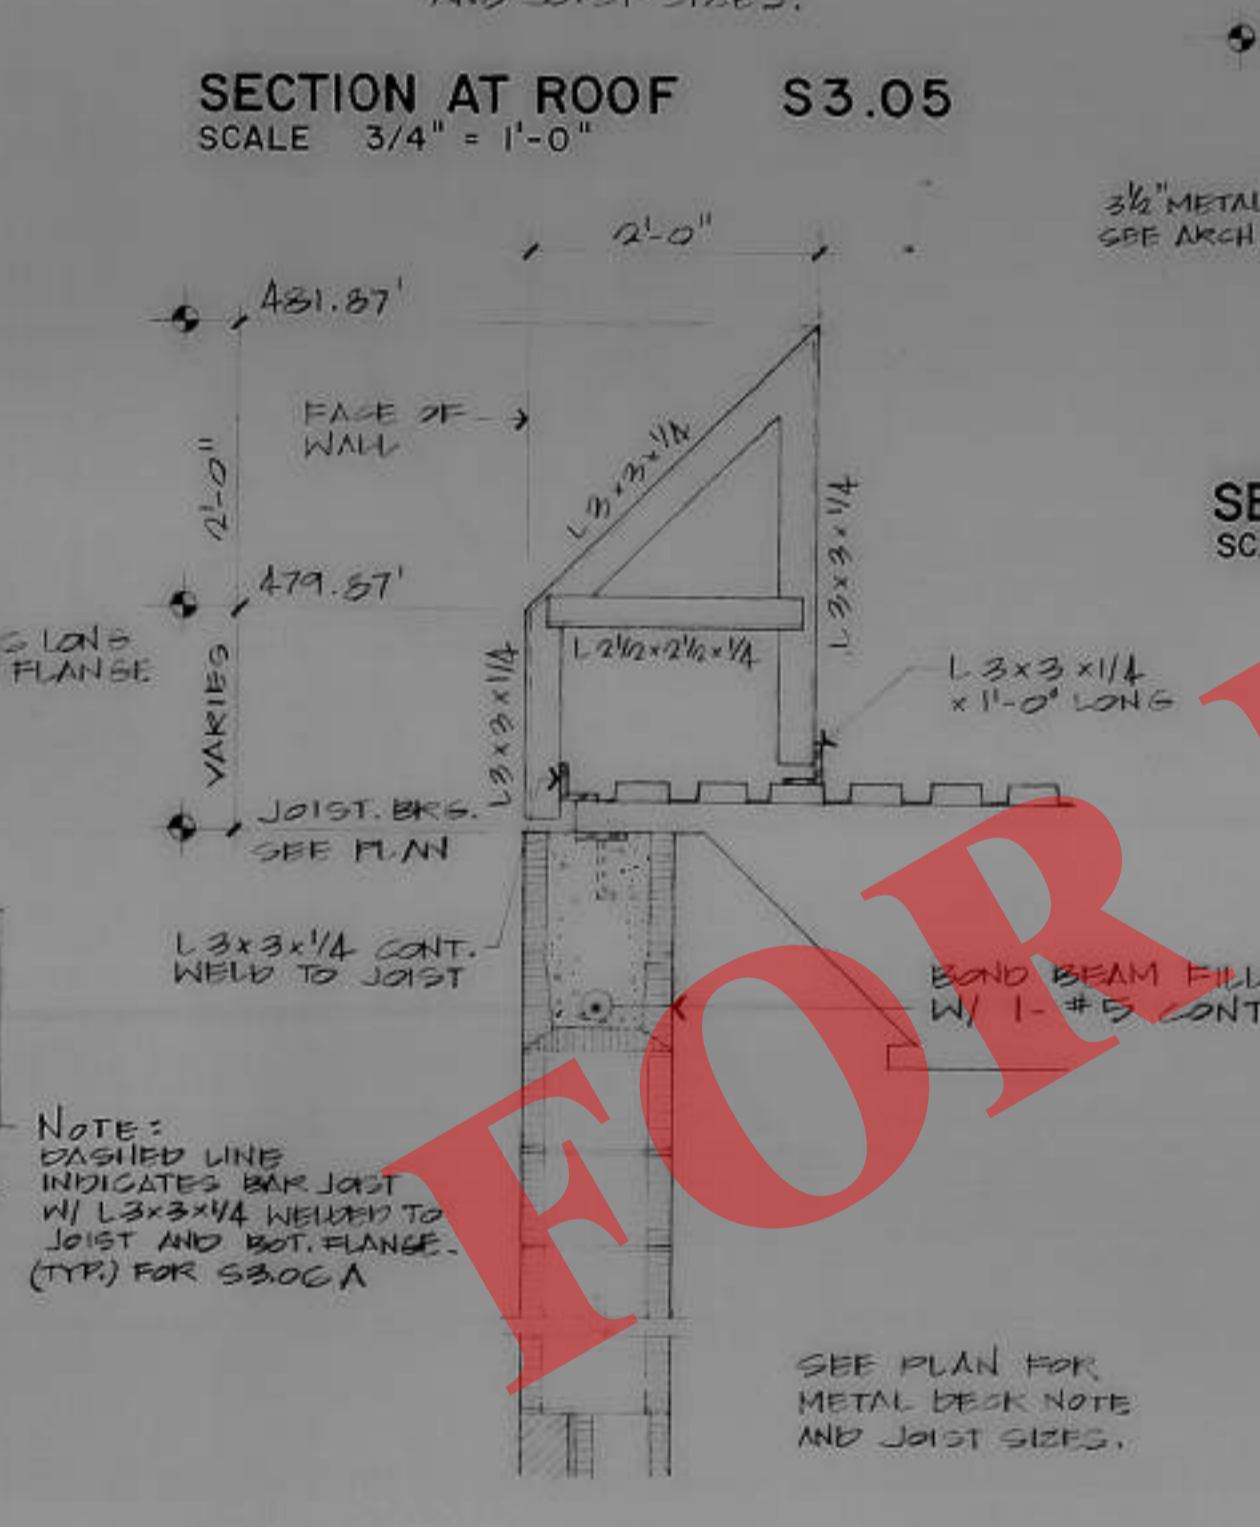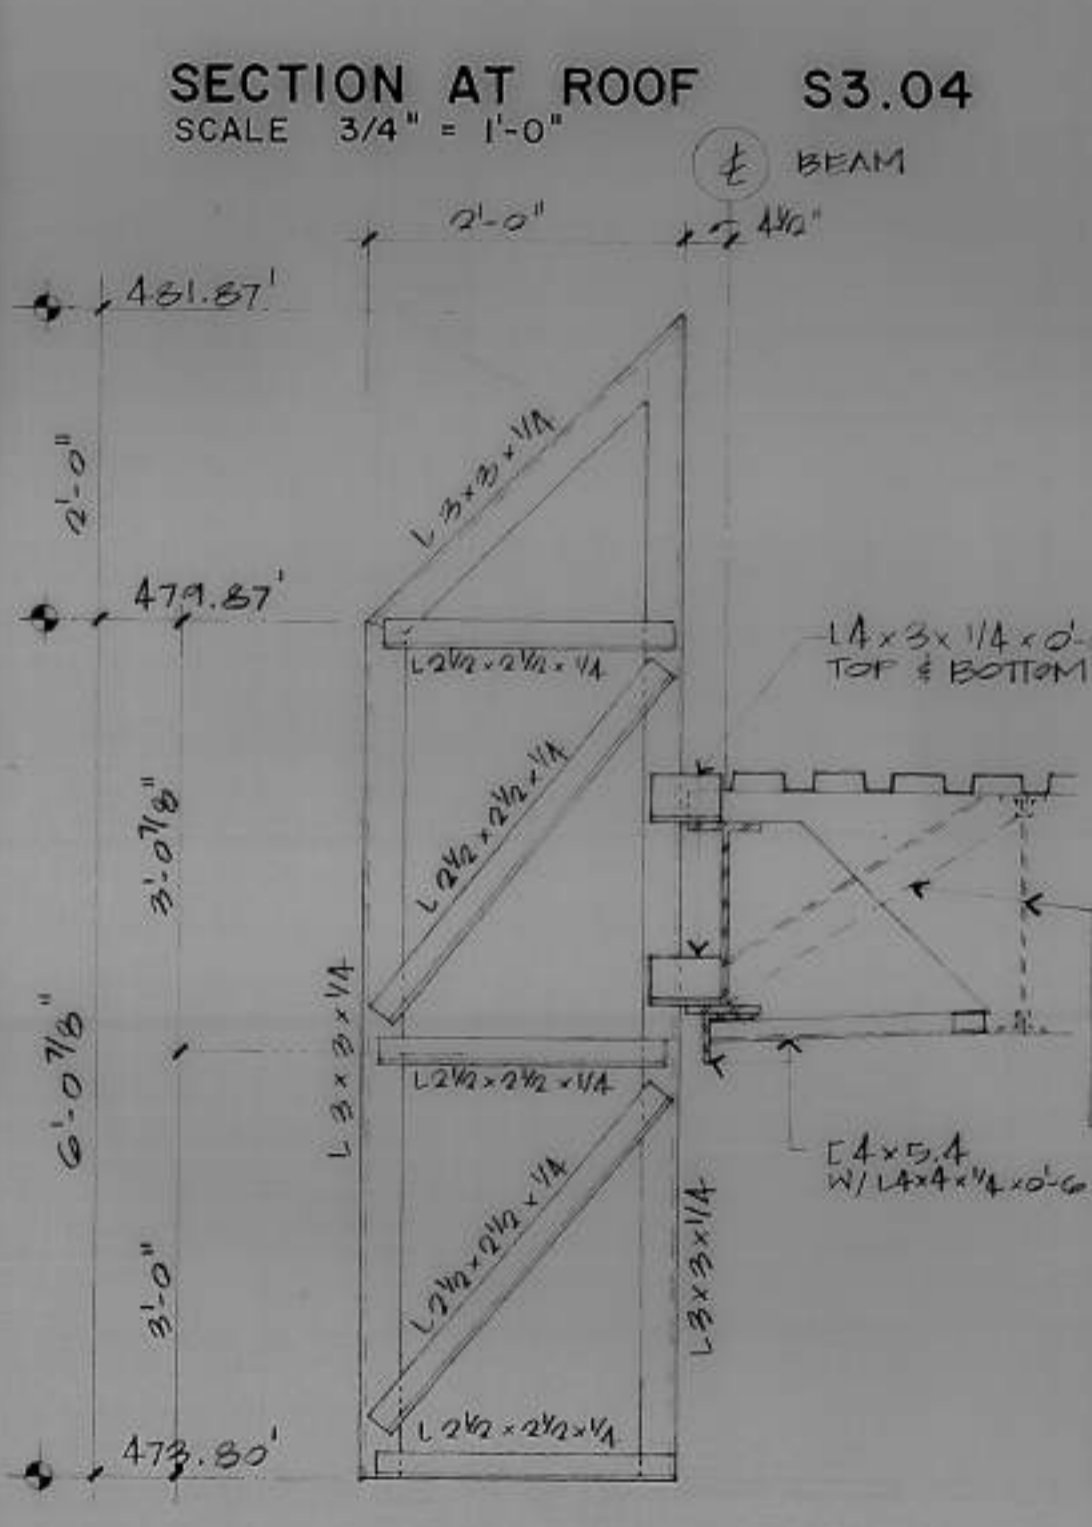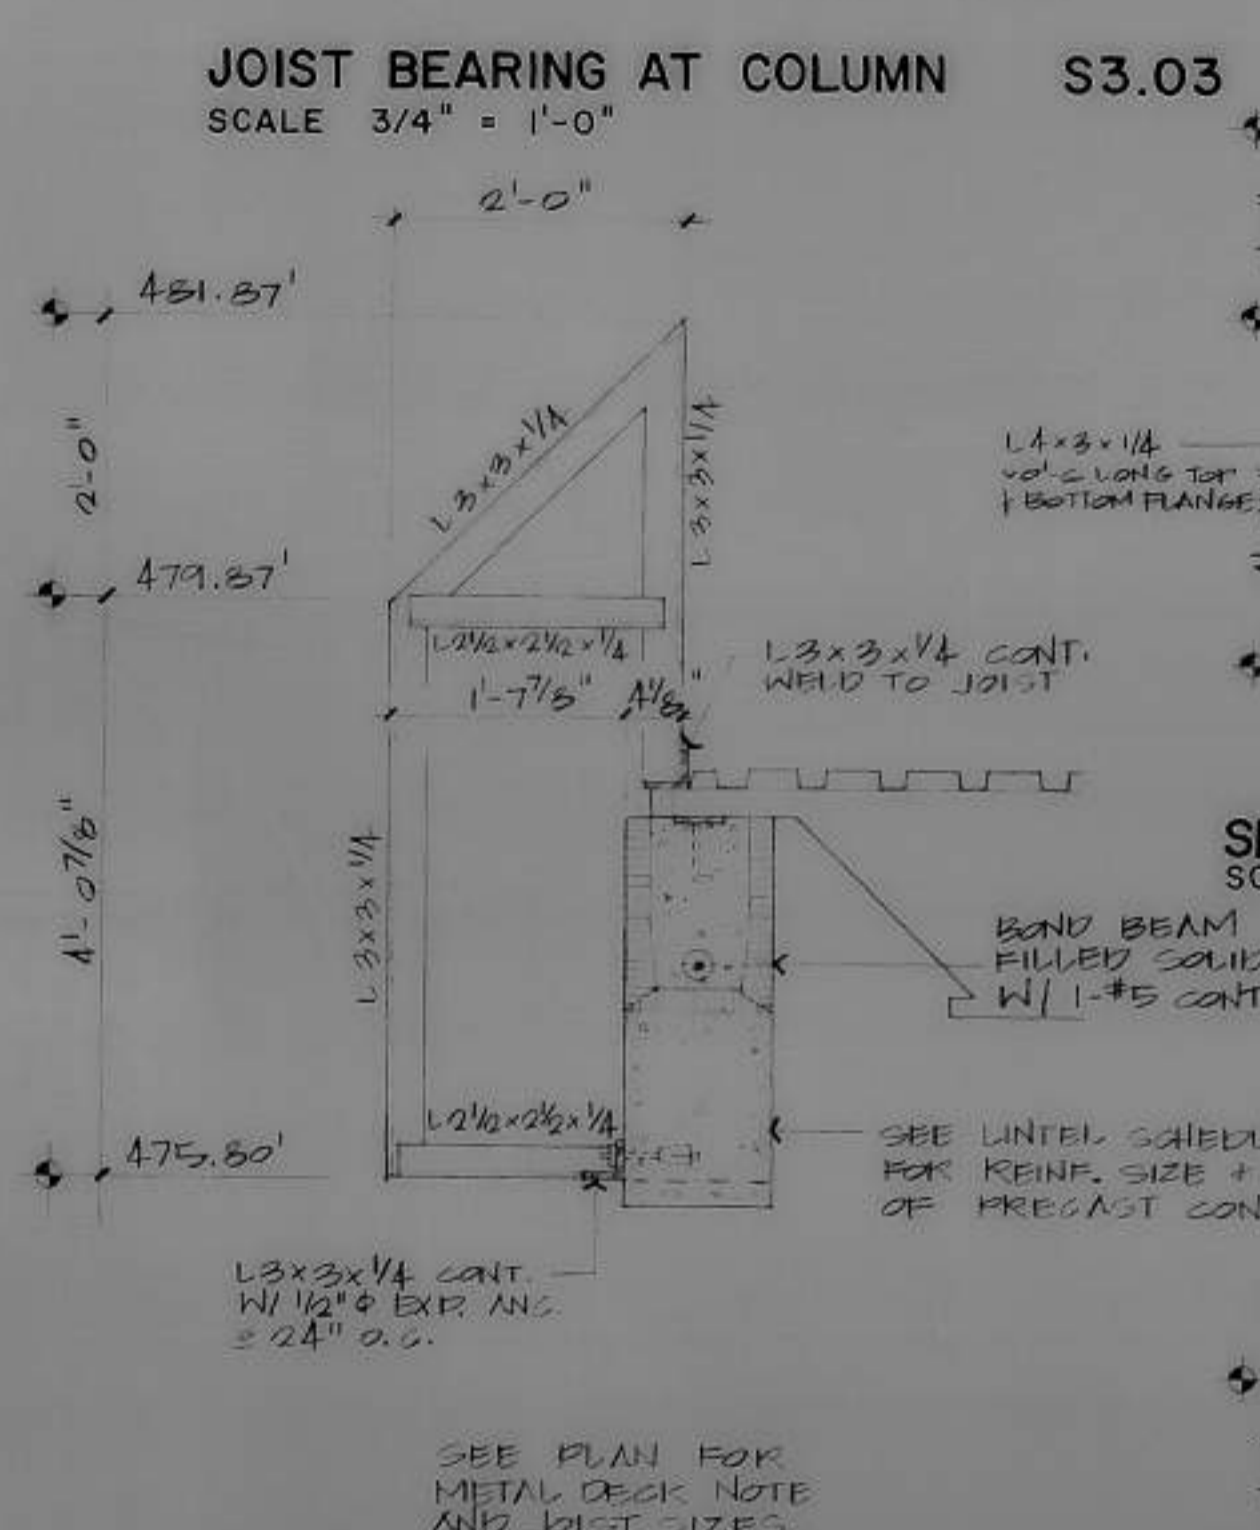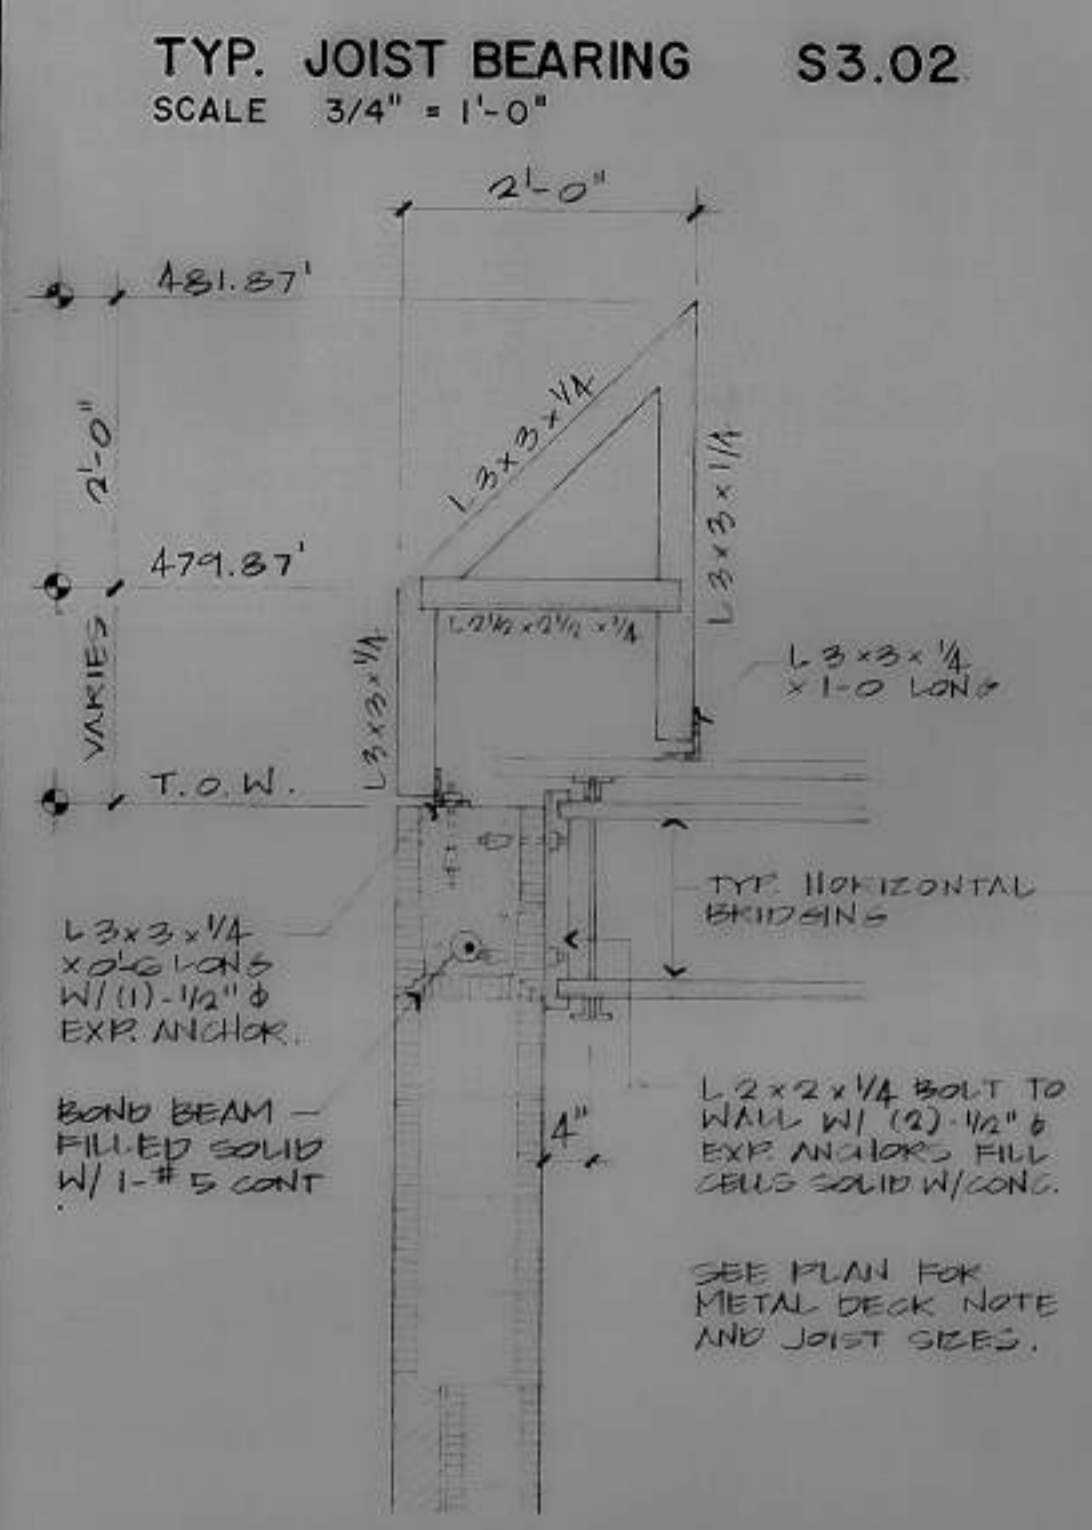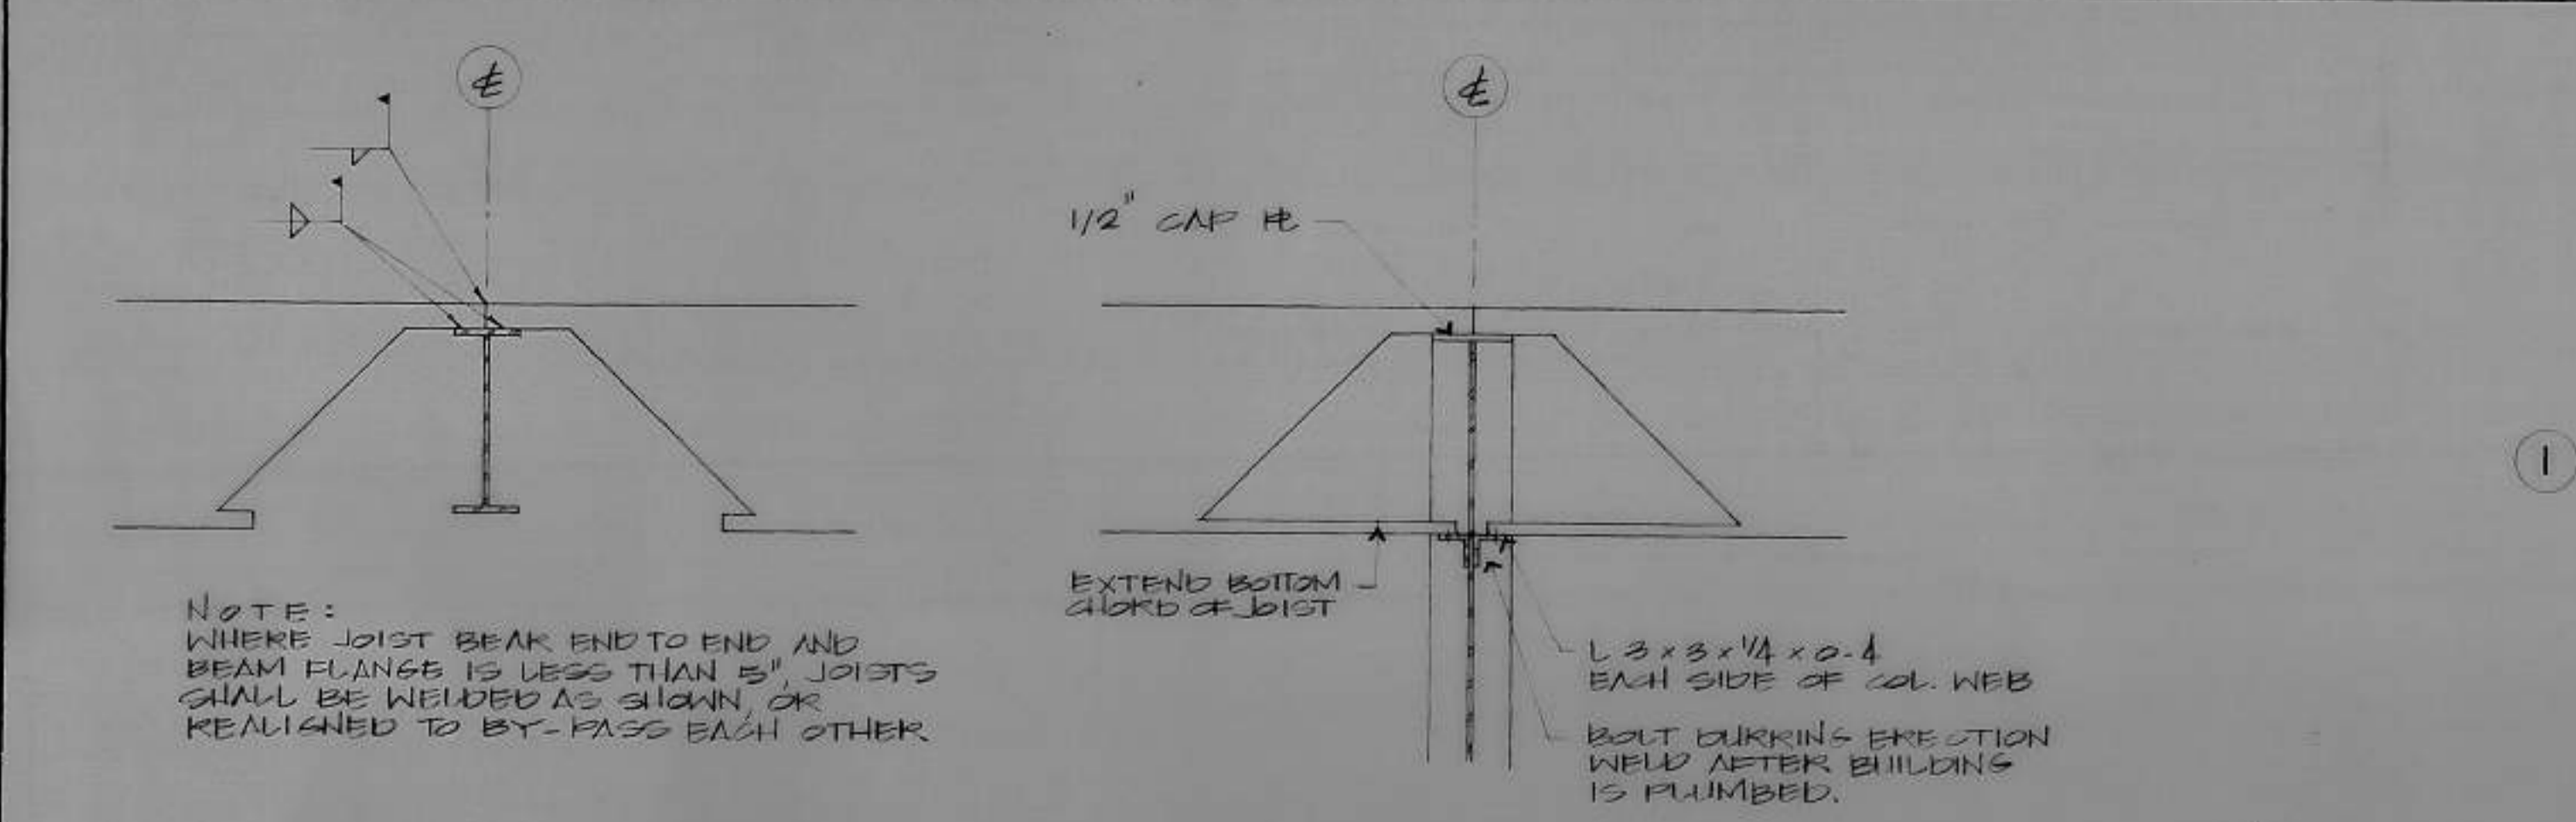


EXTERIOR LINTEL SCHEDULE

MARK	LINTEL TYPE	LINTEL SIZE	LINTEL REIN.	SECTION	BEARING EA. END	REMARKS
(L1)	STEEL U-BLOCK	L4x3x1/4 8x8	2-#5 BOT.	[Diagram]	8"	
(L2)	STEEL U-BLOCK	L6x3 1/2 x 3/8 8x8	2-#5 BOT.	[Diagram]	8"	
(L3)	STEEL U-BLOCK	L6x3 1/2 x 3/8 8x8	2-#6 BOT.	[Diagram]	8"	
(L4)	STEEL PRECAST	L6x3 1/2 x 3/8 3x8	2-#6 BOT.	[Diagram]	8"	

NOTE: ALL BLOCK SIZES GIVEN ARE NOMINAL.

INTERIOR LINTEL SCHEDULE

WALL THICKNESS	OPENING WIDTH	LINTEL TYPE	LINTEL SIZE	LINTEL REIN.	BEARING EA. END	REMARKS
8"	≤ 4'-0"	U-BLOCK	8x8	2-#5 BOT.	8"	
12"	≤ 4'-0"	U-BLOCK	12x8	2-#5 BOT.	8"	
12"	≤ 10'-0"	PRECAST	12x8	2-#6 BOT.	8"	

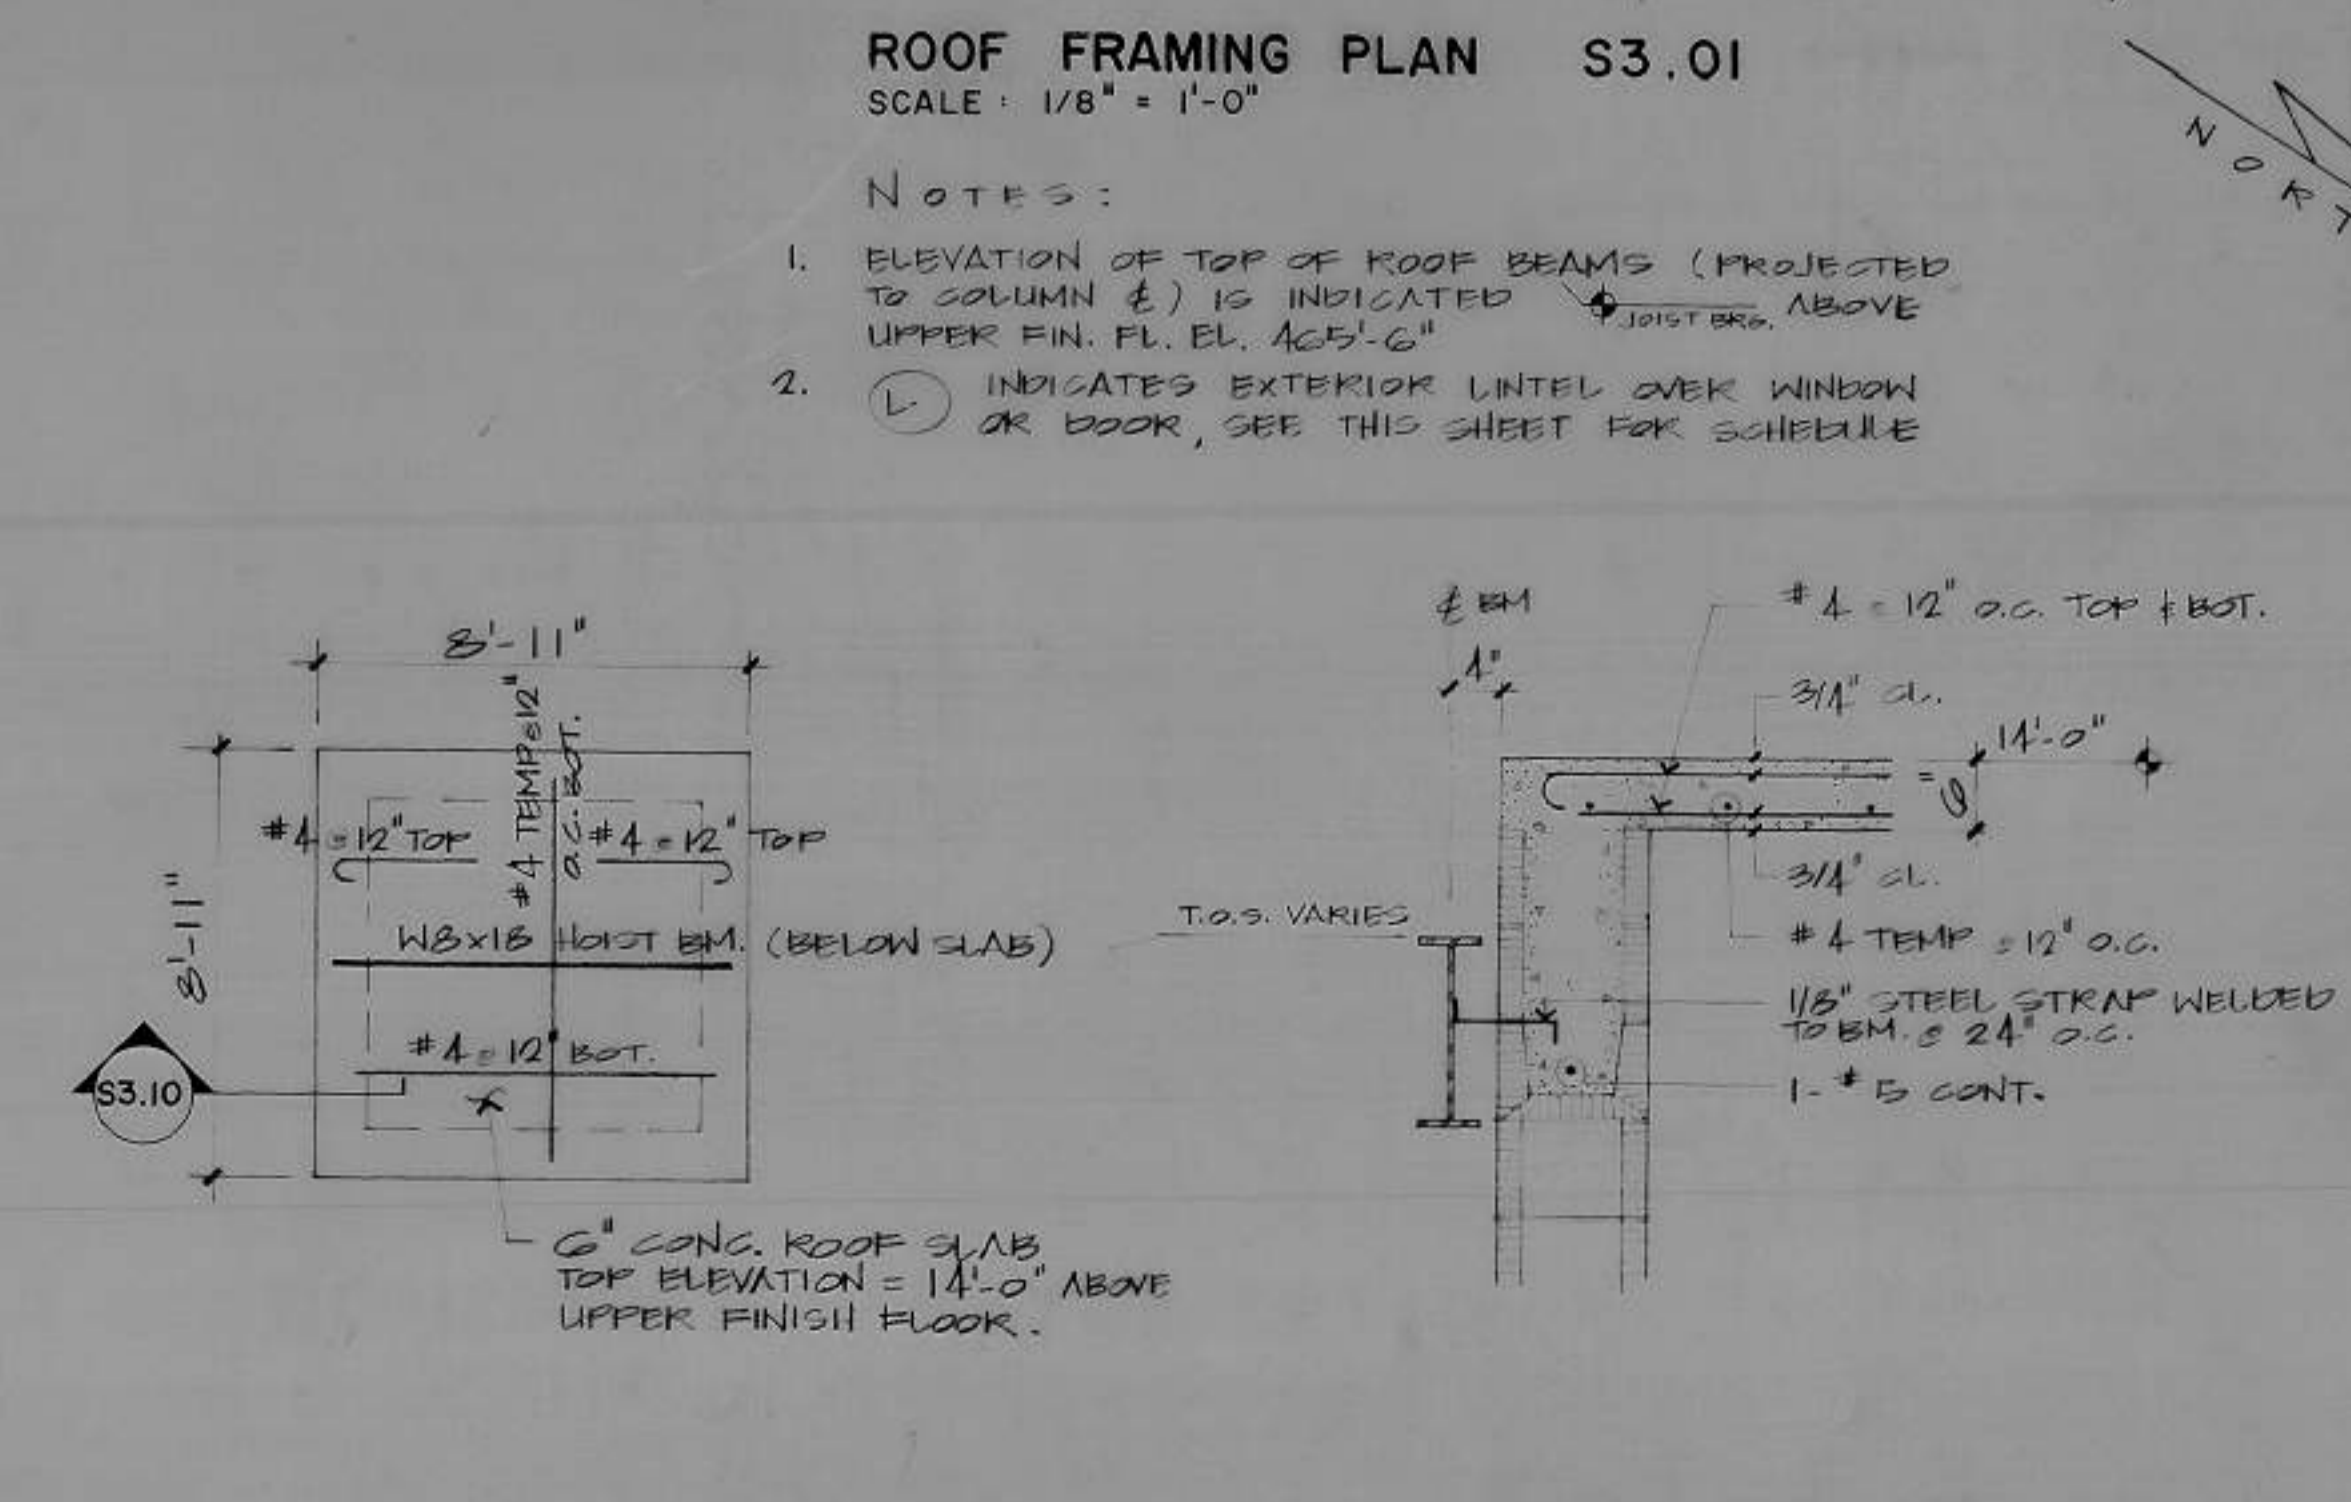

LASATER HOPKINS ENGINEERS
 Raleigh, NC
 city planning and architectural associates
 planners
 architects
 chapman hill, n.c.
 919.999.1944

O.W.A.S.A. OPERATIONS CENTER
 CARBORO NORTH CAROLINA

ROOF FRAMING PLAN & DETAILS

date: DECEMBER, 1988
 drawn by: R.S.K.
 checked by: K.E.L.

sheet no.
S3

AS BUILT 8/17/90