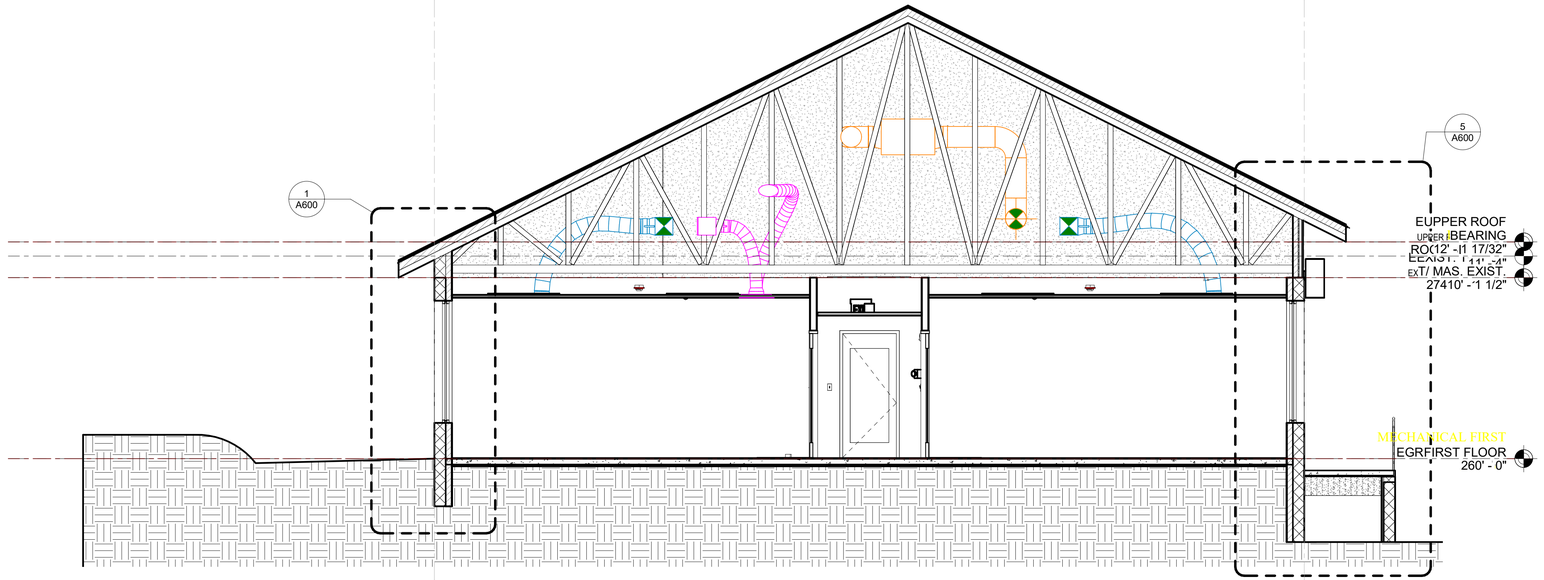

EAST/WEST BUILDING SECTION
1/4" = 1'-0"
2

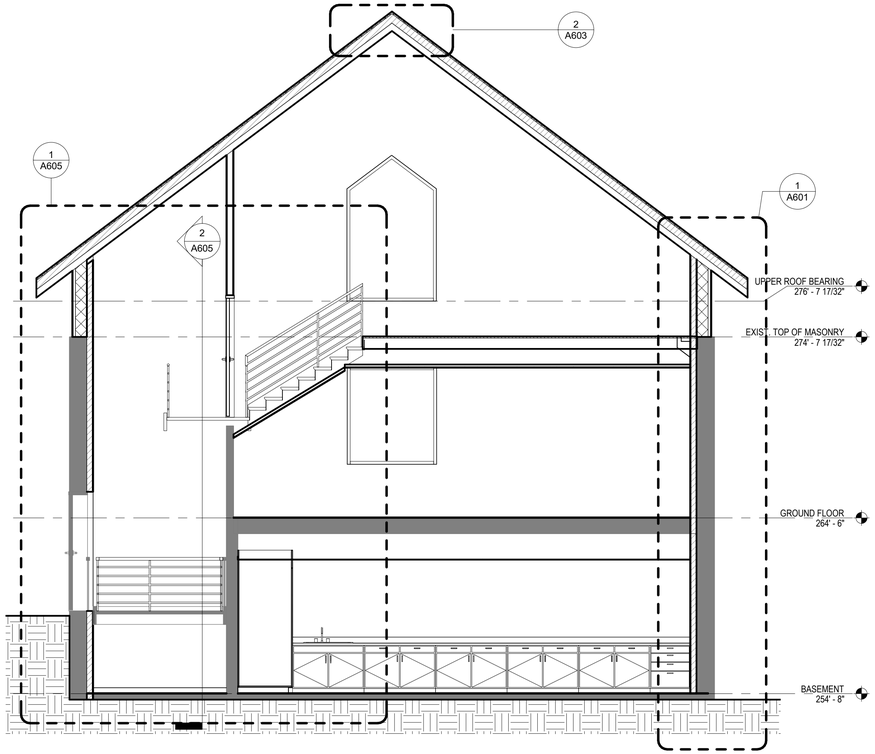

NORTH EAST BUILDING SECTION
1/4" = 1'-0"
3

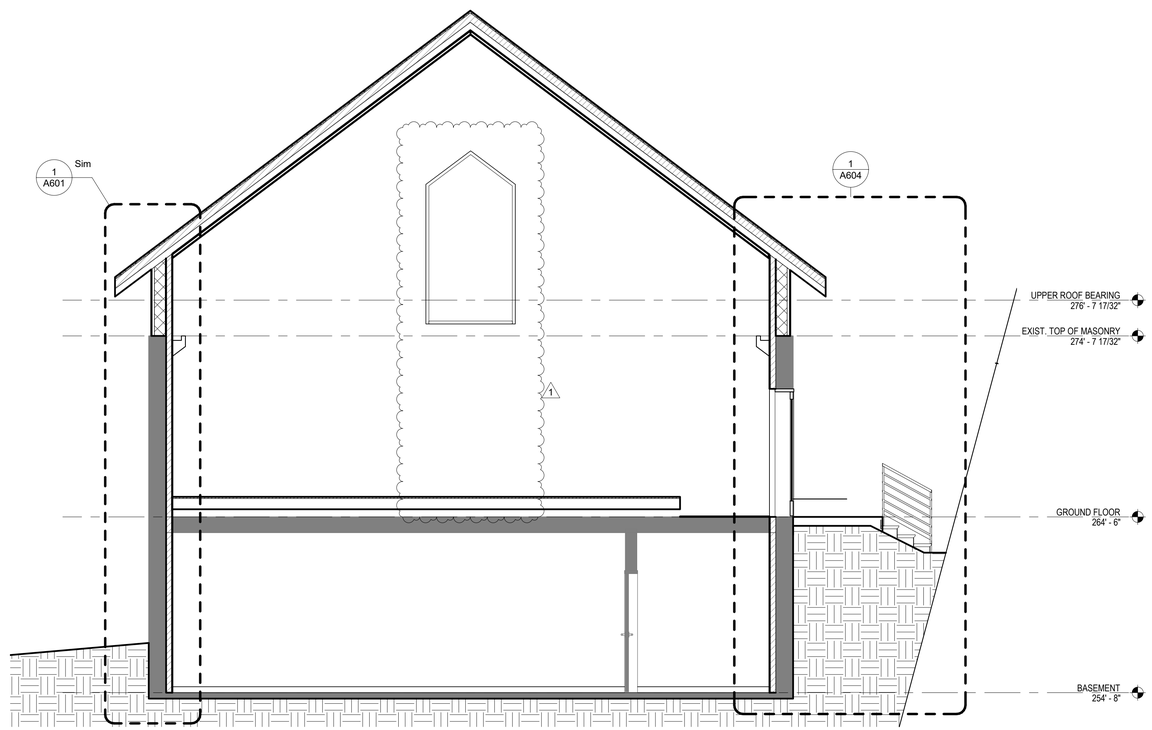

SOUTH WEST BUILDING SECTION
1/4" = 1'-0"
4

Architect:

WAKE
ARCHITECTURE + ENGINEERING

www.wakeae.com

Wake AE, PLLC.
918 Minerva Dale Drive
Fuquay Varina, NC 27526
704.778.6608

Plans, maps, specifications, studies, and reports not containing a red ink seal imprint accompanied by an original signature by the licensed professional may have been fraudulently altered and shall not be considered an original copy. All information should be disregarded unless verified by the professional whose signature appears below. Copyright Protected 2021.

Project Owner:

PILGRIM ORTHODOX PRESBYTERIAN CHURCH
5420 Ebenezer Church Road
Raleigh NC

Stamp:

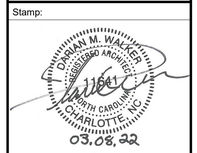

Issue For:
BID & CONSTRUCTION

Issue Date:
03.08.2022

REVISIONS

NO.	REASON	DATE
1	Bidder Questions	06.24.2022

PRINCIPAL IN CHARGE:
D. WALKER

Project Address:
PILGRIM ORTHODOX PRESBYTERIAN CHURCH

5420 Ebenezer Church, Raleigh NC

Project Number:
202107

Sheet Title:
BUILDING SECTIONS

Sheet Number:
A300